
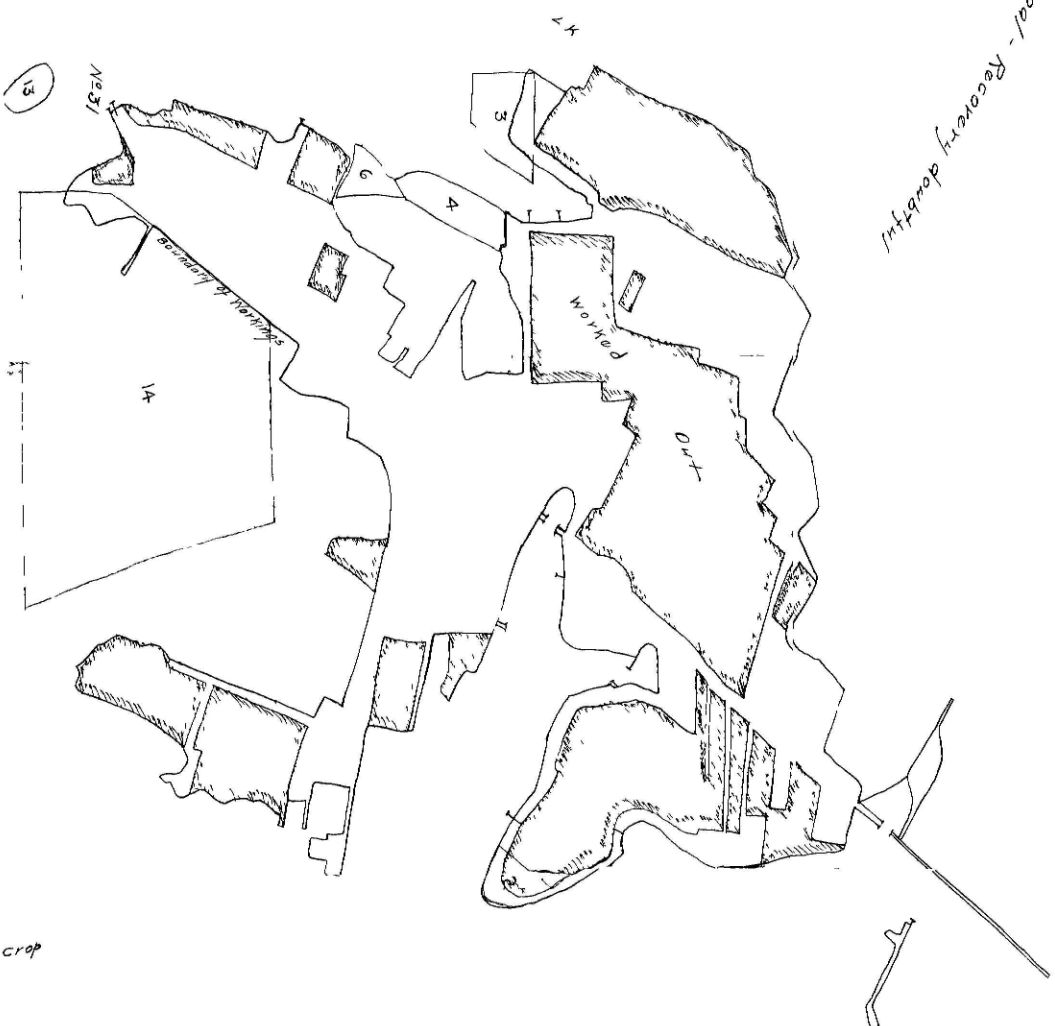


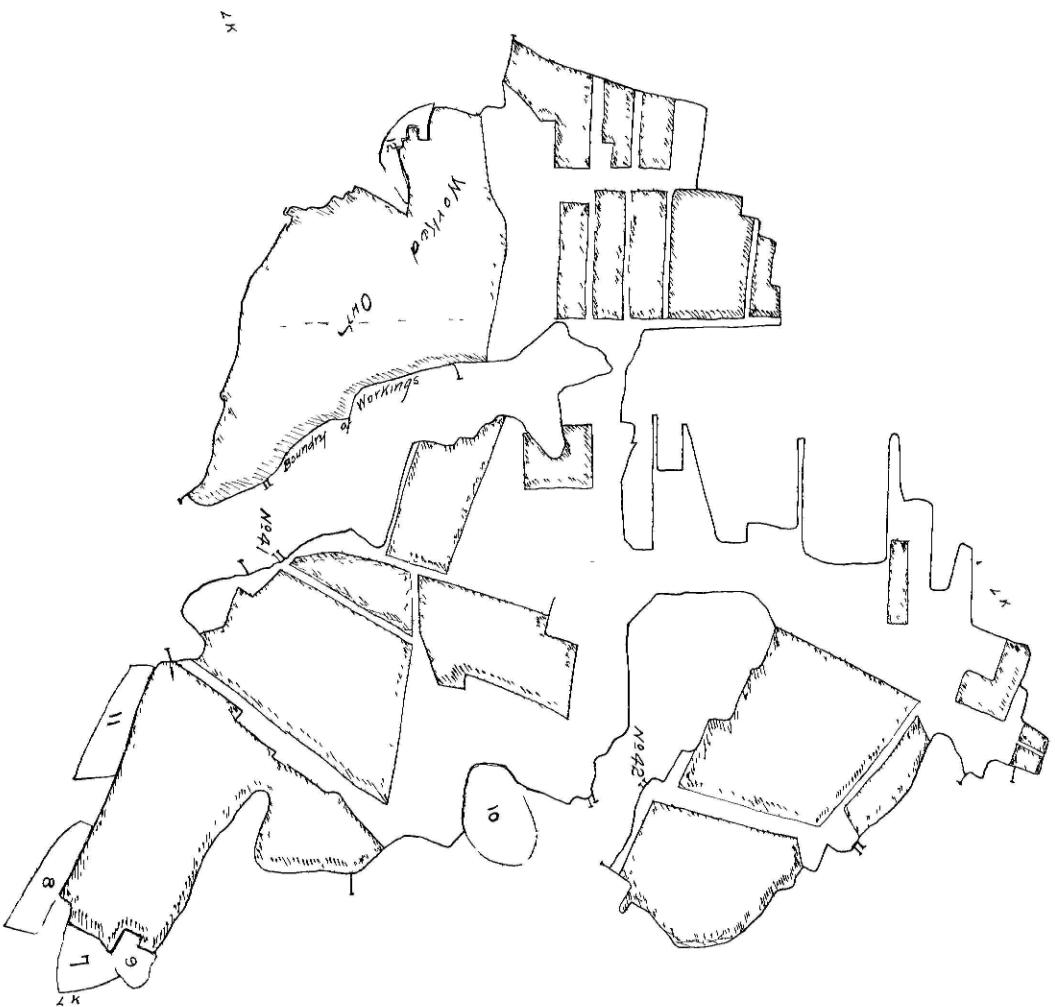

Low Coal - Recovery doubtful

Low Coal - Recovery doubtful

100 ft to 1000 ft - 3015 ft measured thickness

Lower Kintomina Seam - Average height 30

Free - Owned
Minerals
Surface
Leased (None)



North