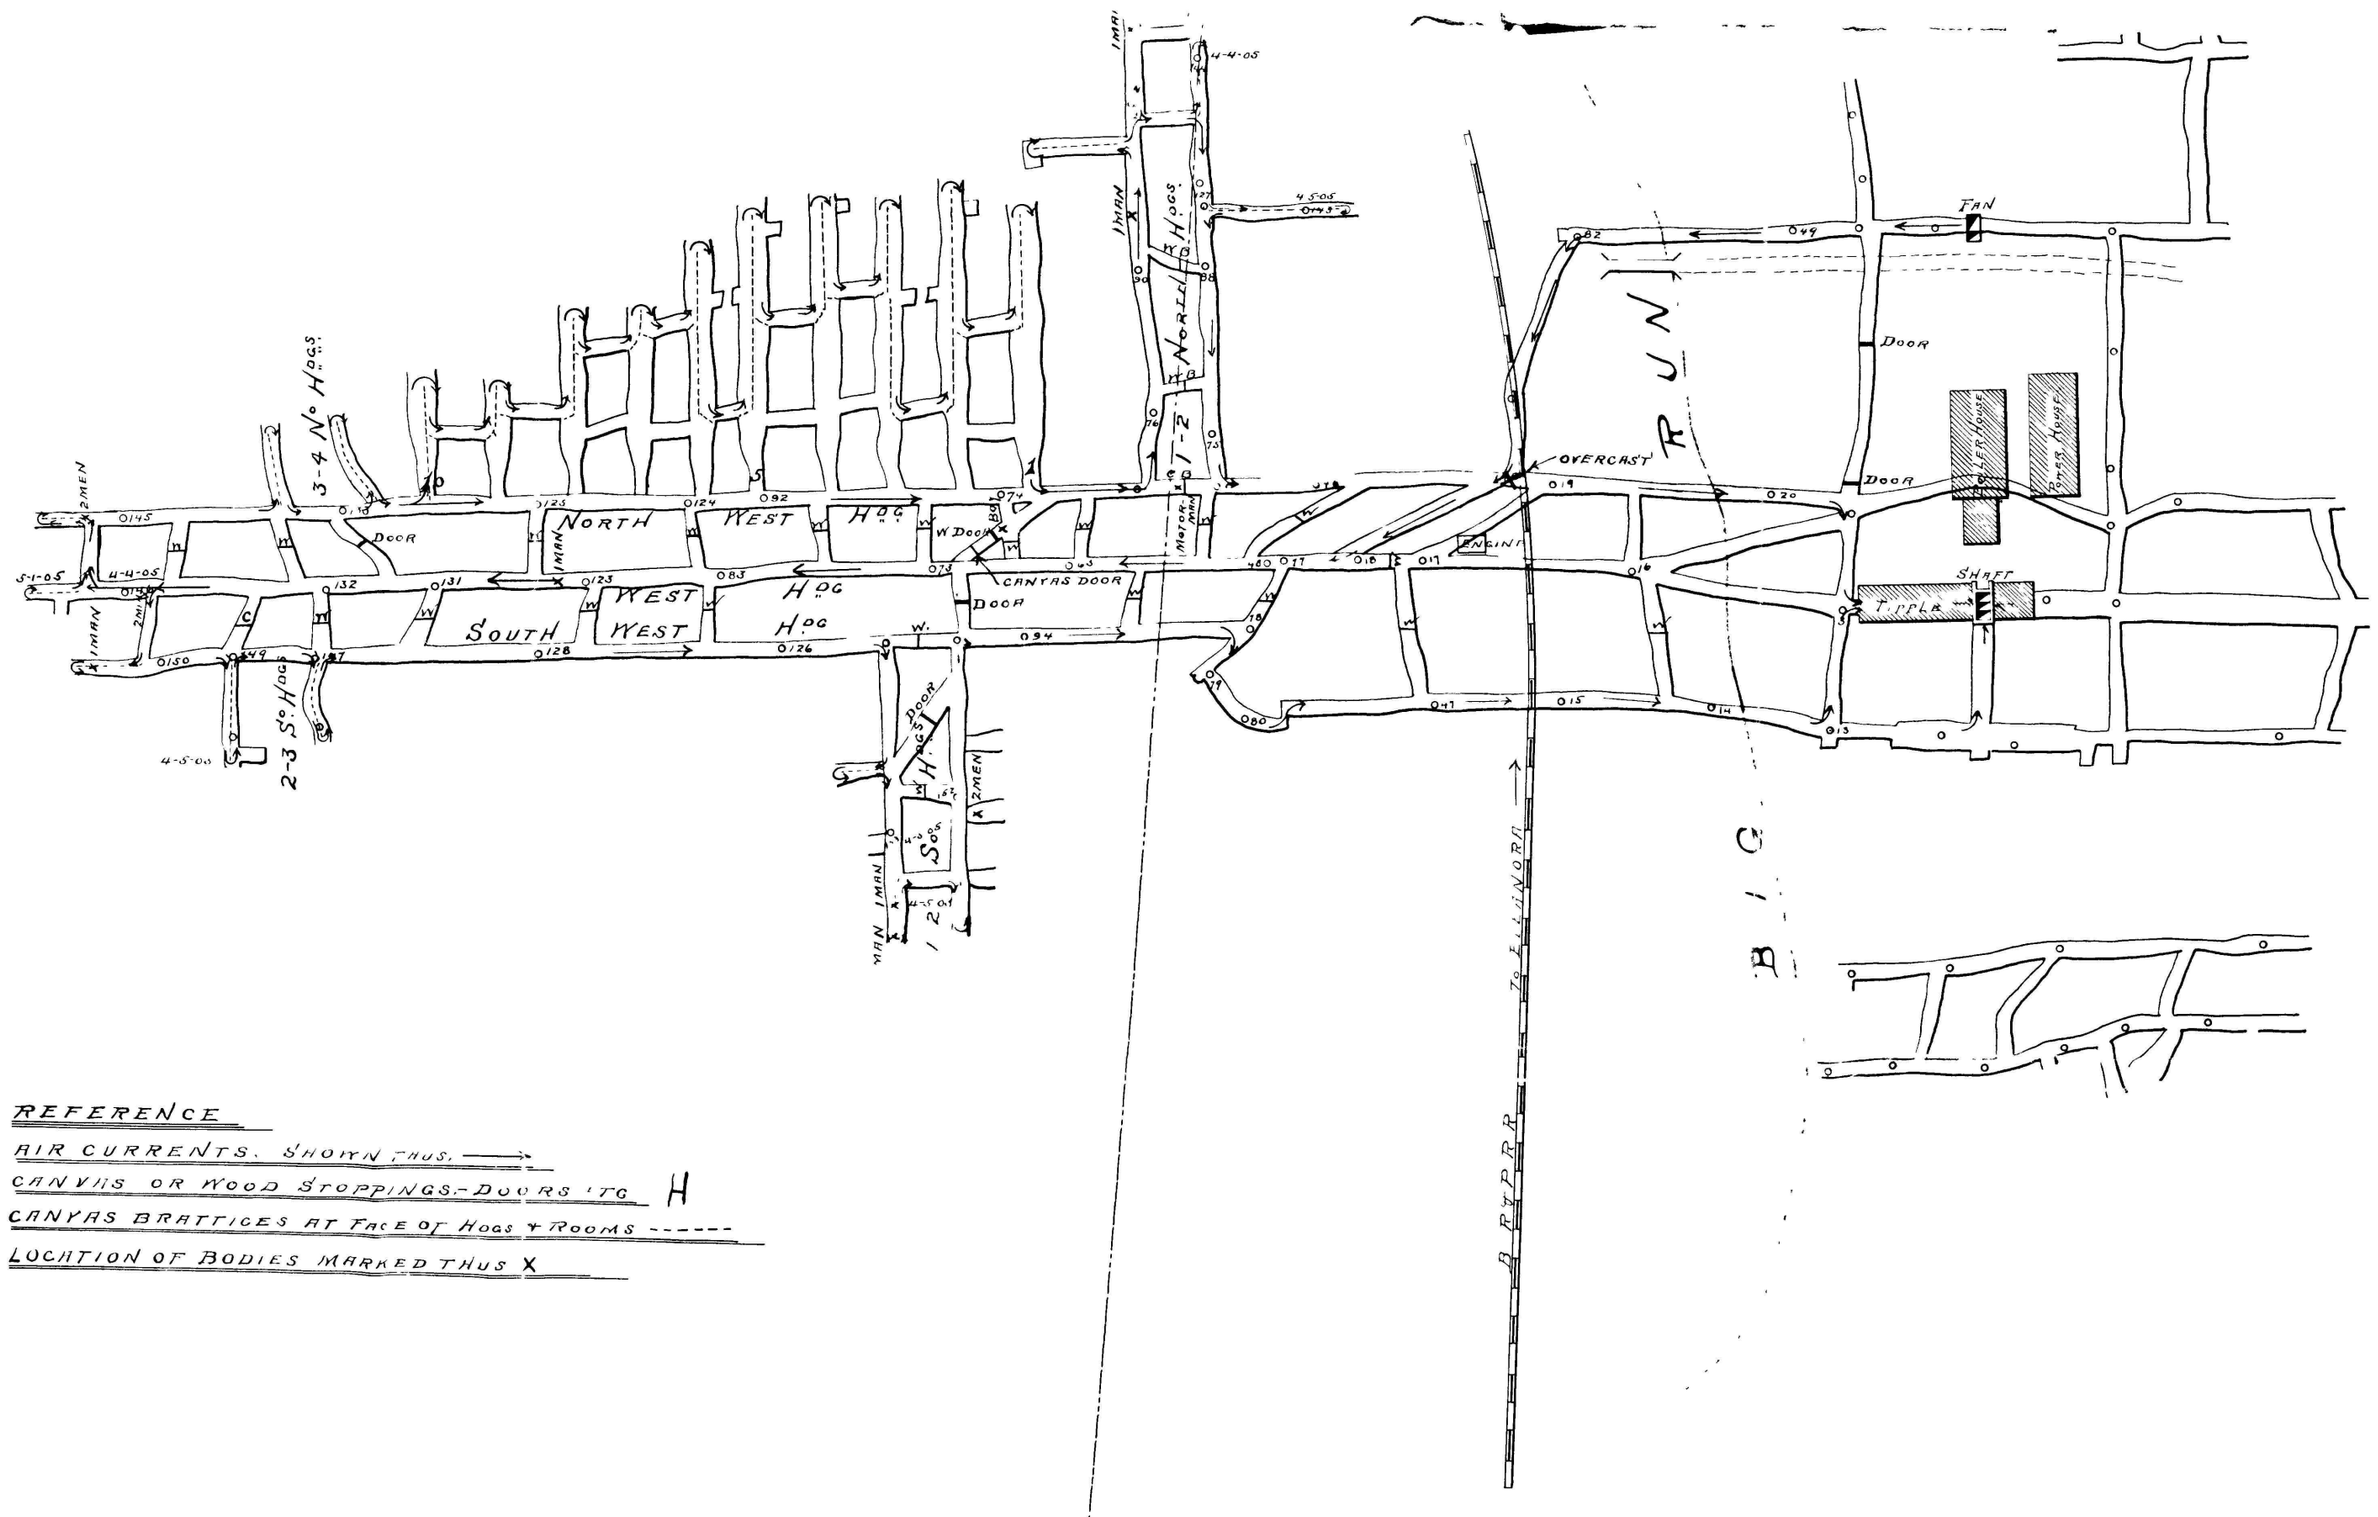

REFERENCE

AIR CURRENTS. SHOWN THUS. ⟶

CANVAS OR WOOD STOPPINGS.-DOORS ETC. H

CANVAS BRATTICES AT FACE OF HOGS + ROOMS ------

LOCATION OF BODIES MARKED THUS X

PLAN

OF THE WEST WORKINGS

ELEANORA SHAFT

MAY-1-1905

1"=100'

814