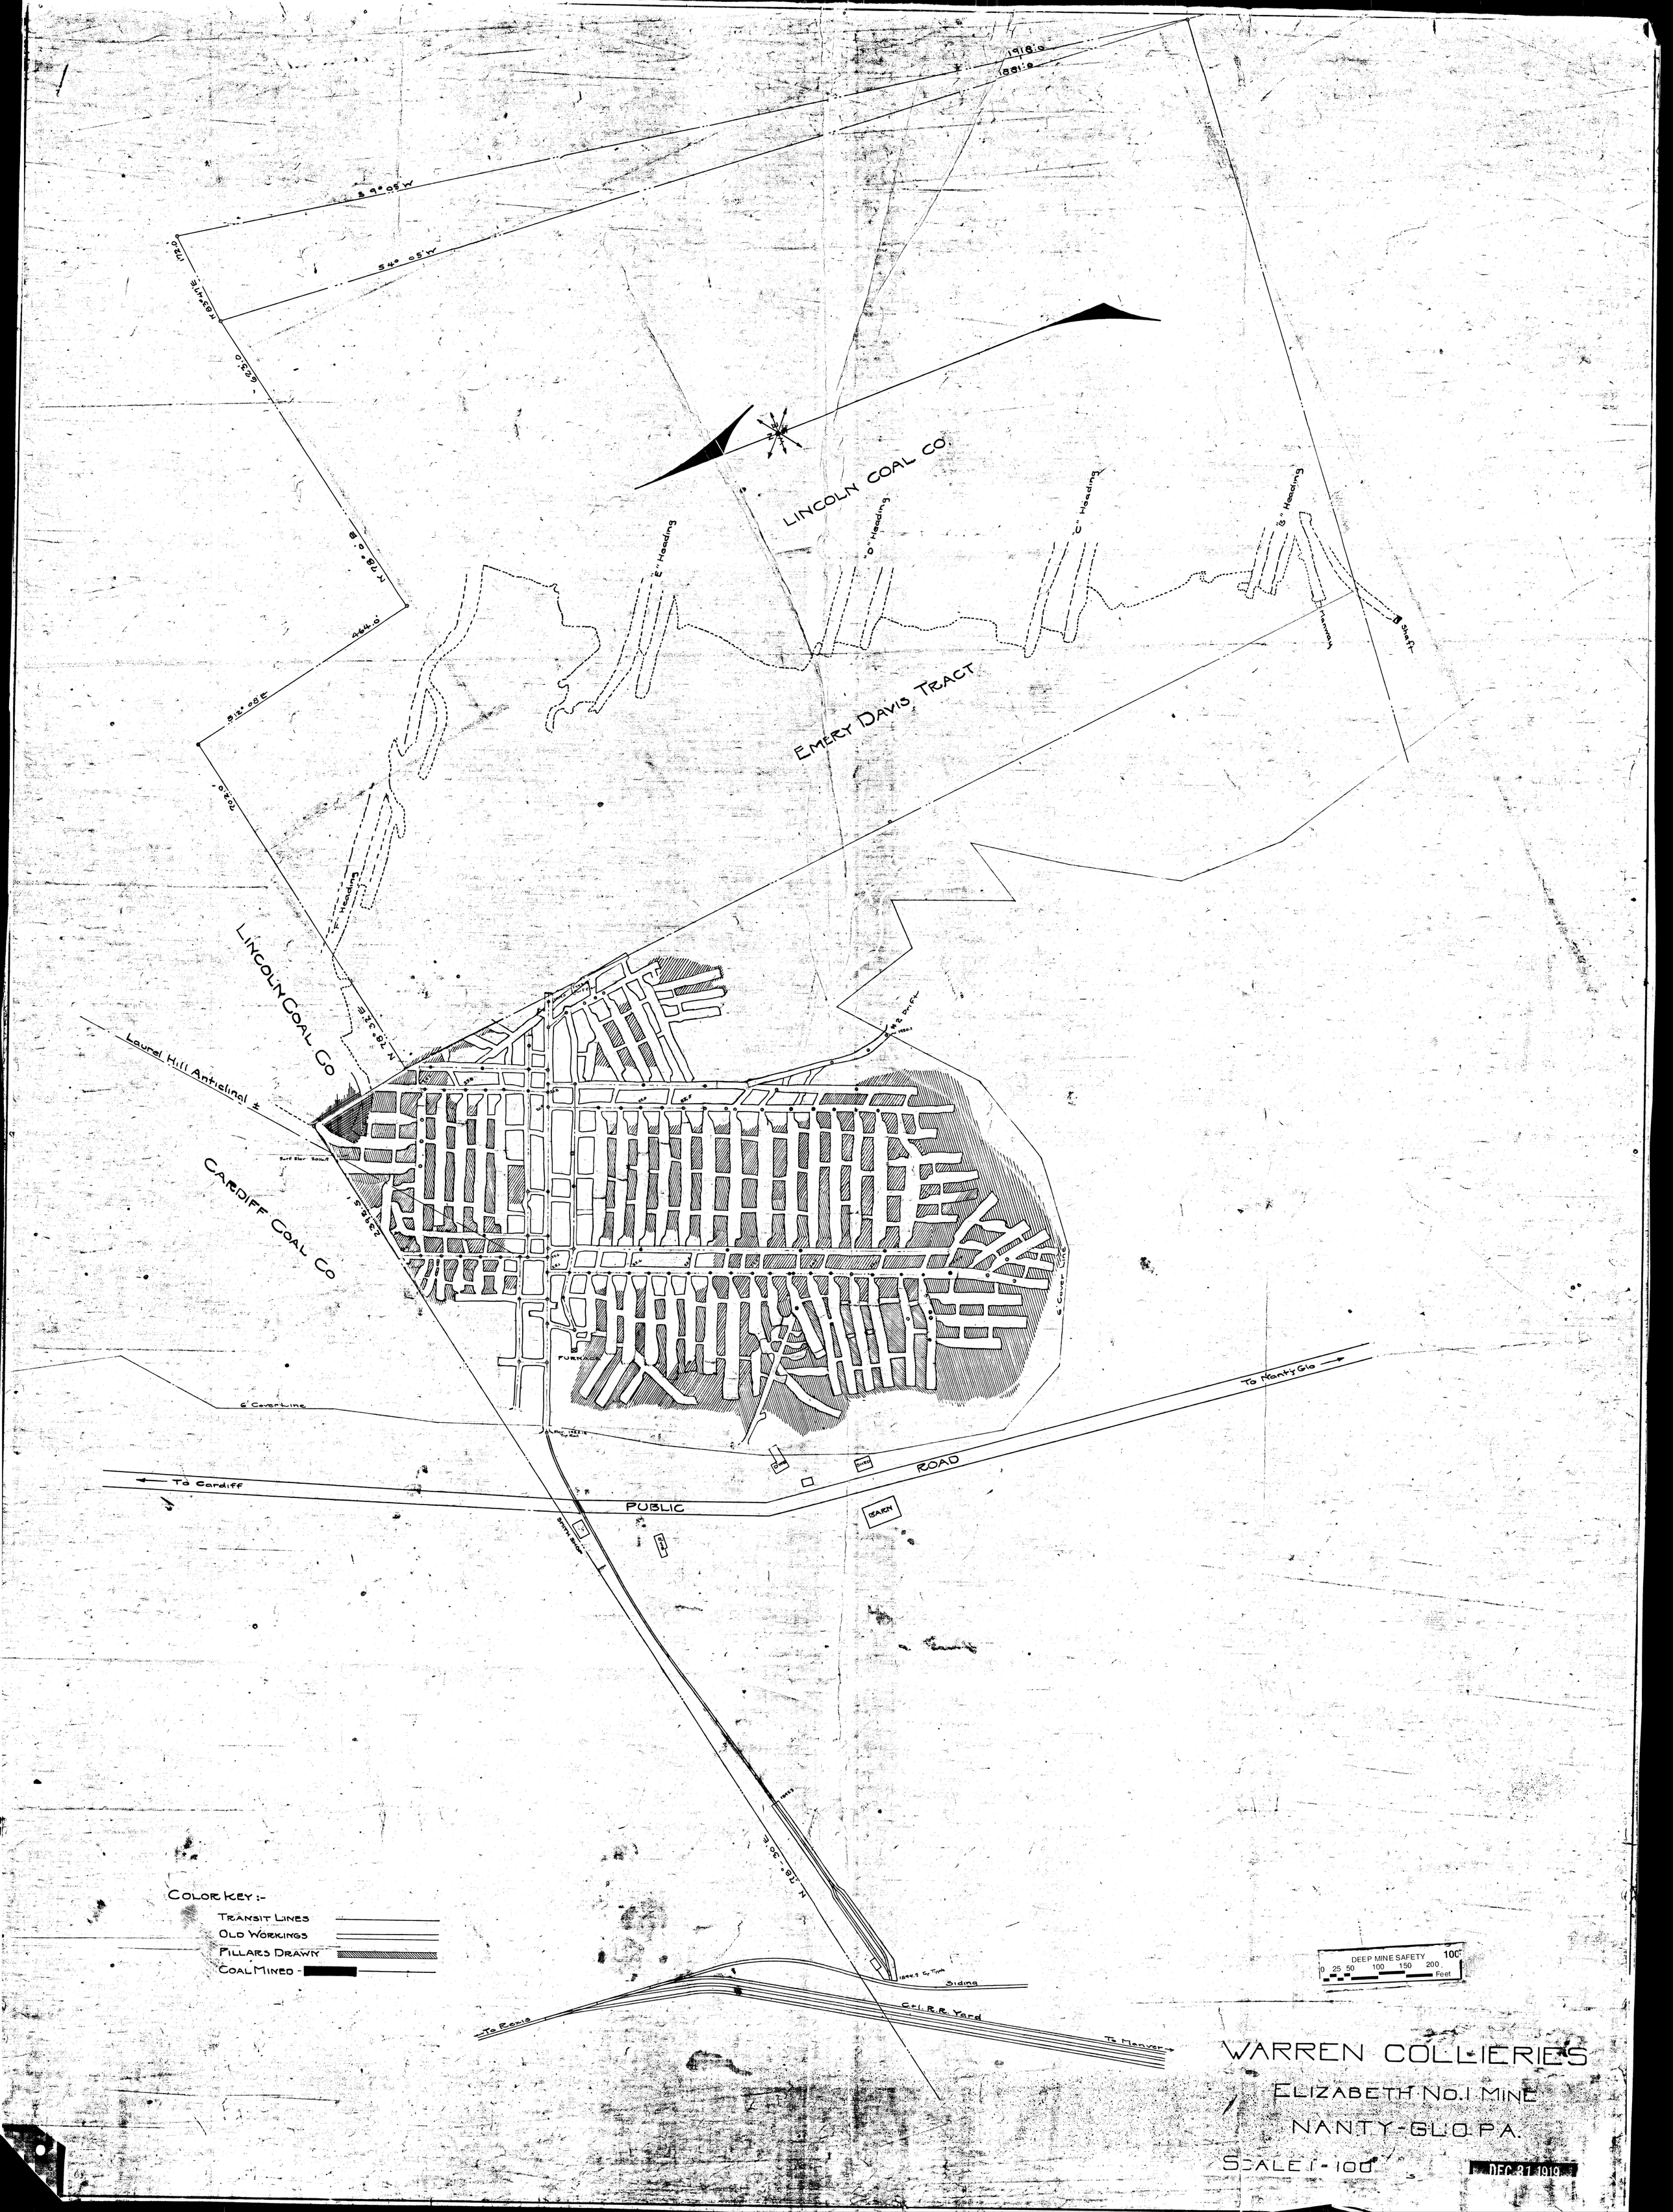
WARREN COLLIERIES
ELIZABETH NO.1 MINE
NANTY-GLO PA.
SCALE 1-100
DEC 31 1919
DEEP MINE SAFETY 100
0 25 50 100 150 200 Feet
COLOR KEY:-
TRANSIT LINES
OLD WORKINGS
PILLARS DRAWN
COAL MINED
LINCOLN COAL CO.
EMERY DAVIS TRACT
LINCOLN COAL CO
CARDIFF COAL CO
Laurel Hill Anticlinal ±
"E" Heading
"D" Heading
"C" Heading
"B" Heading
Shaft
Manway
"F" Heading
N 78°-0' E
464.0'
S 89°-28' E
702.0'
N 78°-30' E
S 54° 05' W
S 49° 05' W
N 78°-30' E
6' Cover Line
To Cardiff
PUBLIC ROAD
To Nanty Glo
BARN
SHED
FURNACE
Siding
C+I. R.R. Yard
To Revis
To Manvers