


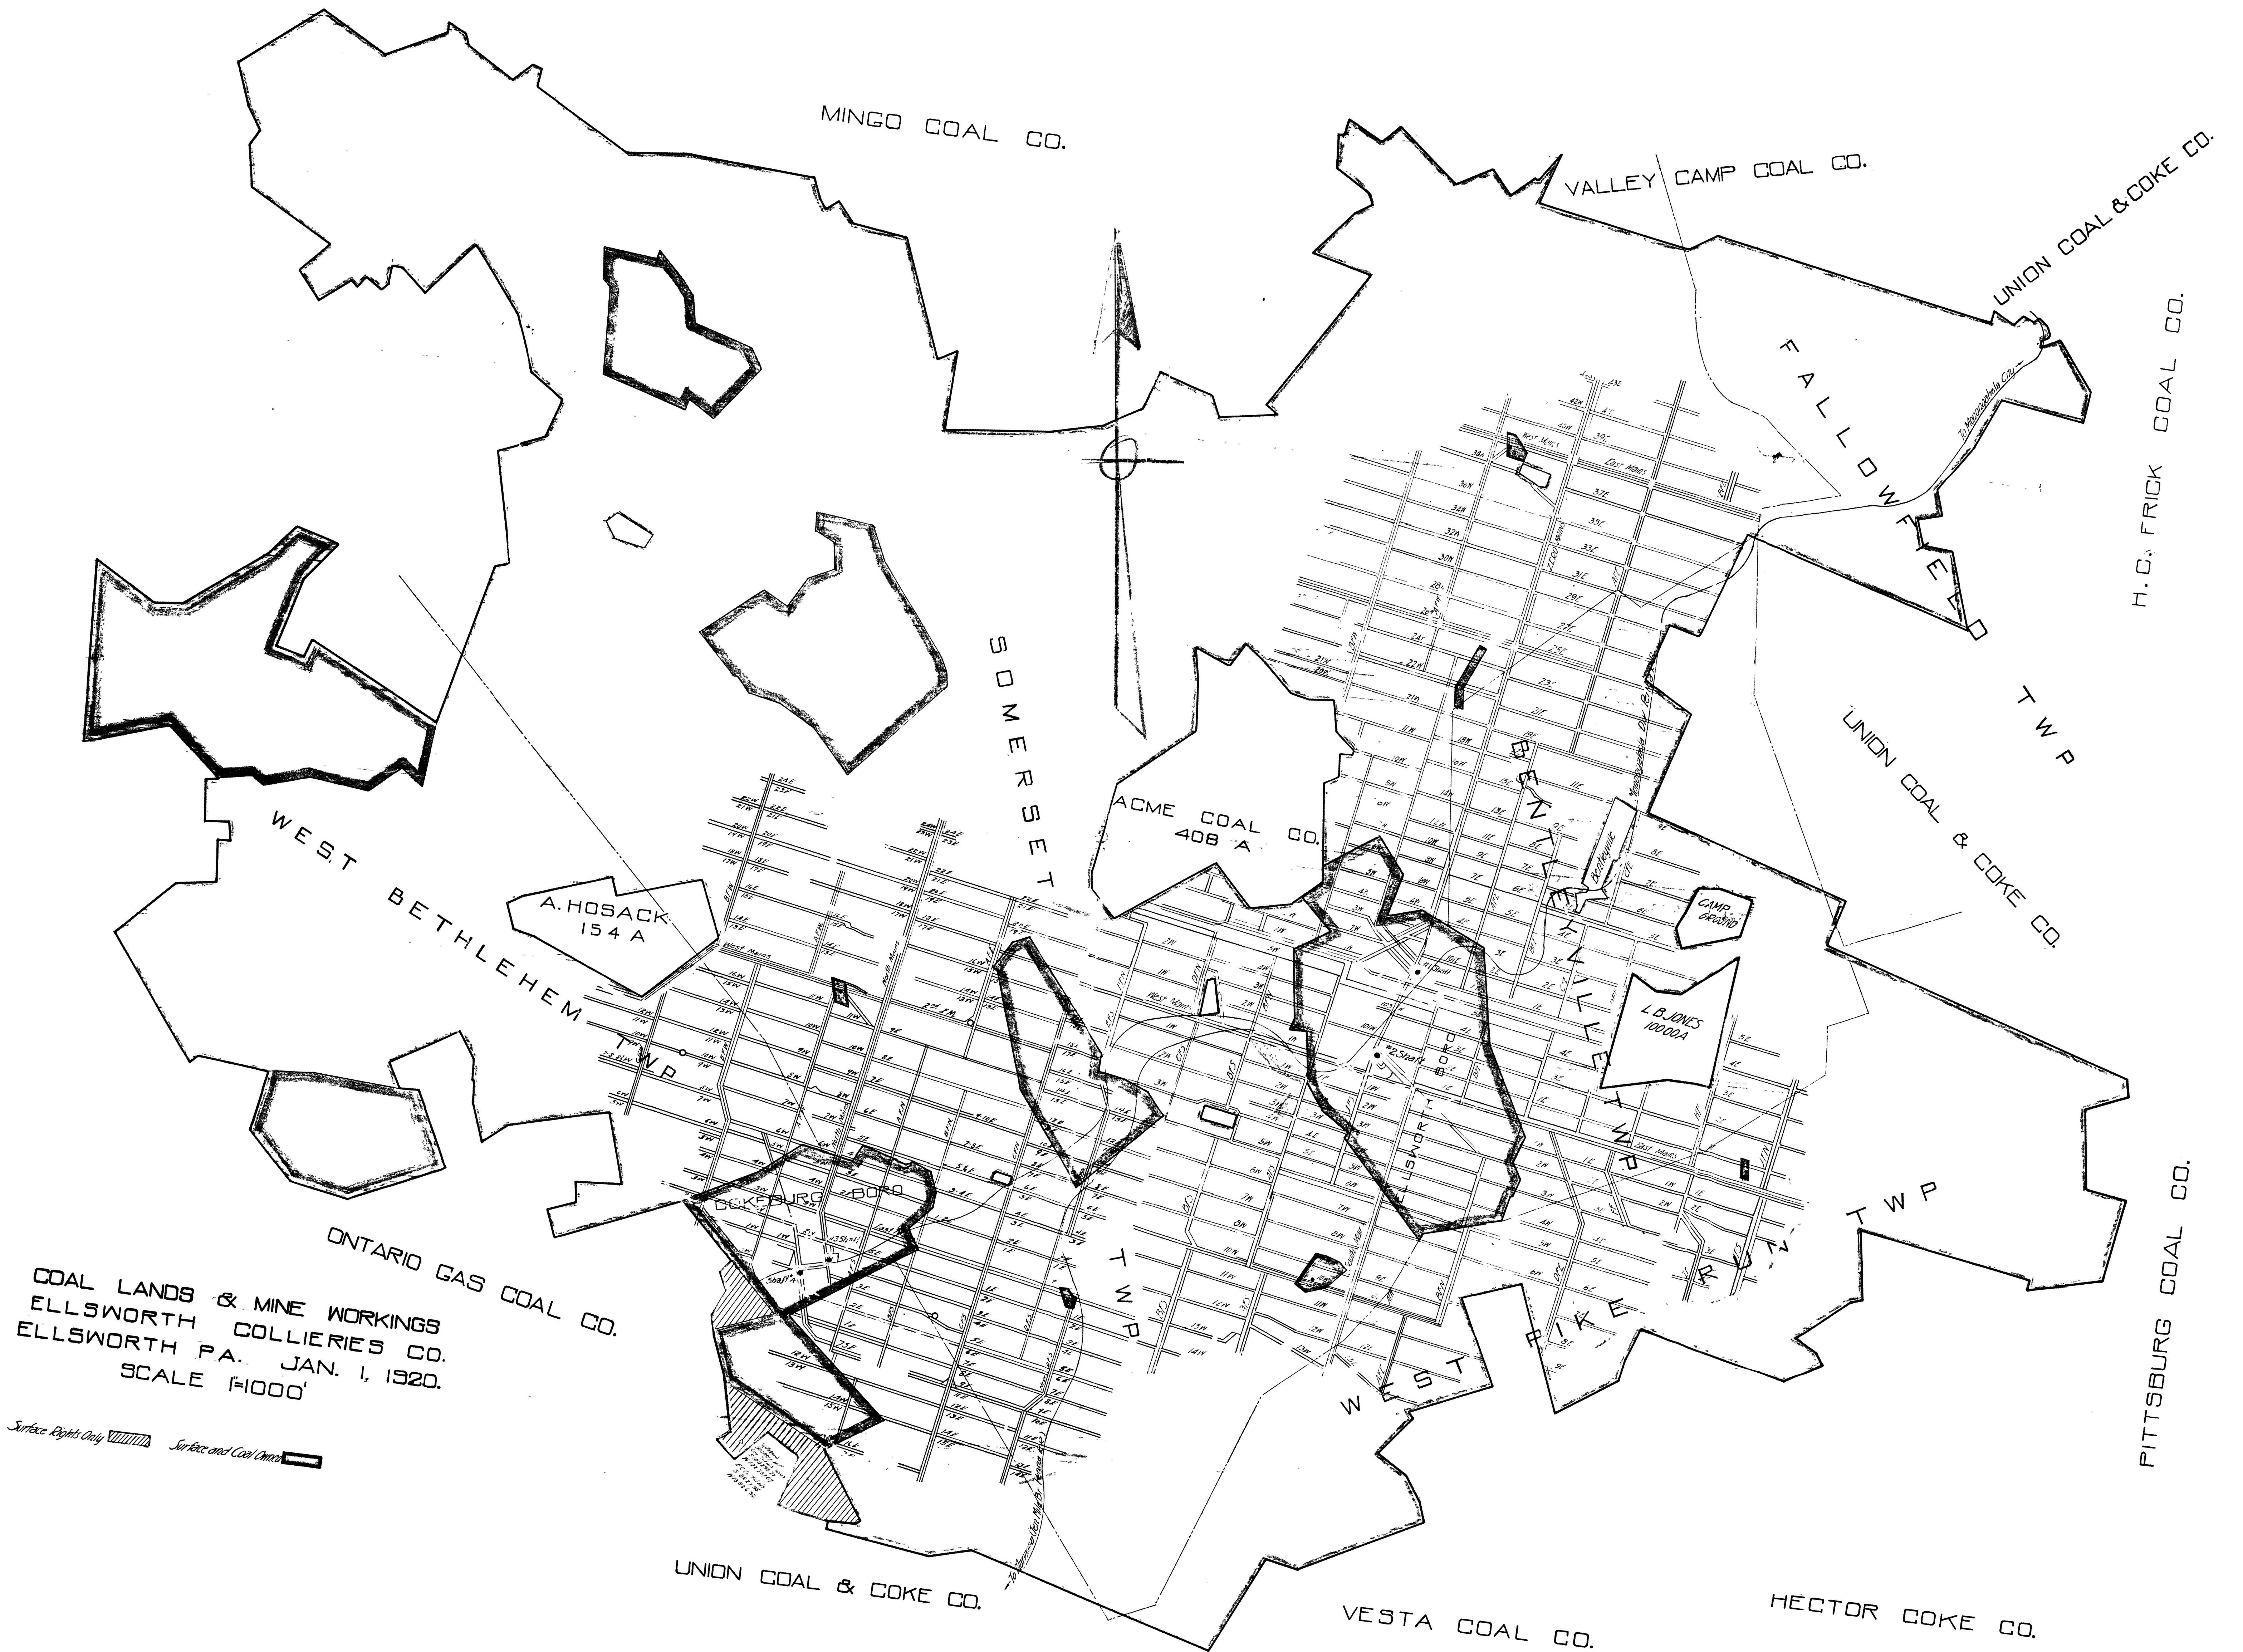

COAL LANDS & MINE WORKINGS
ELLSWORTH COLLIERIES CO.
ELLSWORTH PA. JAN. 1, 1920.
SCALE 1"=1000'

Surface Rights Only  Surface and Coal Under 