

[illegible]

TRIANGLE ENTERPRISES
BREN-MAR MINE
I.D. # 3602370

GRID NORTH

DEVELOP ROOMS/PILLAR BACK

N/F ARTHUR L. BENNETT OF AX.

MINE POOL AT ELEV. 940

100' BARRIER

ELMER L. MACCLURE
43.98 AC. SURF. & SEWAGEY COAL

N/F CAROLE COLE

LEGEND

- INTAKE
- RETURN
- BLEEDER
- OVERCAST
- REGULATOR
- PERMANENT STOPPING
- BOXCHECK
- MANDOOR
- LOADING POINT
- BELT
- SURVEY STATION
- PRIMARY ESCAPEWAY
- SECONDARY ESCAPEWAY
- COAL CONTOUR LINE
- PILLARED AREA
- 6 MONTHS PROJECTION
- CHECK CURTAIN
- MONITORING STATION
- PERMANENT SEAL
- INCOMBUSTIBLE MATERIAL

MINING COMPLETED MARCH 1985

N/F DUNKARD TOWNSHIP

N/F BOBTOWN RD & GUN CLUB

N/F EMELIO ERMINO

N/F ALBERT LUXNER

M.D. # 3083301

EMELIO MINING COMPANY, LTD.
NO. 1 MINE ID. NO. 36-07518

P.O. BOX 399 BOBTOWN, PA. 15315
DUNKARD TWP. GREENE CO.
SCALE: 1" = 100' DATE: 5/7/86

PREPARED BY
CHARBEL MINING SERVICES, INC.
P.O. BOX 399 BOBTOWN, PA.

Final Map

DEEP MINE SAFETY 100

TRIANGLE ENTERPRISES
BREN-MAR MINE
I.D. # 3602370

GRID NORTH

DEVELOP ROOMS/PILLAR BACK

N/F ARTHUR L. BENNETT OF AX.

MINE POOL AT ELEV. 940

100' BARRIER

ELMER L. MACCLURE
43.98 AC. SURF. & SEWAGEY COAL

N/F CAROLE COLE

LEGEND

- INTAKE
- RETURN
- BLEEDER
- OVERCAST
- REGULATOR
- PERMANENT STOPPING
- BOXCHECK
- MANDOOR
- LOADING POINT
- BELT
- SURVEY STATION
- PRIMARY ESCAPEWAY
- SECONDARY ESCAPEWAY
- COAL CONTOUR LINE
- PILLARED AREA
- 6 MONTHS PROJECTION
- CHECK CURTAIN
- MONITORING STATION
- PERMANENT SEAL
- INCOMBUSTIBLE MATERIAL

MINING COMPLETED MARCH 1985

N/F DUNKARD TOWNSHIP

N/F BOBTOWN RD & GUN CLUB

N/F EMELIO ERMINO

N/F ALBERT LUXNER

M.D. # 3083301

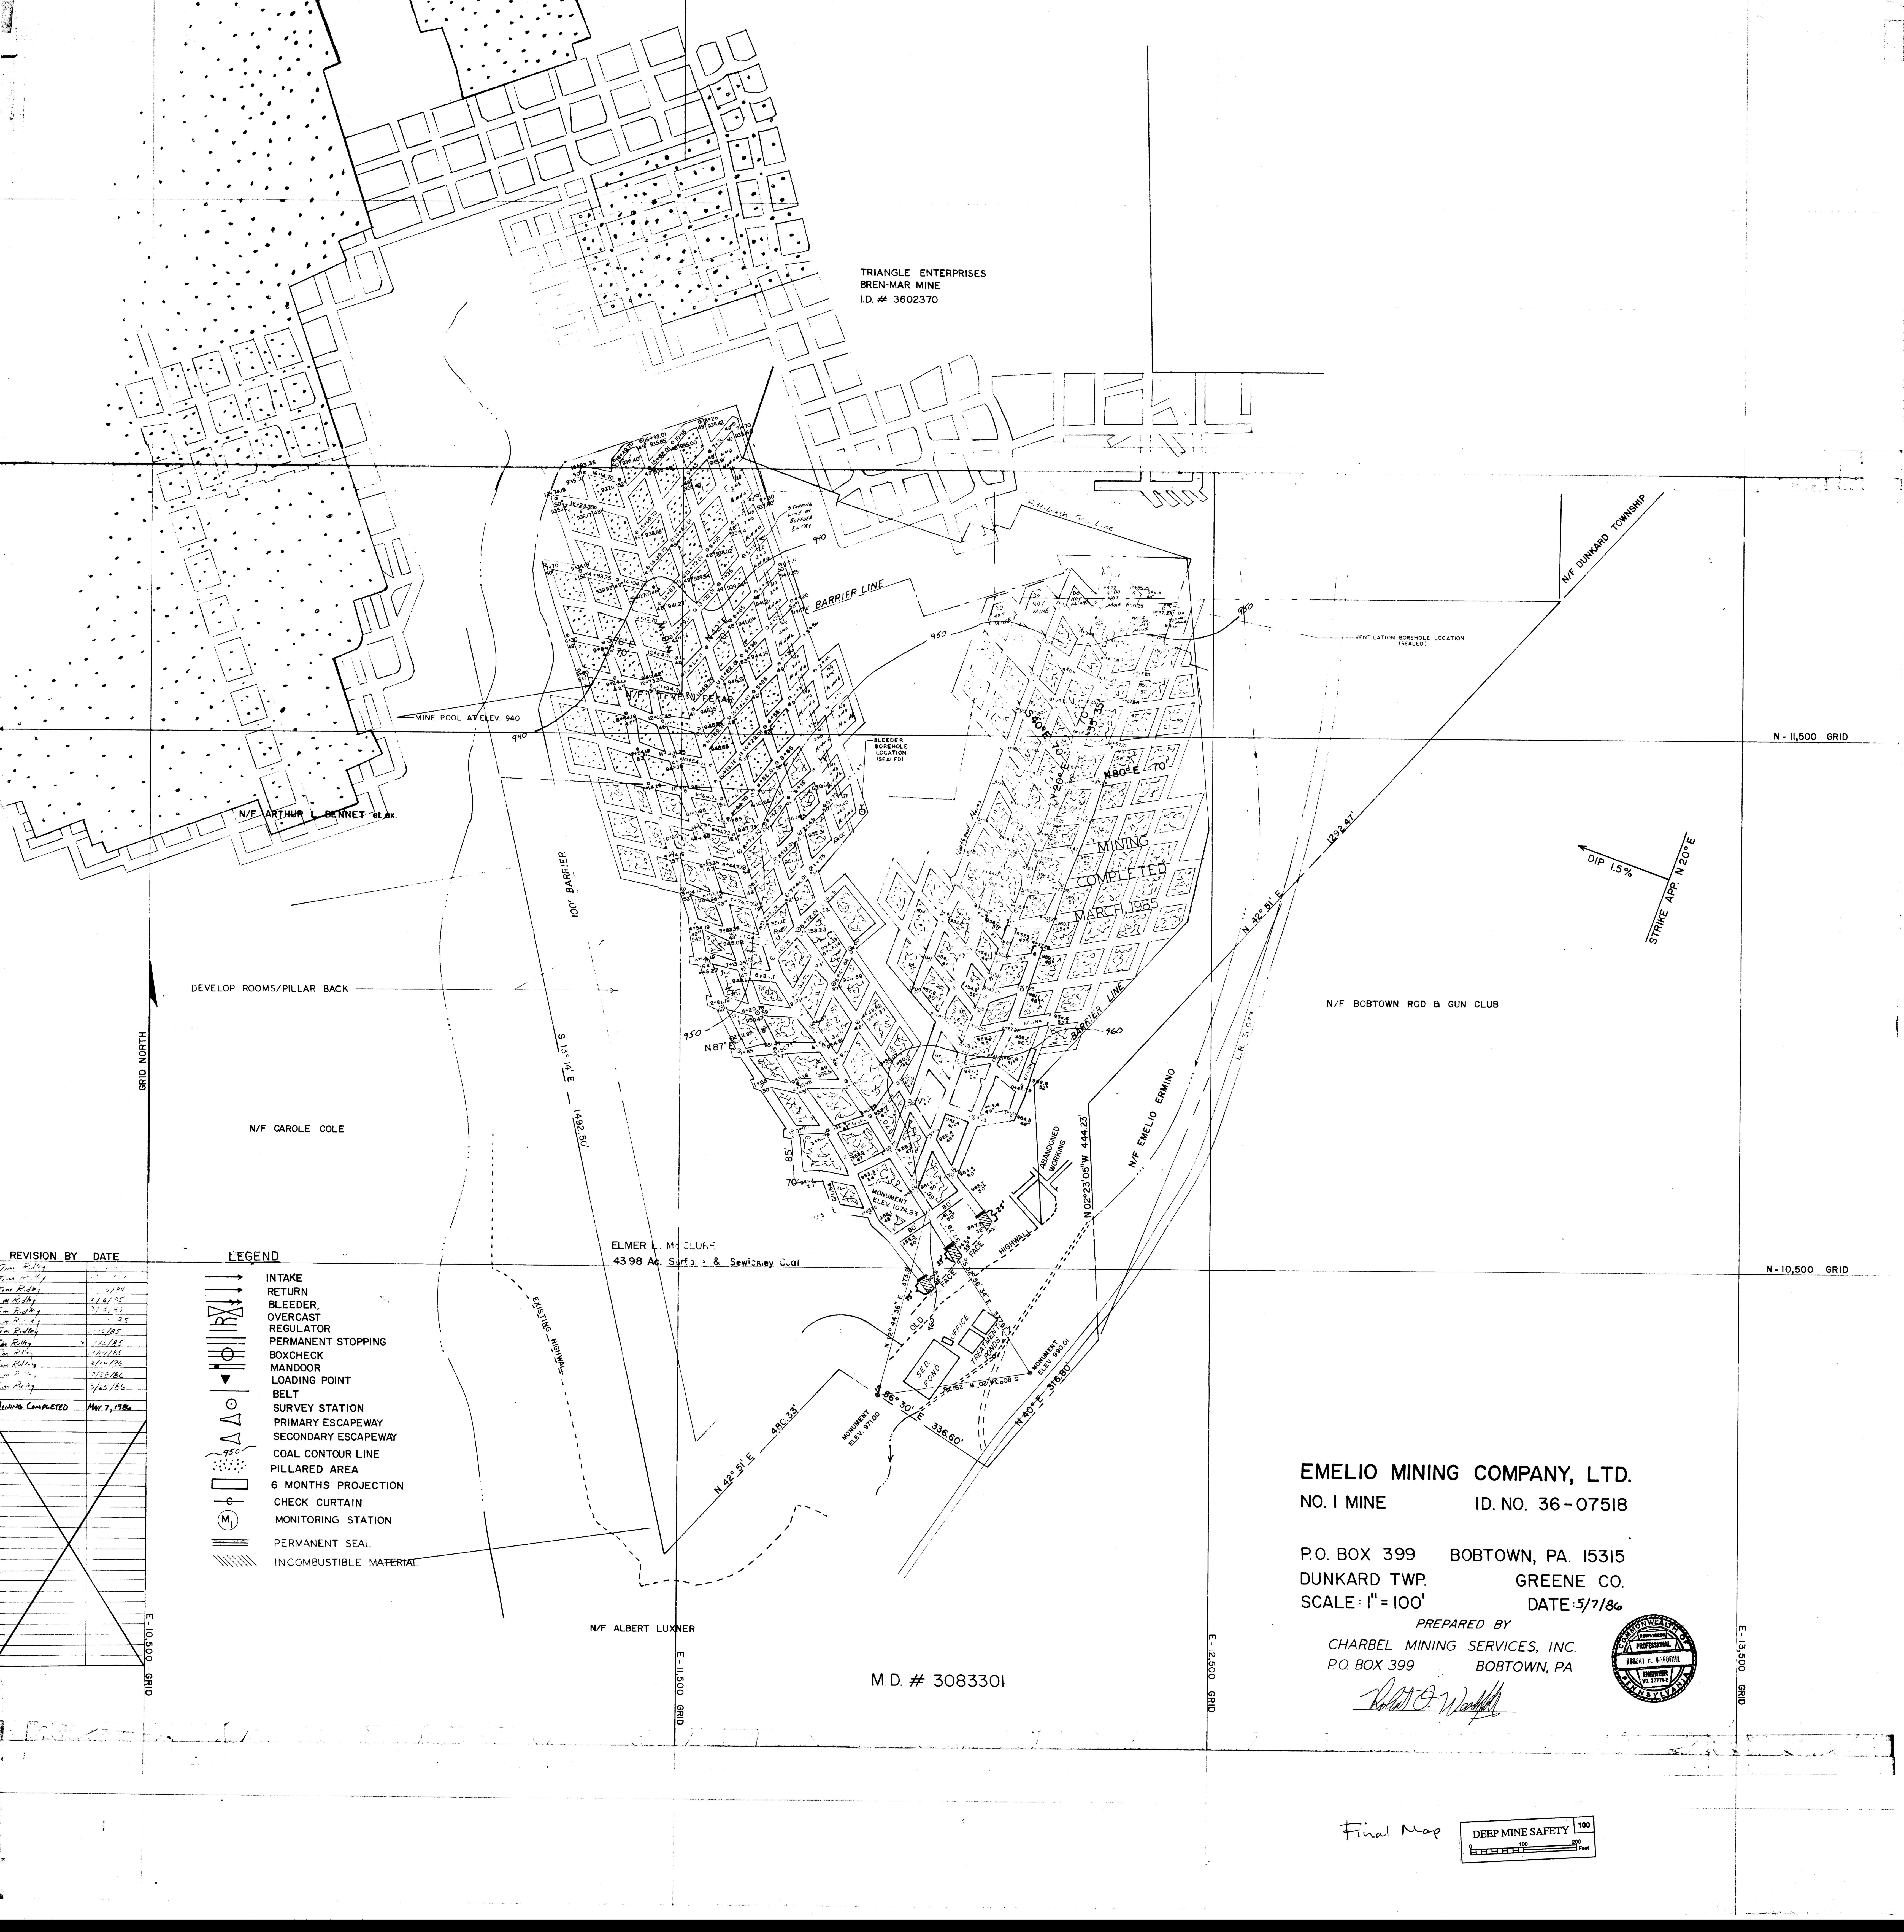
EMELIO MINING COMPANY, LTD.
NO. 1 MINE ID. NO. 36-07518

P.O. BOX 399 BOBTOWN, PA. 15315
DUNKARD TWP. GREENE CO.
SCALE: 1" = 100' DATE: 5/7/86

PREPARED BY
CHARBEL MINING SERVICES, INC.
P.O. BOX 399 BOBTOWN, PA.

Final Map

DEEP MINE SAFETY

[illegible][illegible][illegible][illegible][illegible][illegible]