

TRIANGLE ENTERPRISES
BREN-MAR MINE
I.D. # 3602370



N - 11,500 GRID

N - 10,500 GRID

E - 13,500 GRID

E - 12,500 GRID

GRID NORTH

DEVELOP ROOMS/PILLAR BACK

N/F CAROLE COLE

N/F ALBERT LUXNER

ELMER L. MCCLURE
43.98 AC. SURF. & SEWIDNEY COAL

N/F BOBTOWN ROD & GUN CLUB

DIP 1.5%
STRIKE APP. N 20° E

REVISION BY DATE

REVISION BY	DATE
W. R. Kelly	1/1/80
W. R. Kelly	1/1/81
W. R. Kelly	1/1/00

MINING COMPLETED MAY 7, 1986

LEGEND

- INTAKE
- RETURN
- BLEEDER
- OVERCAST
- REGULATOR
- PERMANENT STOPPING
- BOXCHECK
- MANDOOR
- LOADING POINT
- BELT
- SURVEY STATION
- PRIMARY ESCAPEWAY
- SECONDARY ESCAPEWAY
- COAL CONTOUR LINE
- PILLARED AREA
- 6 MONTHS PROJECTION
- CHECK CURTAIN
- MONITORING STATION
- PERMANENT SEAL
- INCOMBUSTIBLE MATERIAL

DER
100' SCALE
MONITORING


M.D. # 3083301

DEEP MINE SAFETY 100'

EMELIO MINING COMPANY, LTD.
NO. 1 MINE ID. NO. 36-07518

P.O. BOX 399 BOBTOWN, PA. 15315
DUNKARD TWP. GREENE CO.
SCALE: 1" = 100' DATE: 6/6/86

PREPARED BY
CHARBEL MINING SERVICES, INC.
P.O. BOX 399 BOBTOWN, PA

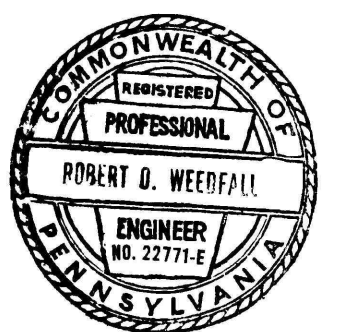

Final map

#911
7-14-99
C.C.