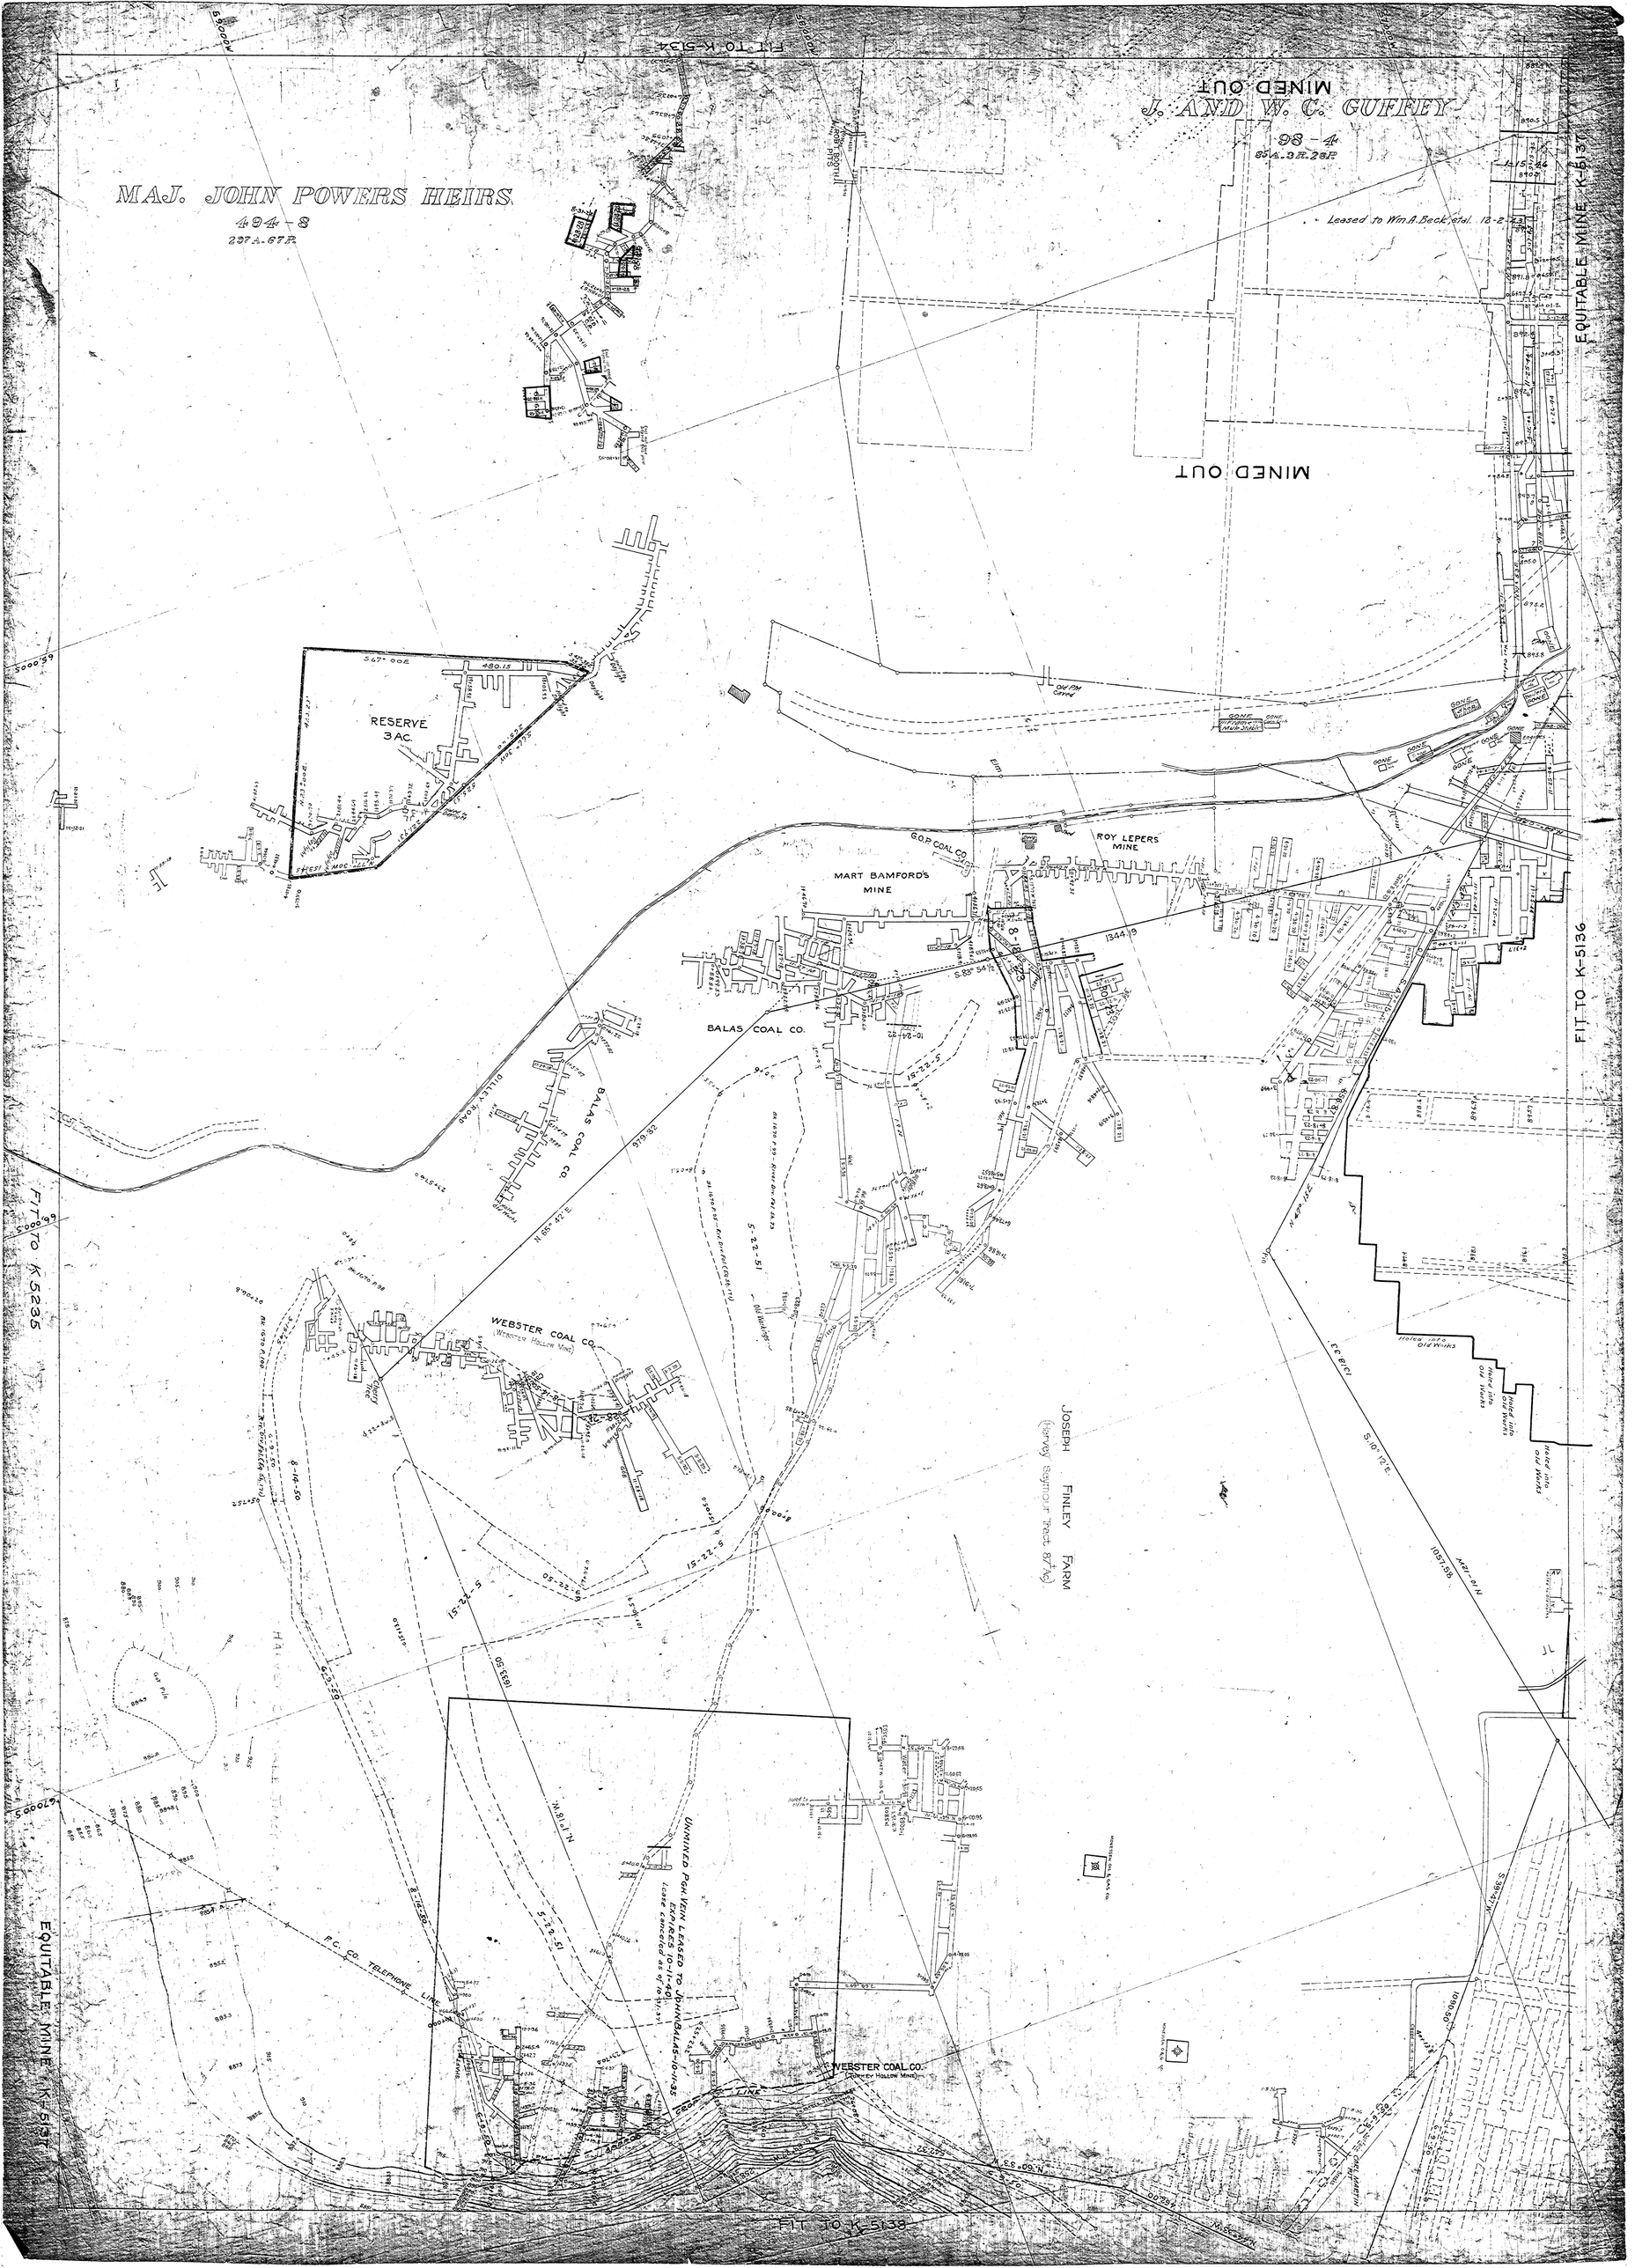
FIT TO K-5134
MINED OUT
J. AND W. C. GUFFEY
98-4
85 A. 3 R. 28 P.
Leased to Wm. A. Beck, et al. 12-2-
MAJ. JOHN POWERS HEIRS
494-8
237 A. 67 P.
MINED OUT
EQUITABLE MINE K-5137
RESERVE
3 AC.
567.00E
480.15
N 33 20 E
S 44°51' 30" E
N 00°22' E
N 00° 27' E
OLD PIN
CAVED
GONE
GONE
GONE
GONE
GONE
GONE
GONE
GONE
G.O.P. COAL CO.
ROY LEPERS
MINE
MART BAMFORD'S
MINE
1344.19
S 88° 54½'
BALAS COAL CO.
BALAS COAL CO.
BILLEY ROAD
N 65° 42' E
979.92
WEBSTER COAL CO.
(Webster Hollow Mine)
OLD WORKS
5-22-51
15-22-5
8-14-50
6-25-50
N 49° 10' E
EC 8101
S 10° 12' E
1057.58
N 49° 01' N
Holed into old Works
Holed into old Works
Holed into old Works
Holed into old Works
JOSEPH FINLEY FARM
(Harvey Seymour Tract 87½ Ac.)
1835.50
N 18° 01' N
5-22-51
UNMINED PEA VEIN LEASED TO JOHN BALAS 10-1-35
EXPIRES 10-1-40
(Lease cancelled as of 10-1-51)
P.C. CO. TELEPHONE LINE
WEBSTER COAL CO.
(Webster Hollow Mine)
LINE
N 60° 53' W
26.225
S 39° 47' W
1060.50
FIT TO K-5136
FIT TO K-5135
EQUITABLE MINE K-5137
FIT TO K-5138