


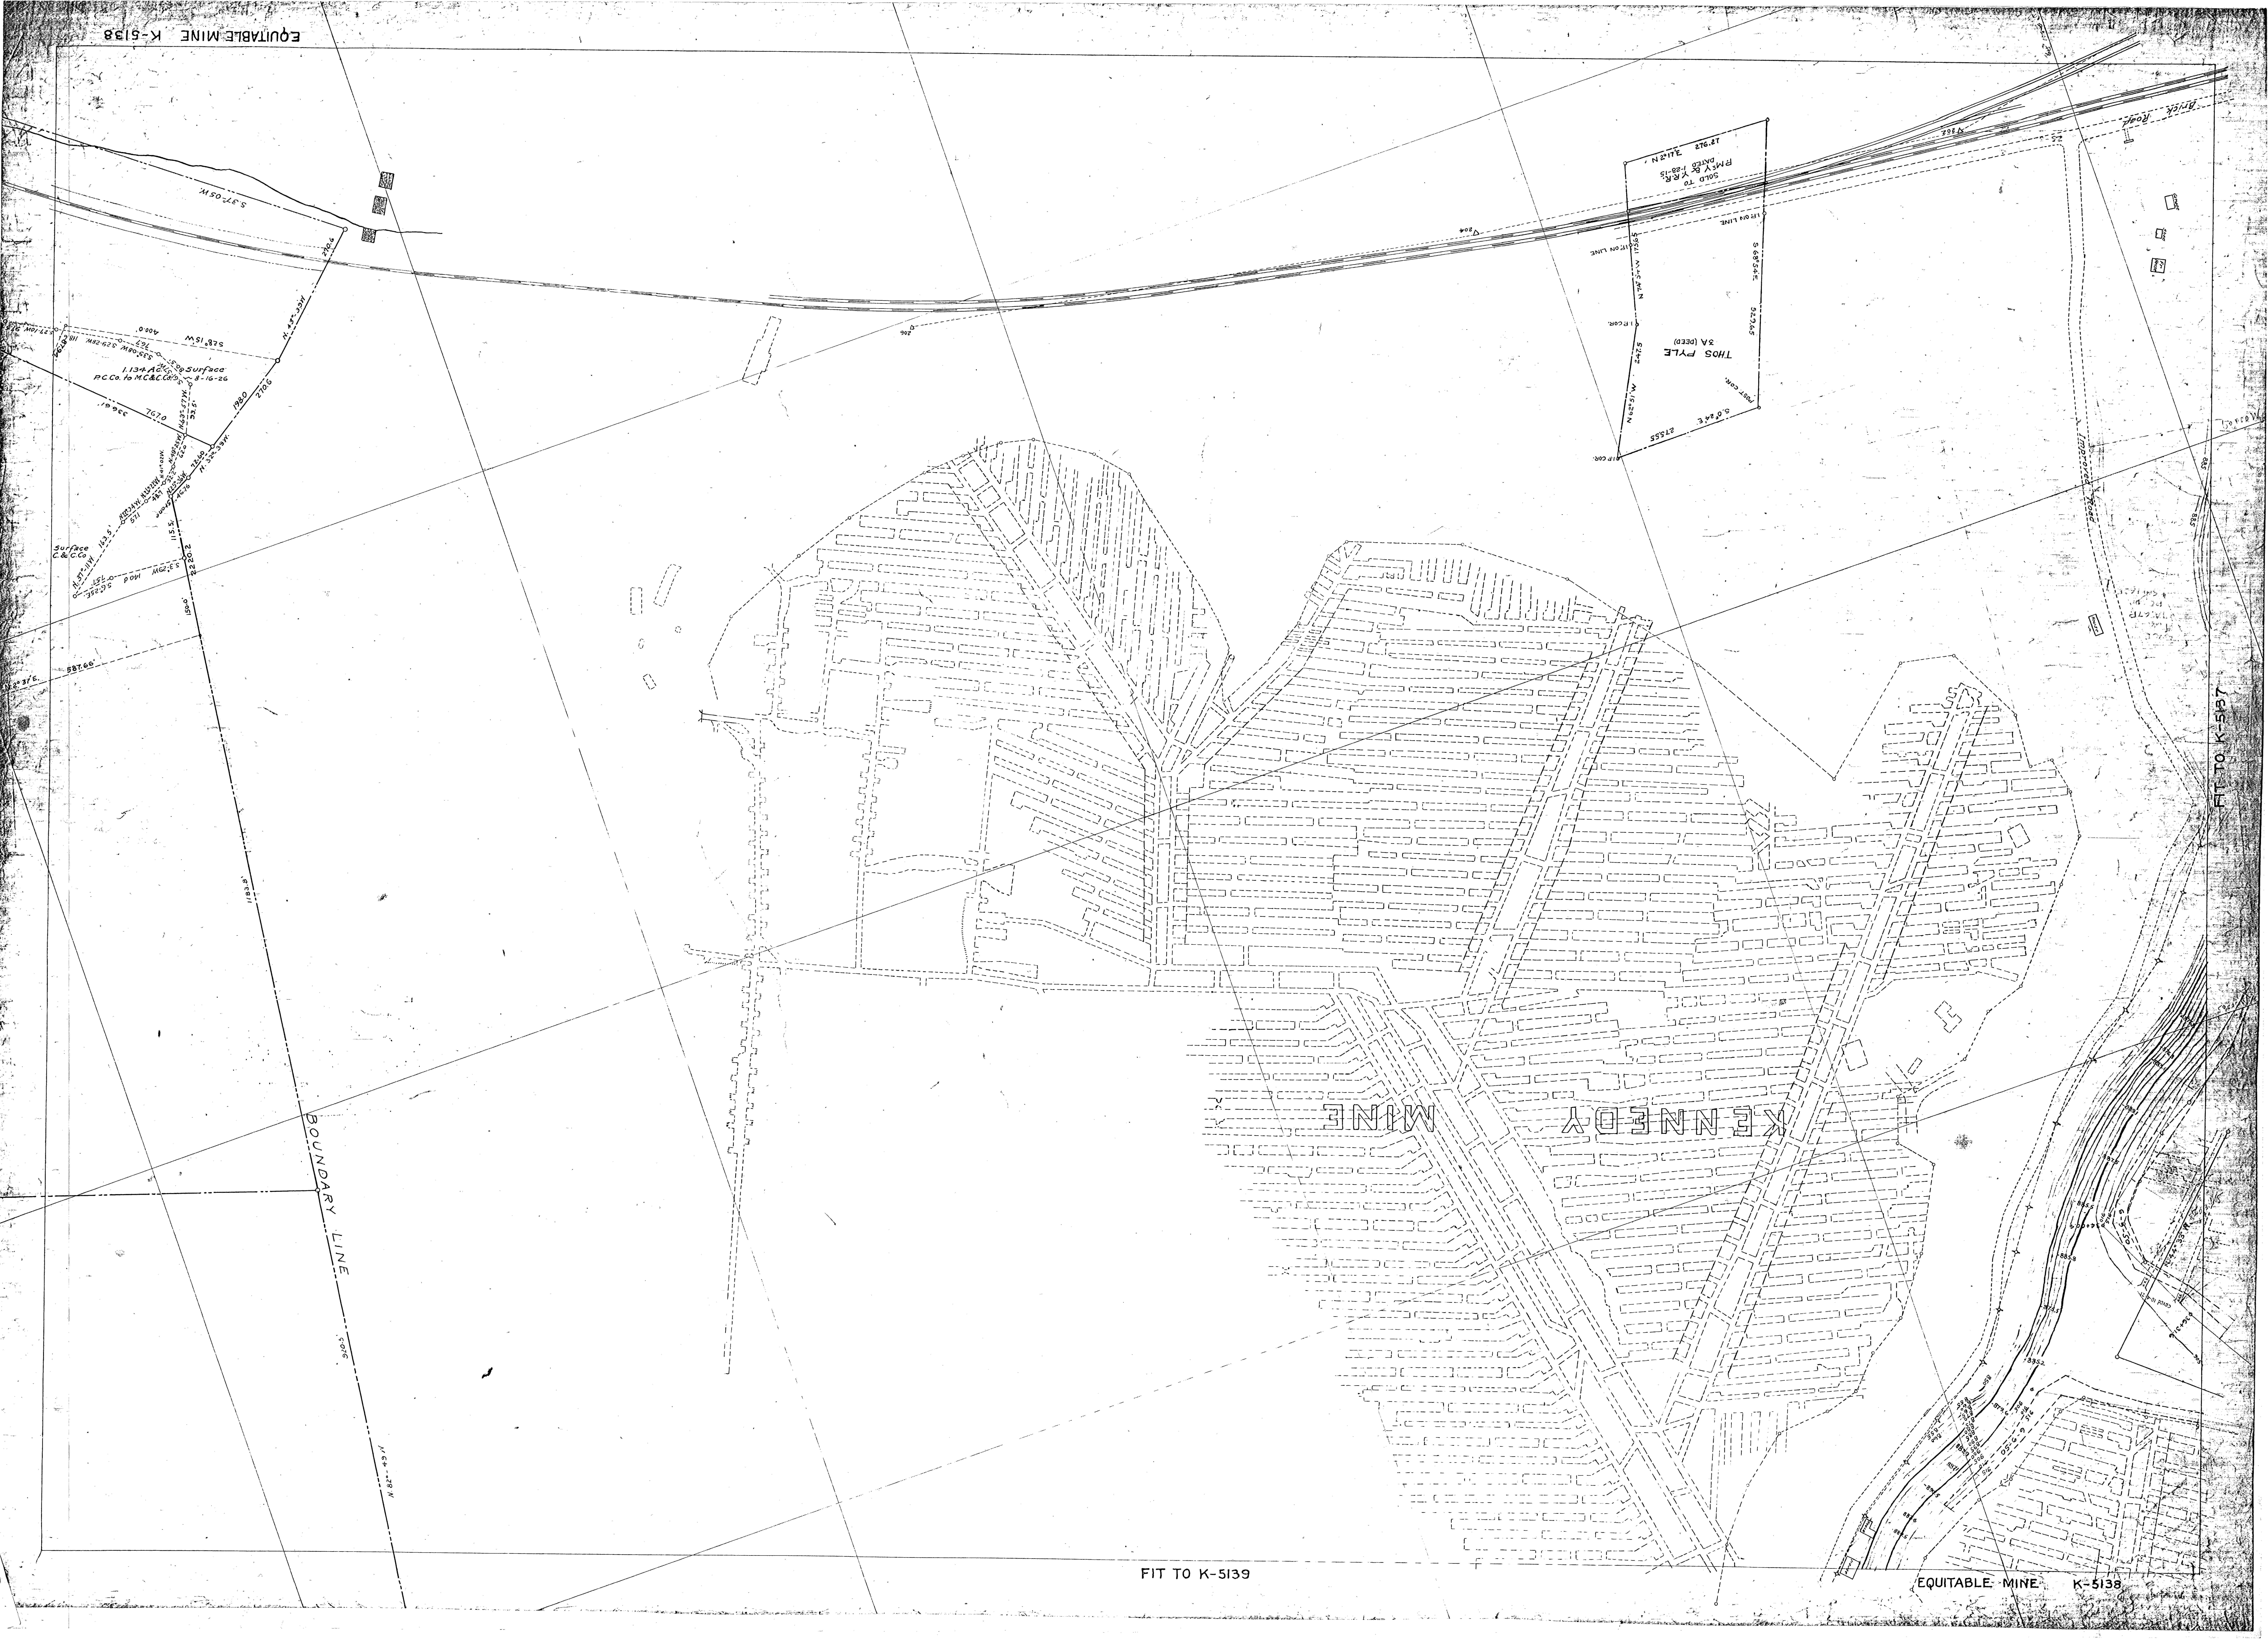

BOUNDARY LINE