


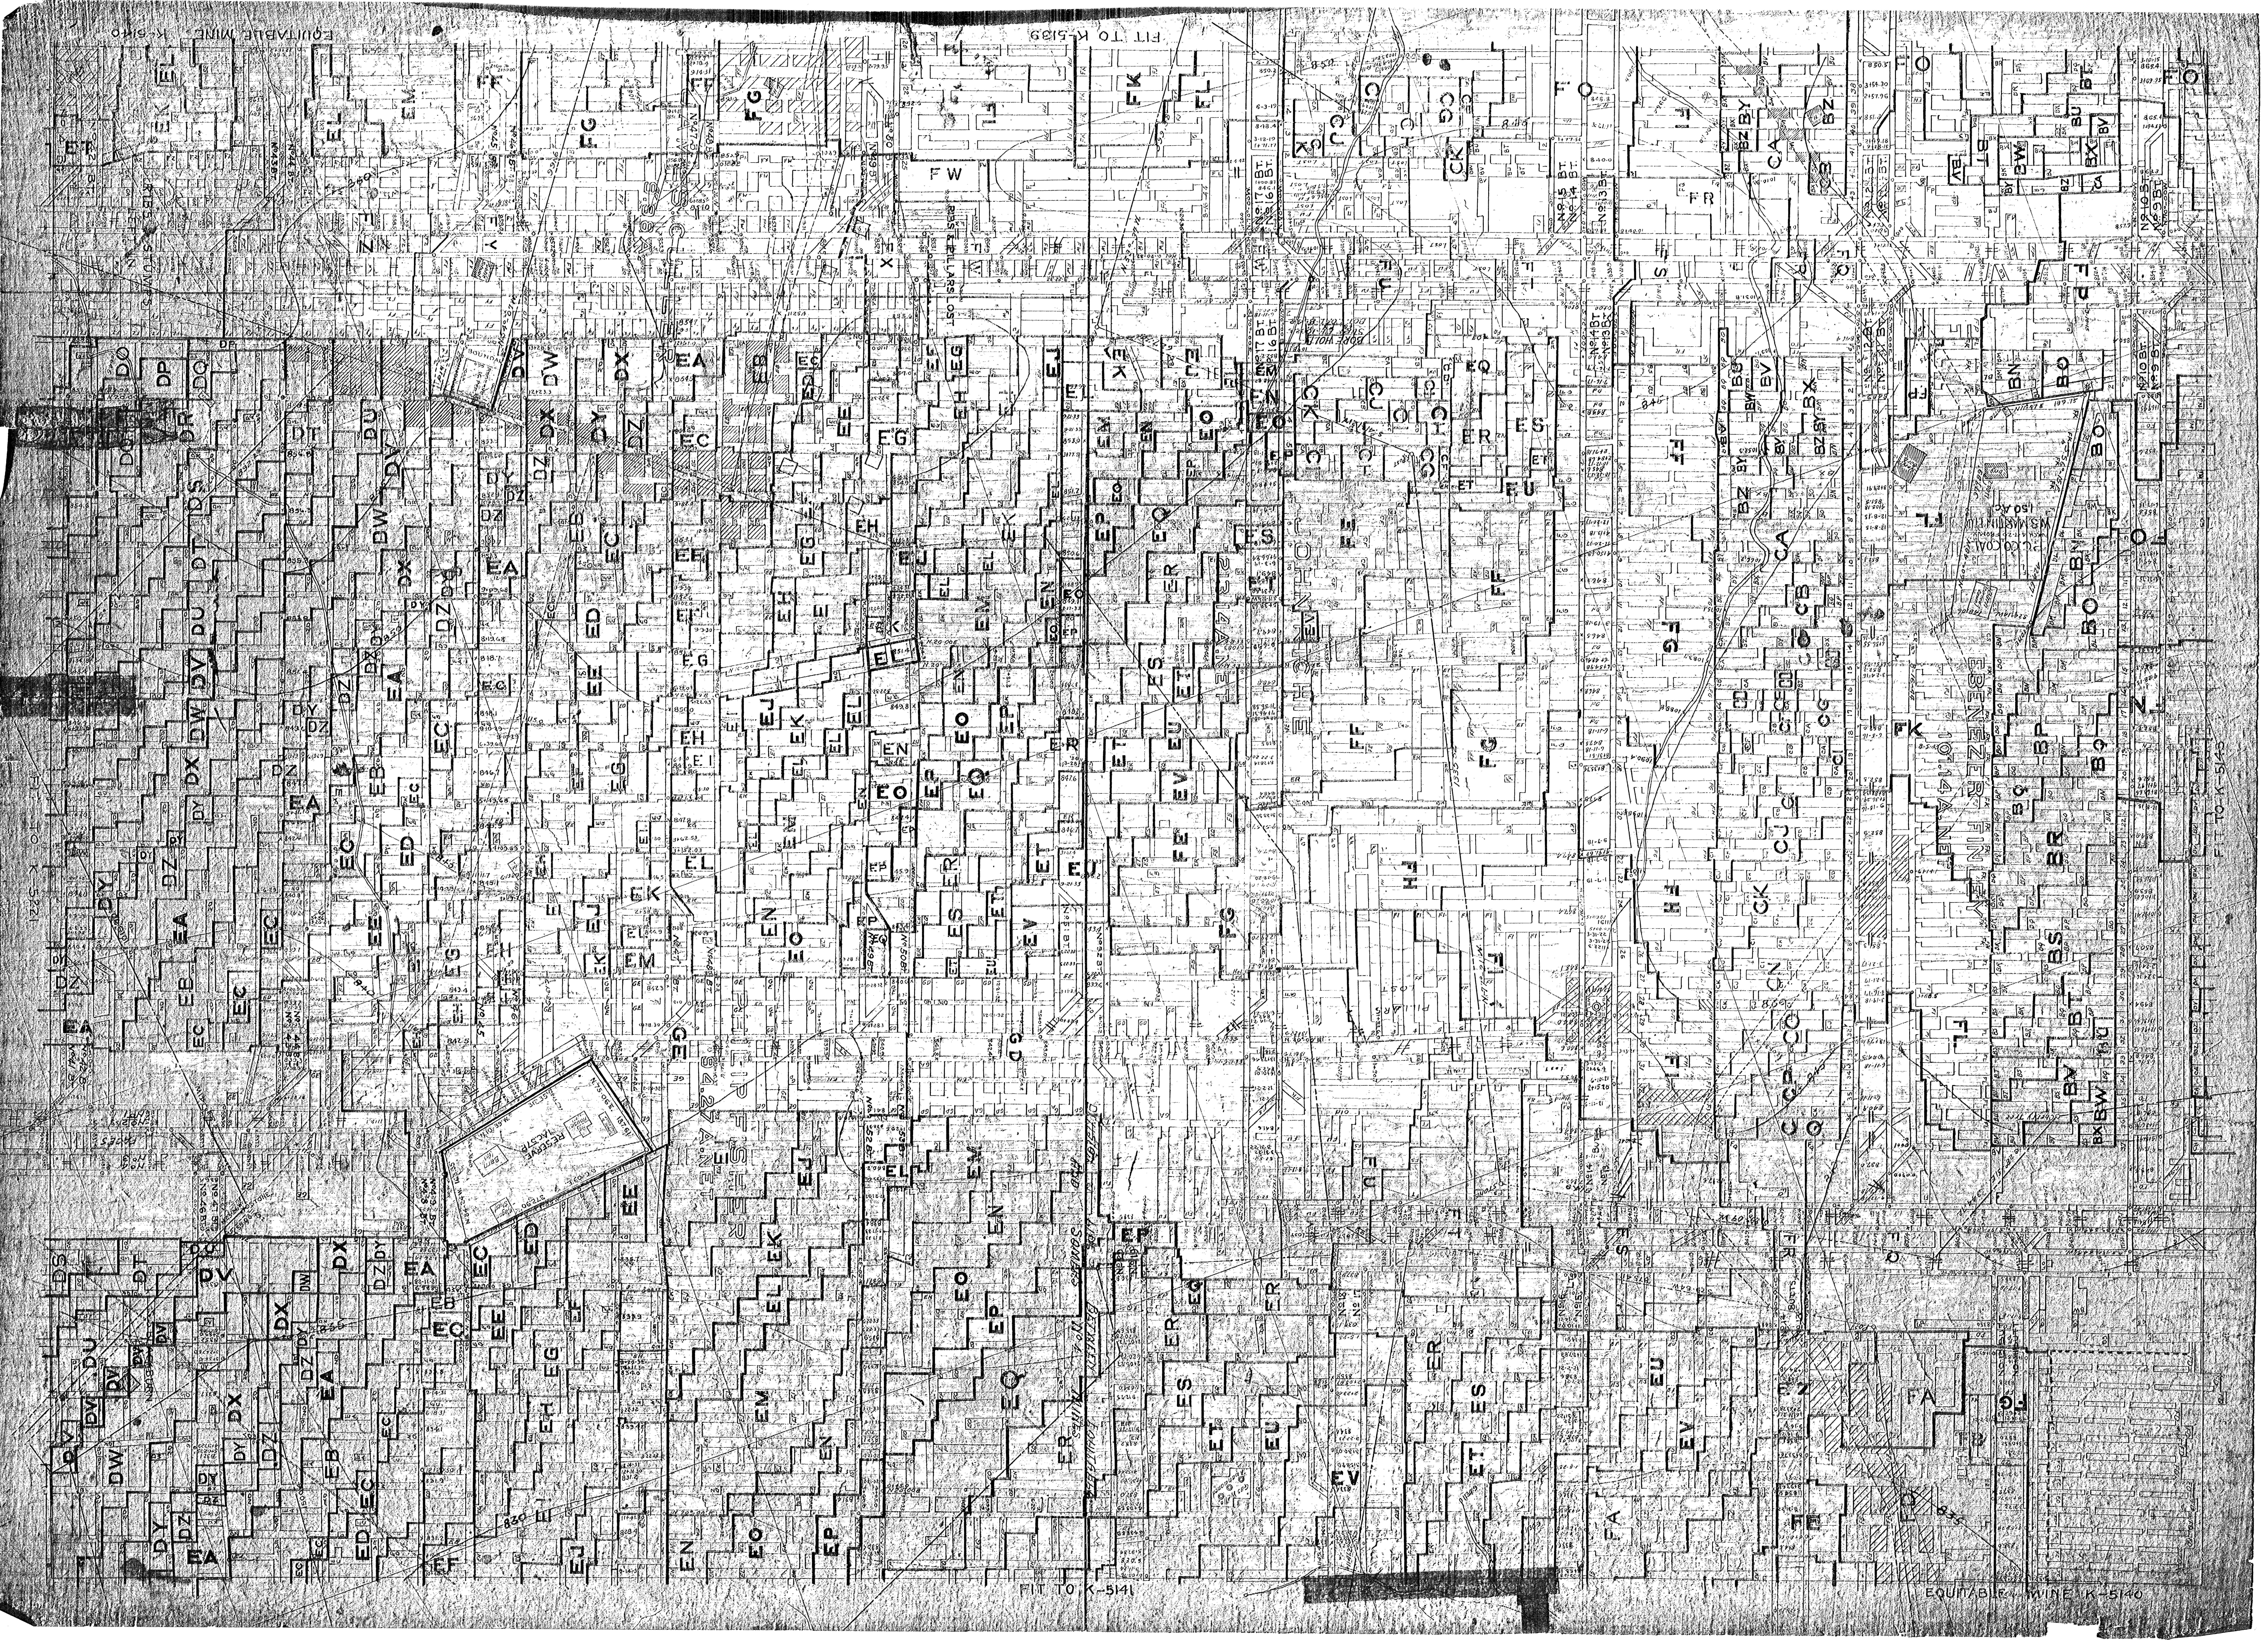

EQUATABLE WINE K-5140

FIT TO K-5140







