


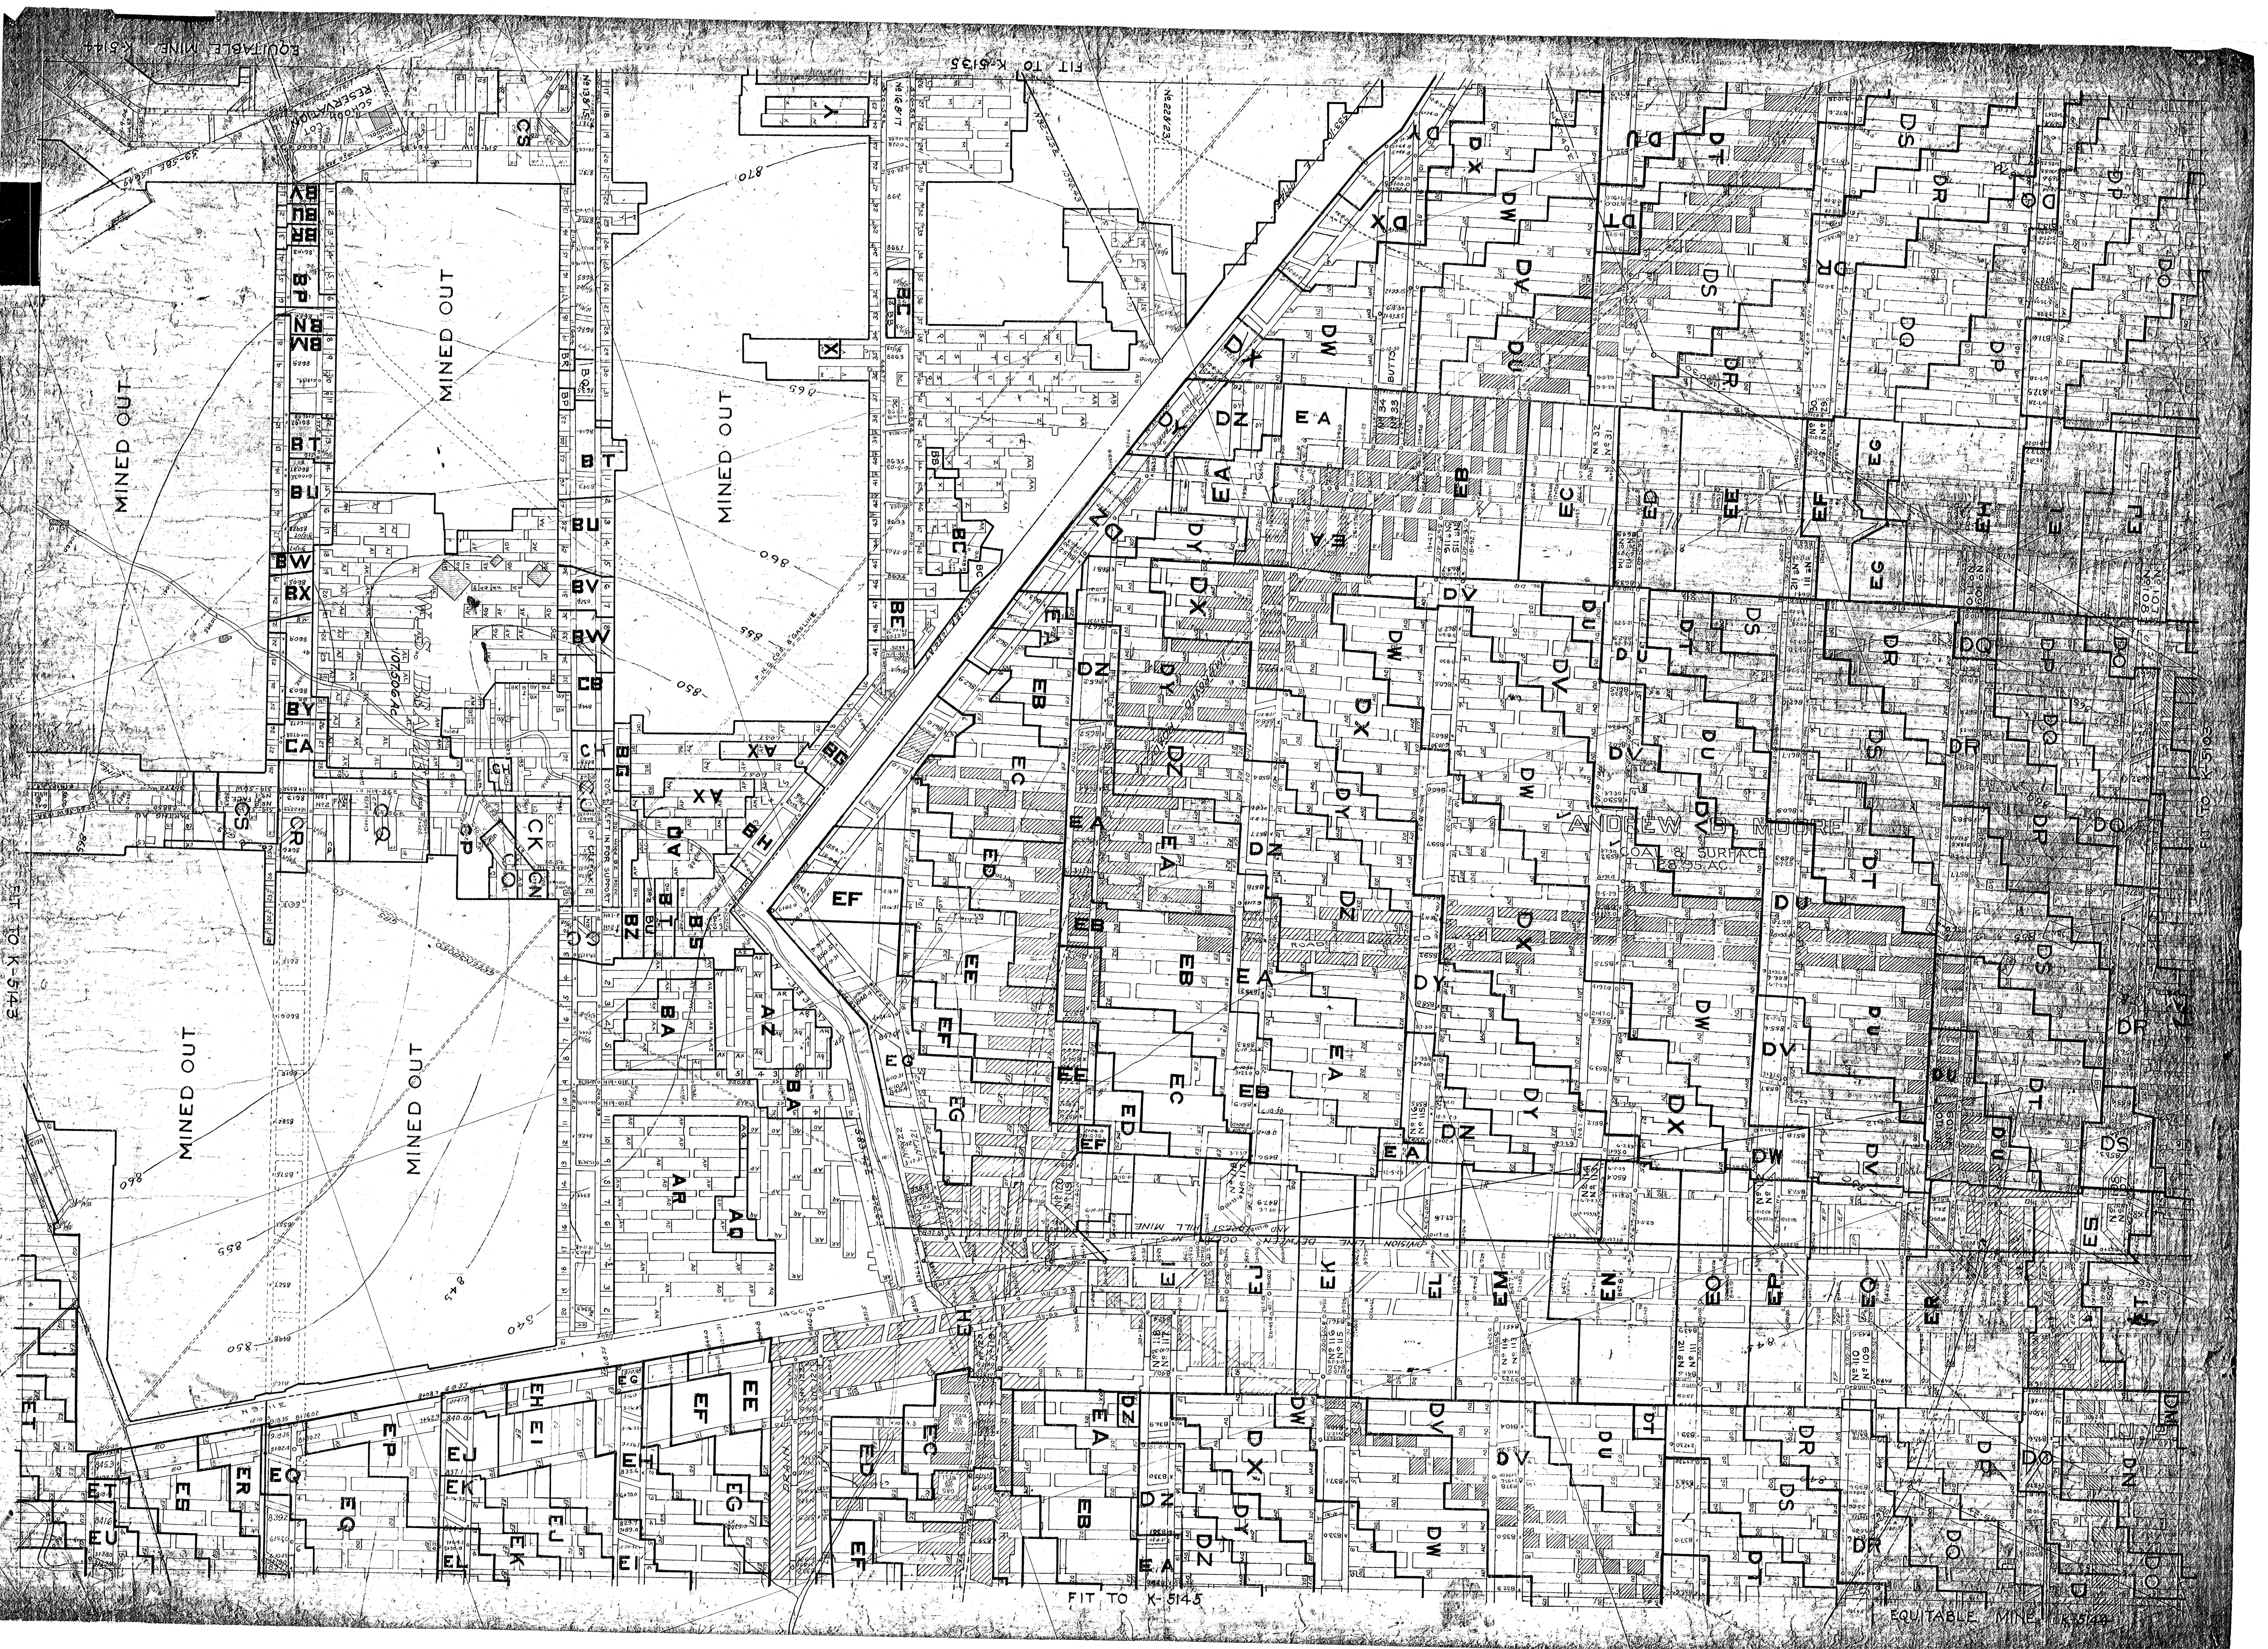

FIT TO K-5145

