


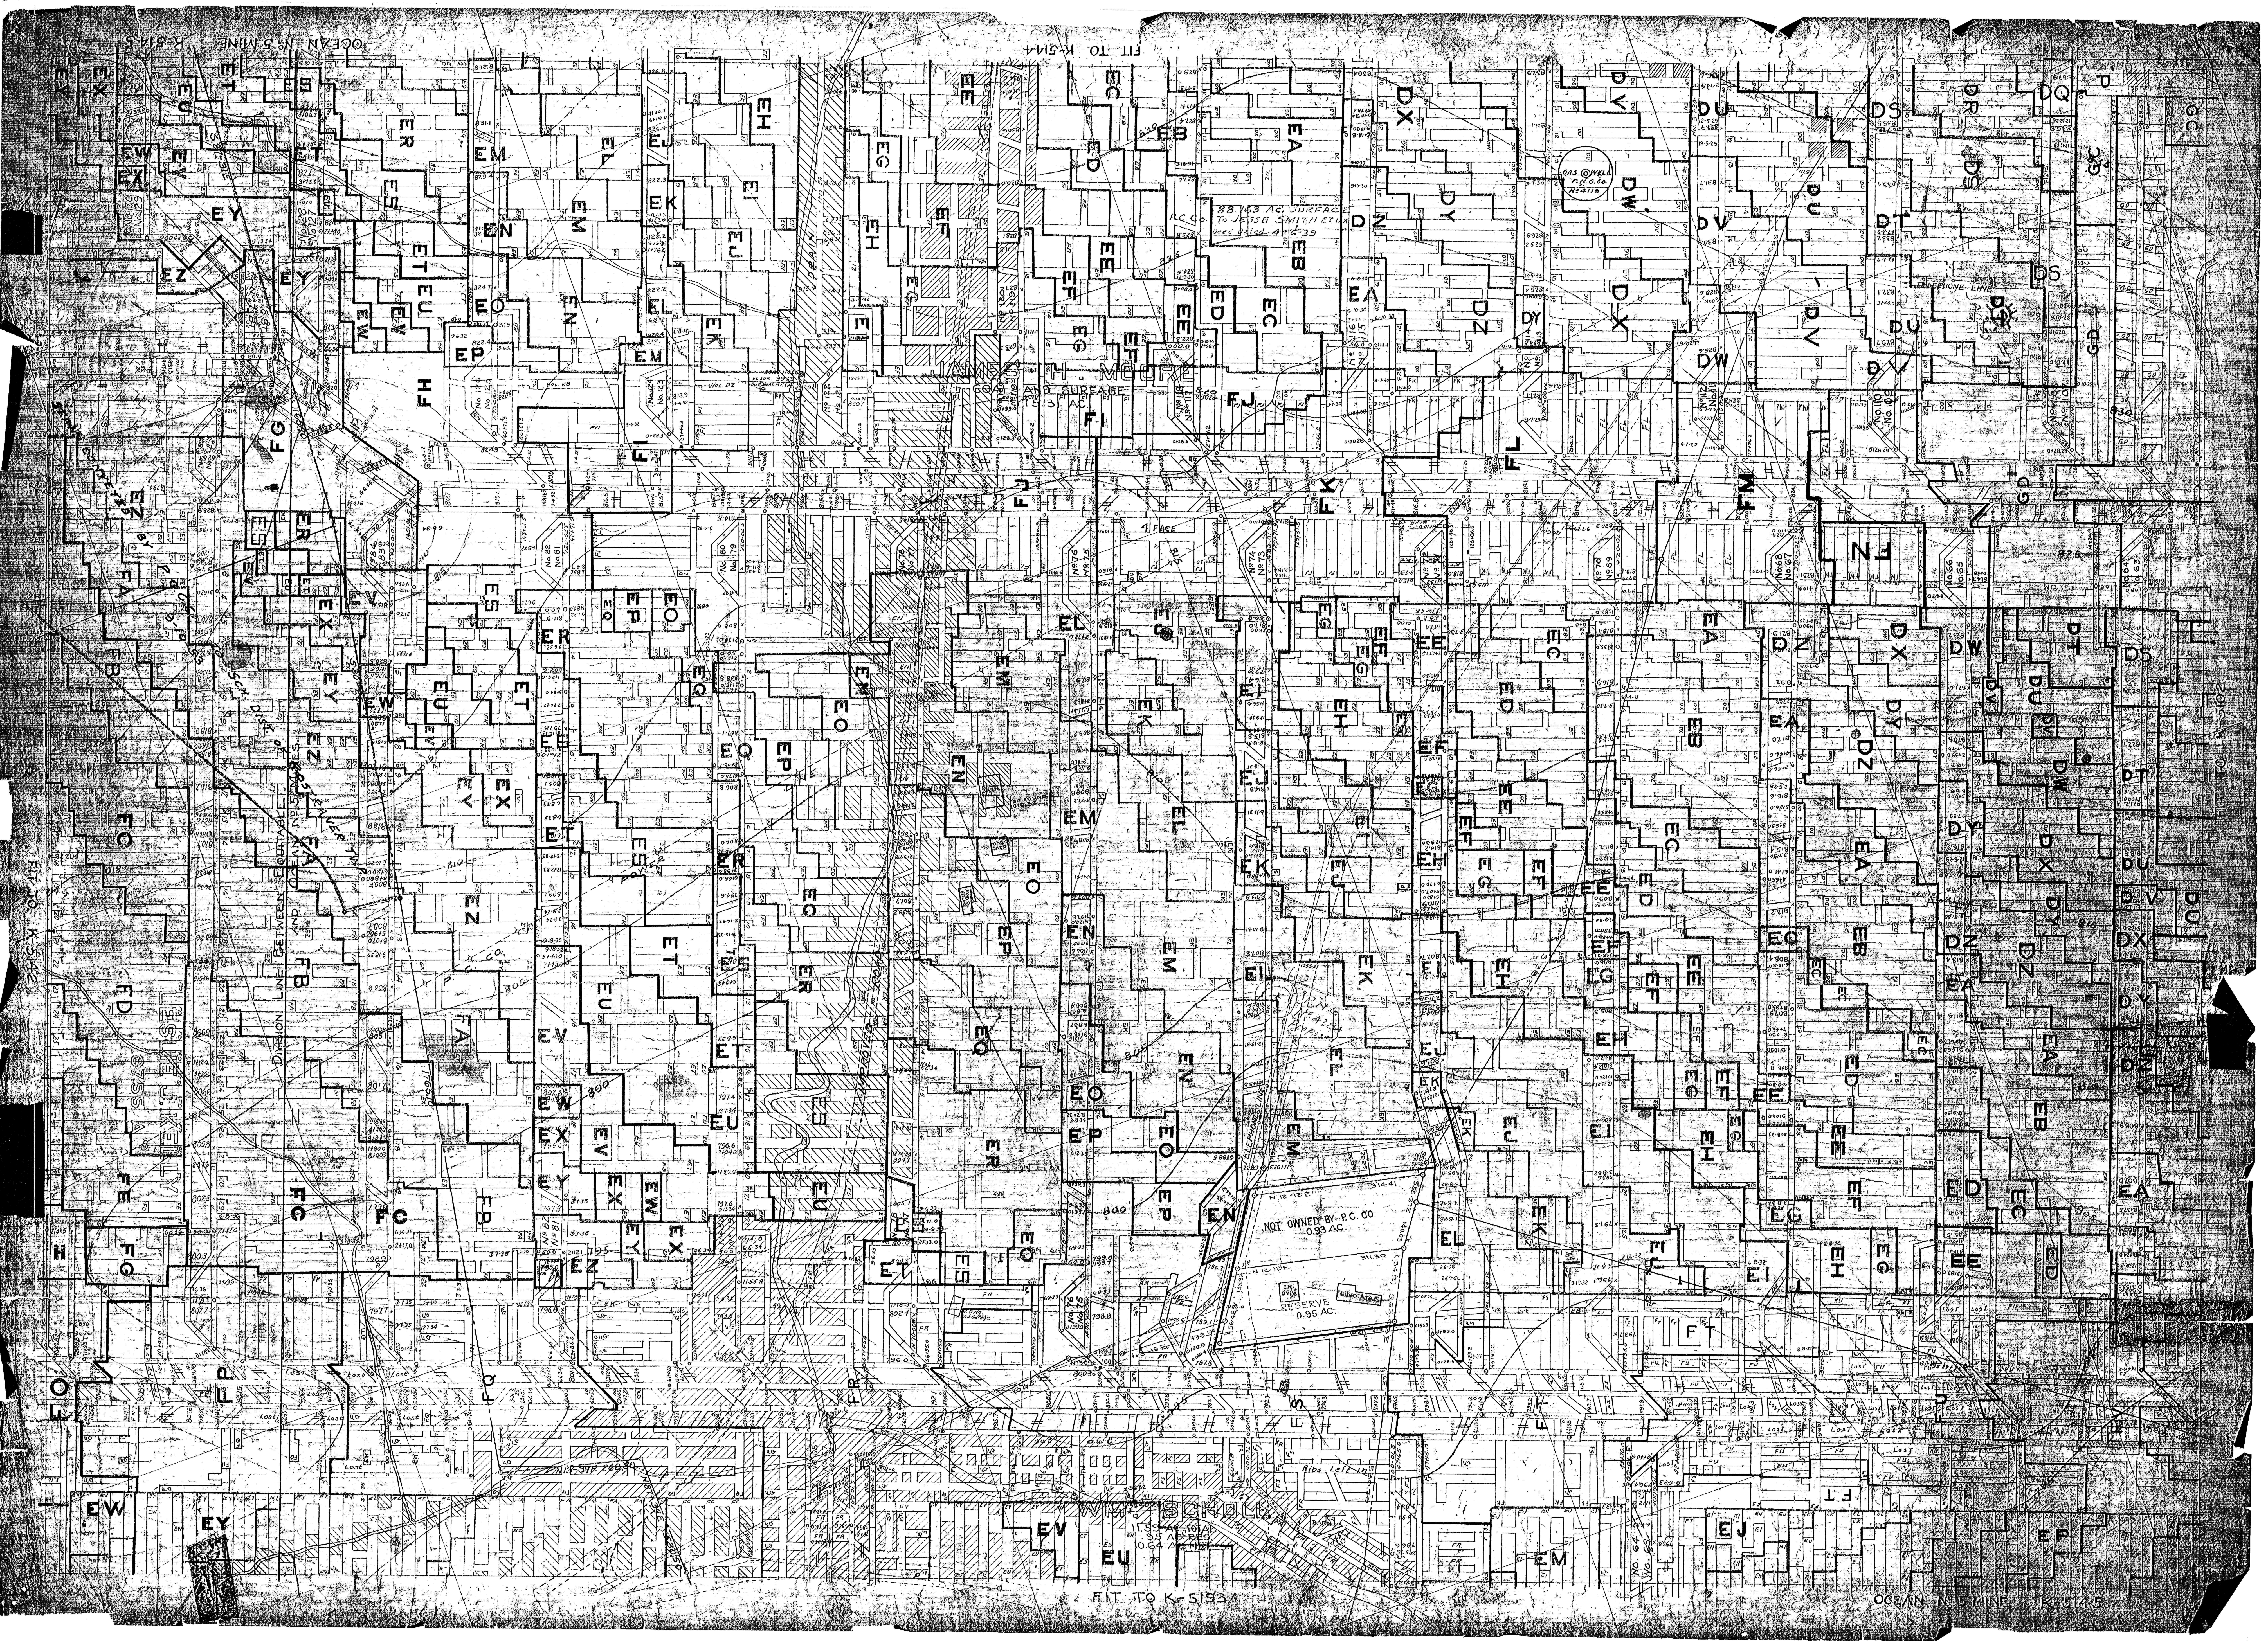

FIT TO K-5144

NOT OWNED BY P.C. CO.
0.35 AC.
RESERVE
0.35 AC.

38.43 AC. SURFACE
TO JESSE SMITH ETL
See P.L. 4-1-35

OCEAN No 5 MINE

FIT TO K-5144