


EQUITABLE MINE (WEBSTER 310)
K-5134

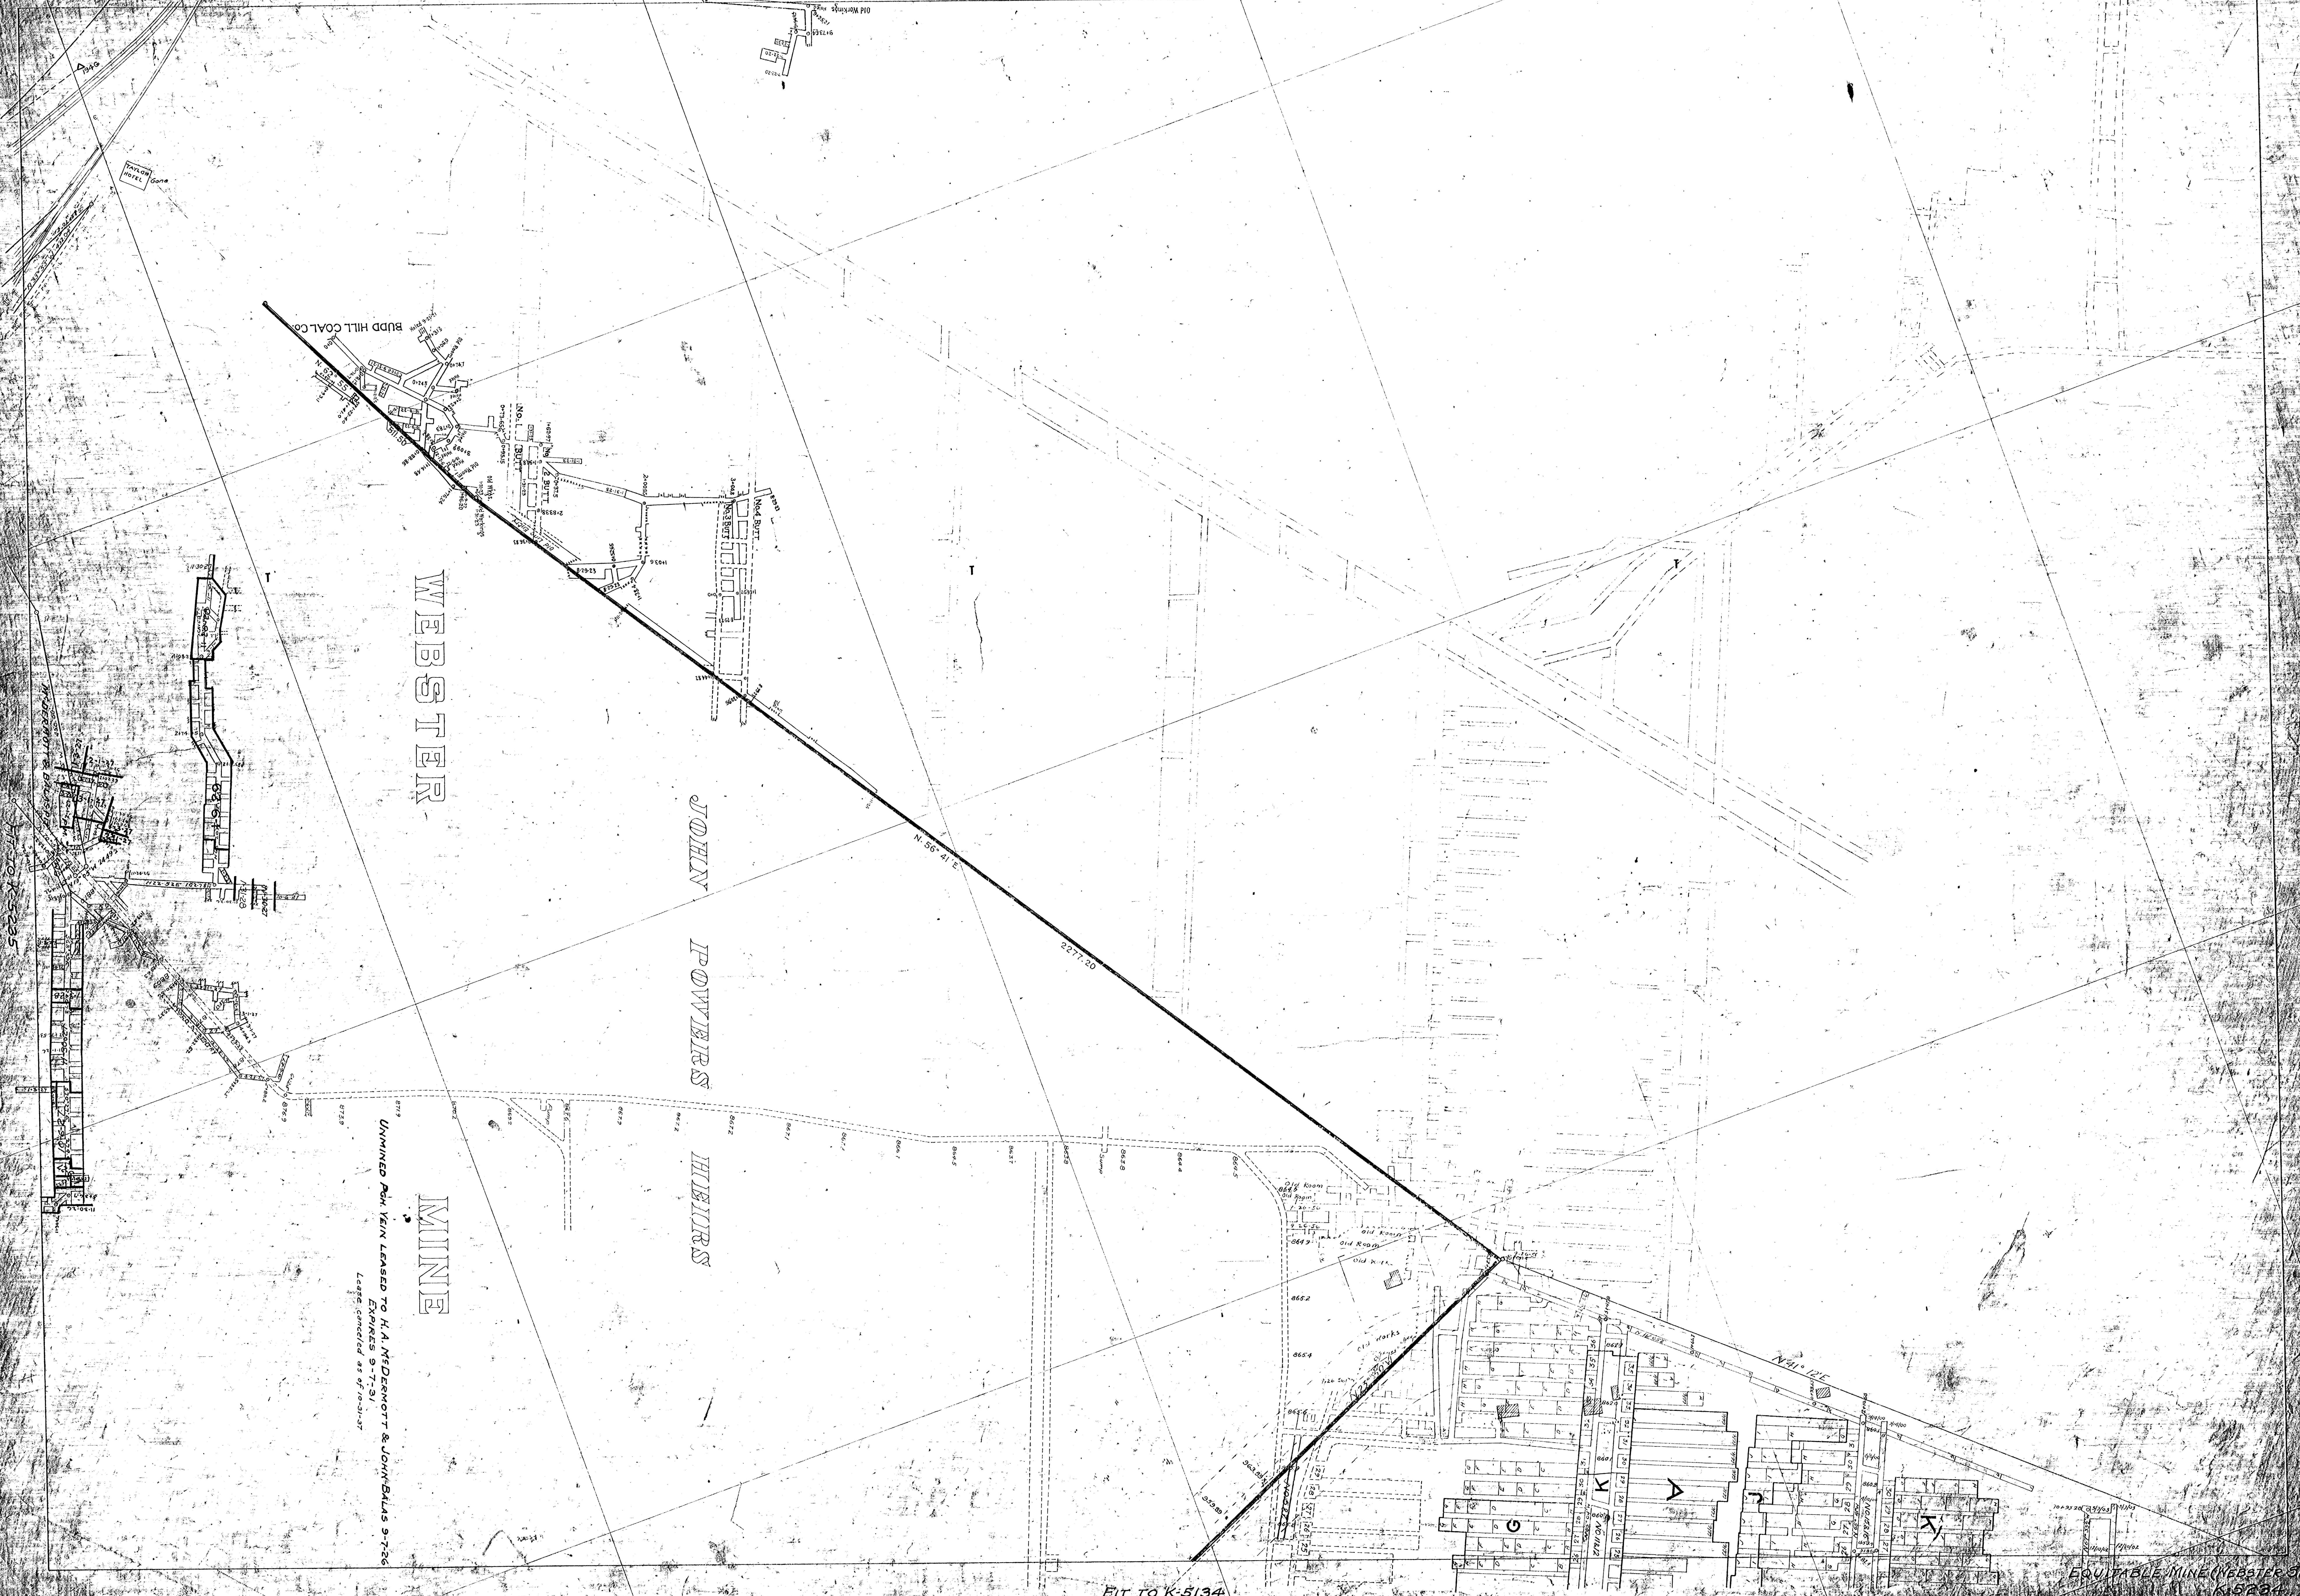

WEBSTER

JOHN POWERS HUEBRS

MINE

UNMINED PGM VEIN LEASED TO H.A. MCDERMOTT & JOHN BALAS 9-7-26
EXPIRES 9-7-31
Lease connected as of 10-1-37

FIT TO K-5134

EQUITABLE MINE (WEBSTER 310)
K-5134