


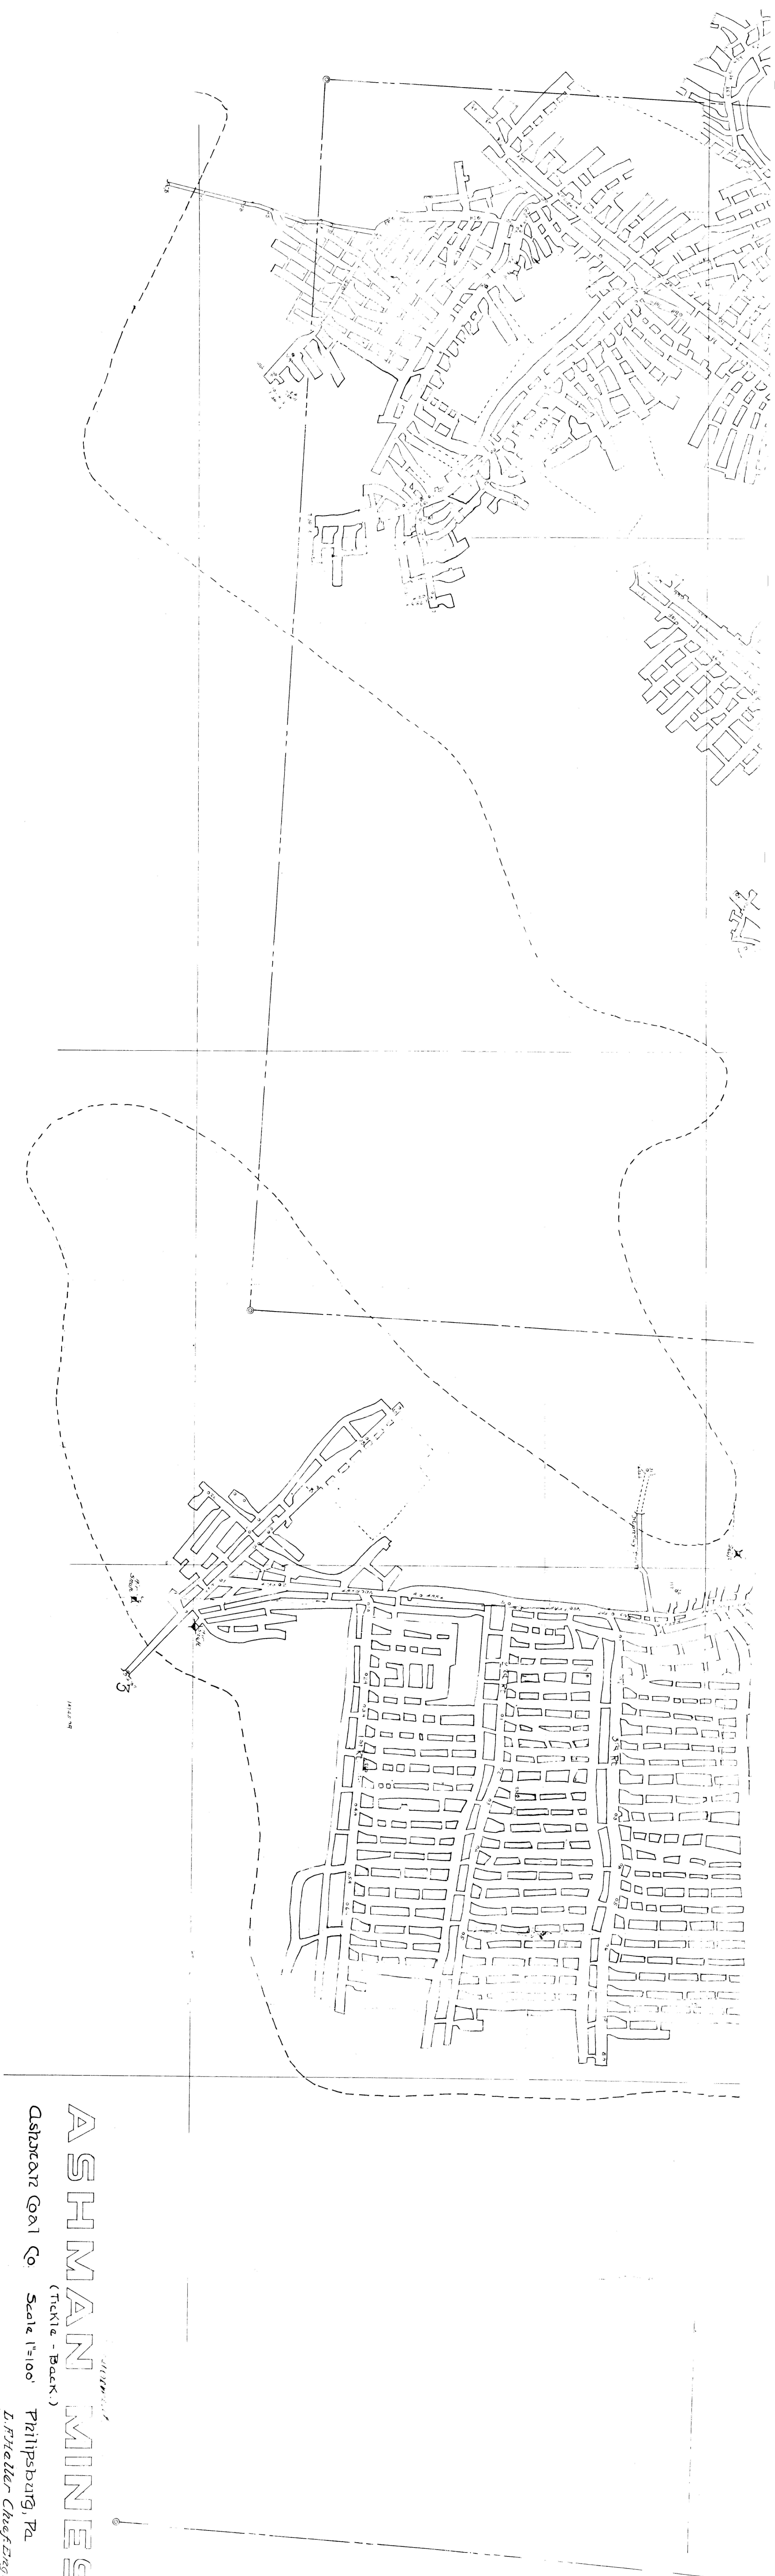

ASHMAN MINES.
(TICKLE - BACK.)
Ashman Coal Co. Scale 1"=100'
L. Pfeiffer Chief Eng.