


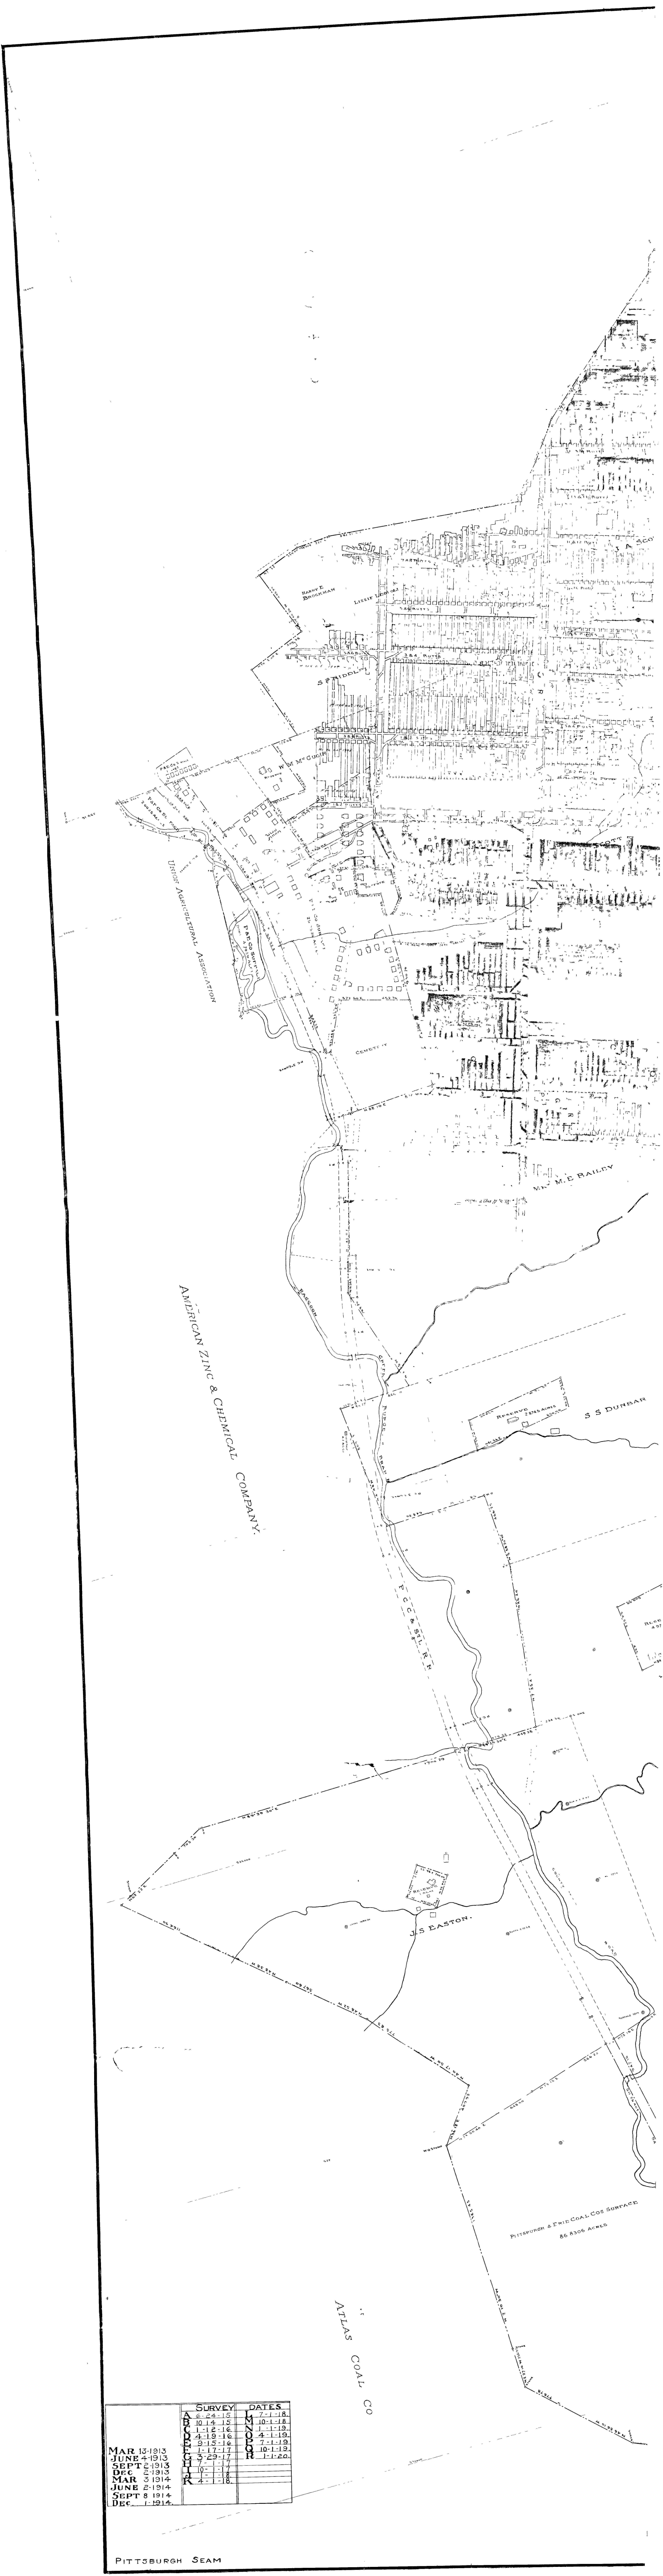

|   | SURVEY  | DATES   |
|---|---------|---------|
| A | 6-24-15 | 7-1-18  |
| B | 10-1-15 | 10-1-18 |
| C | 1-1-16  | 1-1-19  |
| D | 4-1-16  | 4-1-19  |
| E | 9-1-16  | 7-1-19  |
| F | 1-17-17 | 10-1-19 |
| G | 5-29-17 | 1-1-20  |
| H | 10-1-18 |         |
| I | 4-1-18  |         |
| J |         |         |
| K |         |         |
| L |         |         |
MAR 13-1913  
JUNE 4-1913  
SEPT 2-1913  
DEC 5-1913  
MAR 5-1914  
JUNE 2-1914  
SEPT 8-1914  
DEC 1-1914