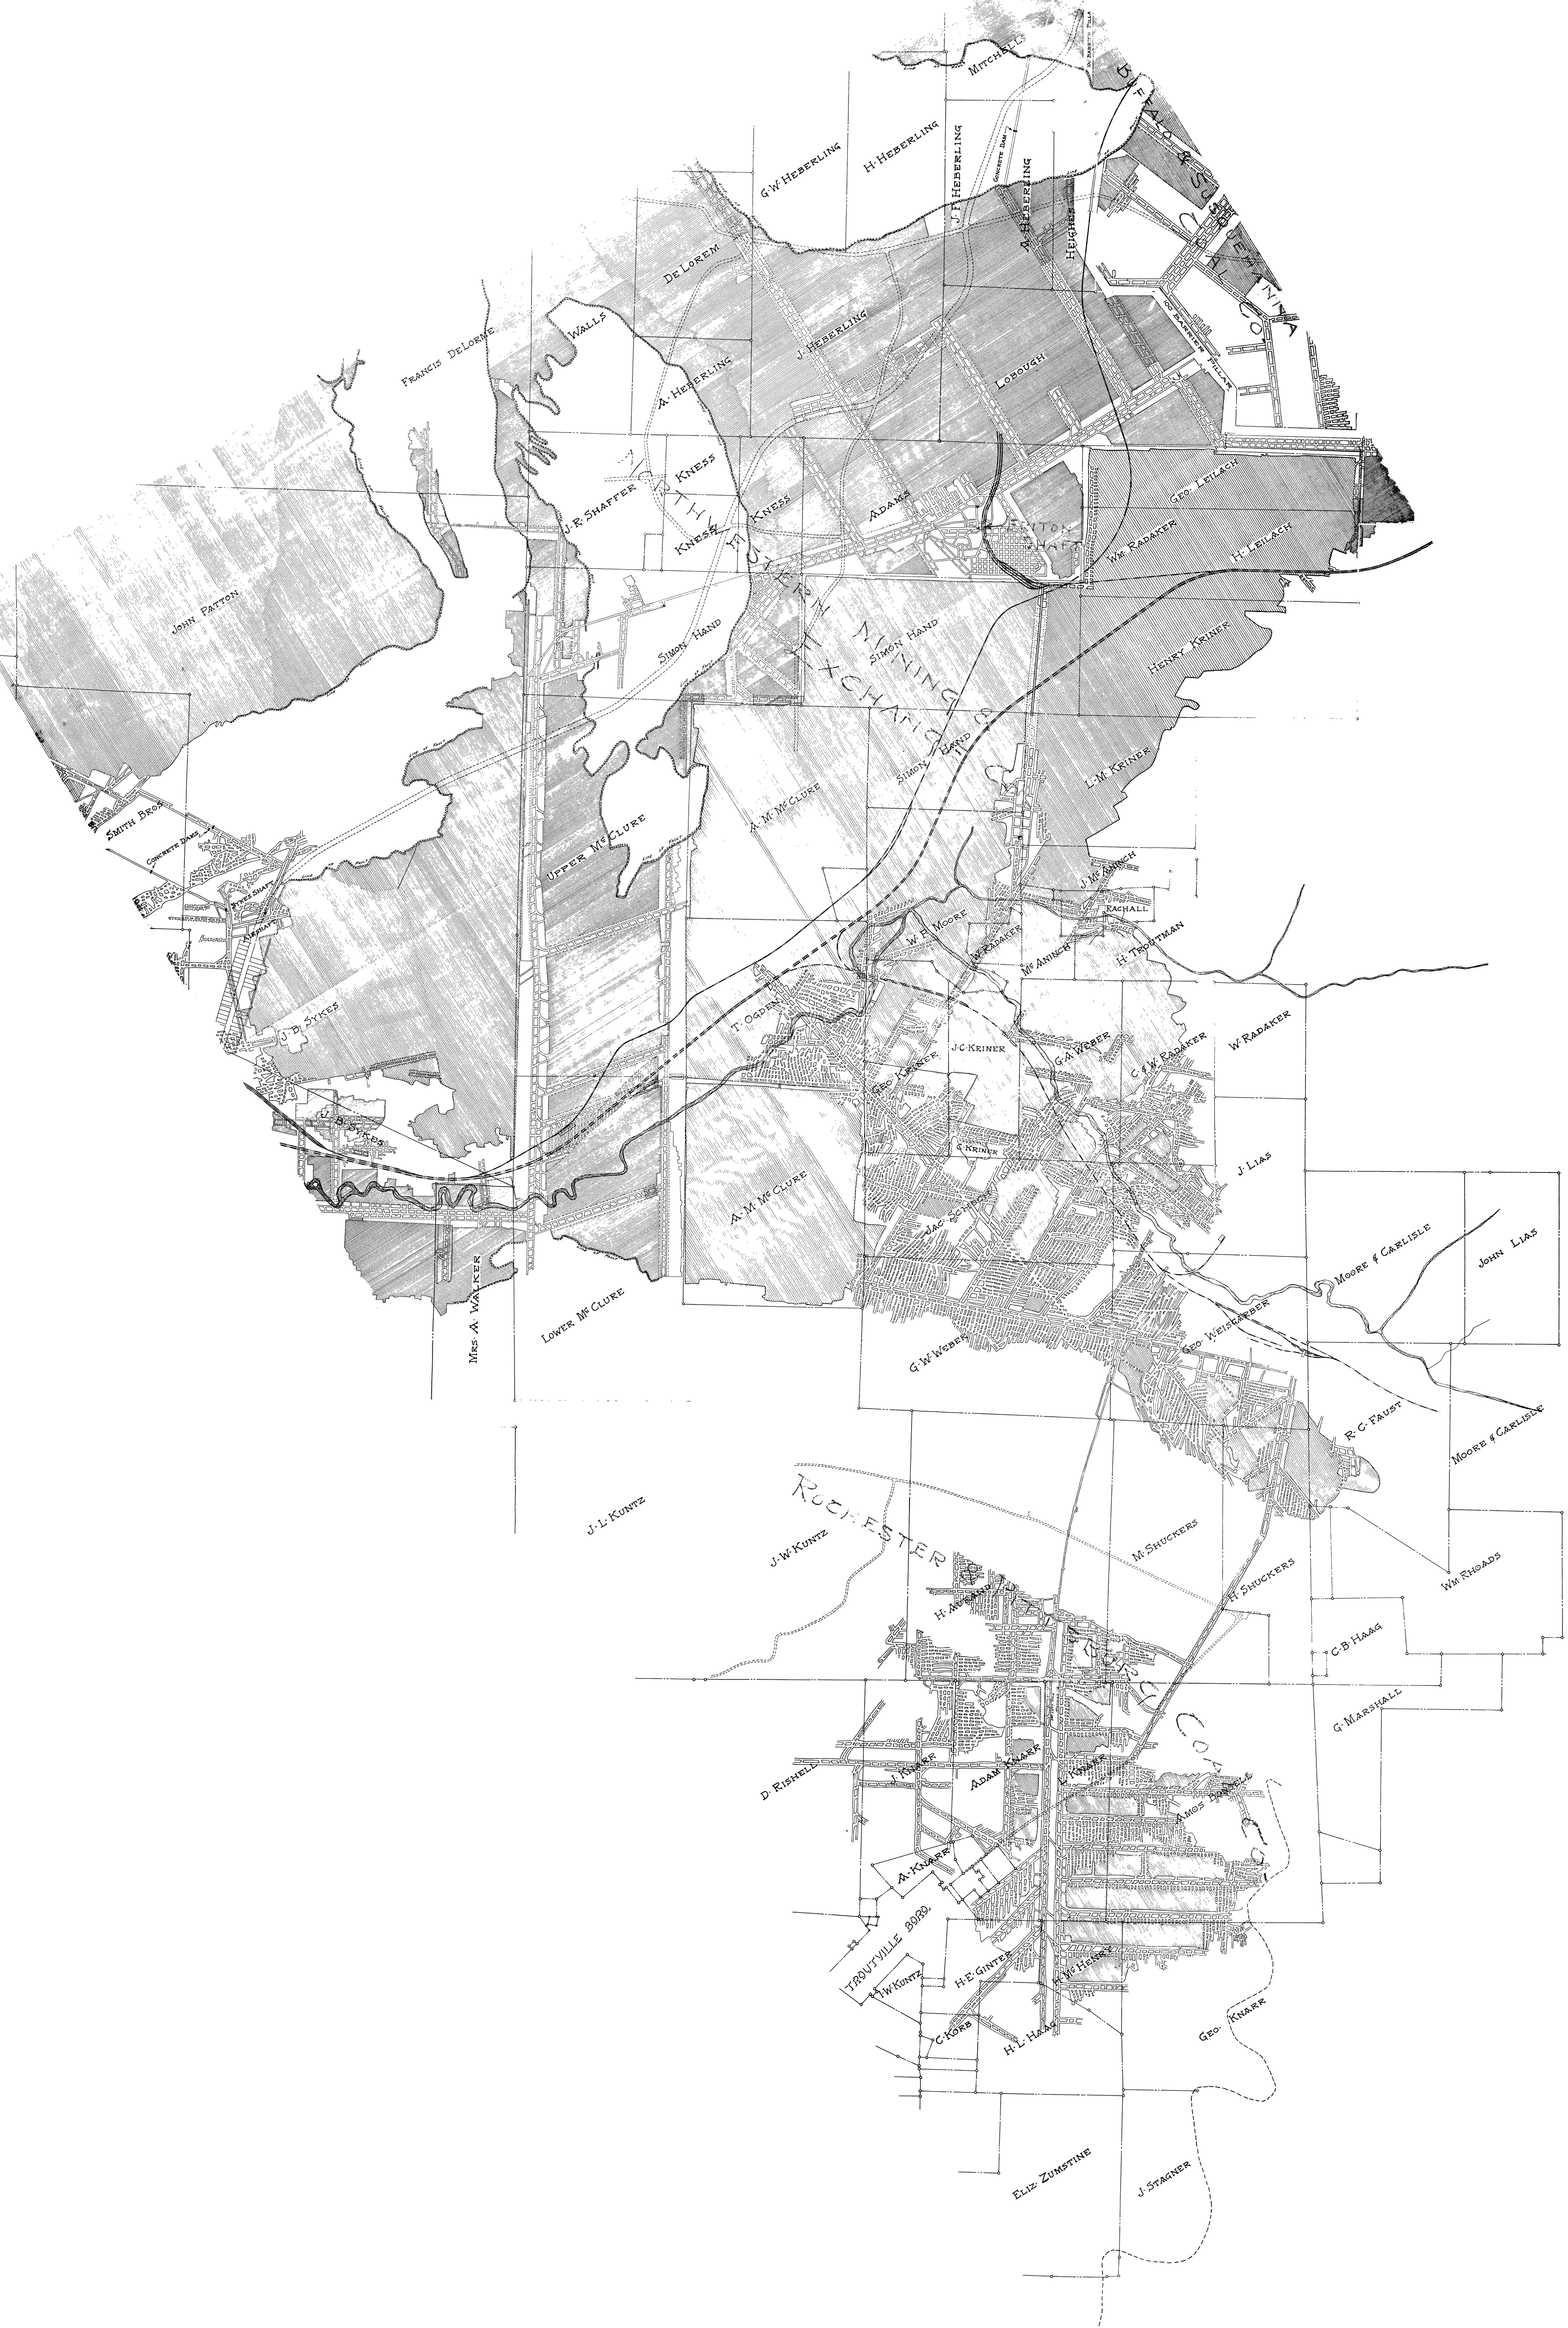
Mitchell
100 Barrier Pillar
Buffalo & Susquehanna Coal Co.
G. W. Heberling
H. Heberling
J. F. Heberling
Concrete Dam
A. Heberling
Heights
De Lorem
Francis DeLorme
Walls
A. Heberling
J. Heberling
Lobough
100 Barrier Pillar
Northwestern Mining & Exchange Co.
Kness
Kness
Kness
J. R. Shaffer
Adams
Eriton Shaft
Geo. Leilach
Wm. Radaker
H. Leilach
John Patton
Simon Hand
Simon Hand
Simon Hand
Henry Kriner
L. M. Kriner
Line of Fault
Smith Bros.
Concrete Dams
Sykes Shaft
Airshaft
Upper McClure
A. M. McClure
J. McAninch
Rachall
H. Troutman
W. F. Moore
W. Radaker
McAninch
J. B. Sykes
T. Ogden
J. C. Kriner
Geo. Kriner
G. A. Weber
C. & W. Radaker
W. Radaker
C. Kriner
J. Lias
Jac. Schoch
A. M. McClure
Moore & Carlisle
John Lias
Mrs. A. Walker
Lower McClure
G. W. Weber
Geo. Weisgarber
R. C. Faust
Moore & Carlisle
J. L. Kuntz
J. W. Kuntz
Rochester & Pittsburg Coal Co.
M. Shuckers
H. Shuckers
Wm. Rhoads
H. Auckland
C. B. Haag
G. Marshall
D. Rishell
J. Knarr
Adam Knarr
L. Knarr
Amos Doncel
A. Knarr
Troutville Boro.
J. W. Kuntz
H. E. Ginter
H. McHenry
C. Korb
H. L. Haag
Geo. Knarr
Eliz. Zumstine
J. Stagner
N

Northwestern Mining & Exchange Co.

Map of

Eriton Mine No. 61.

Relative to

Helvetia & Stanley Mines- Clearfield Co. Pa.

Peabody Coal Co. — Chicago, Illinois

Office of Chief Eng'r. — Du Bois, Penna.

Scale 1-inch = 400 Ft.

Dec. 31- 1925

STATE OF:- PENNSYLVANIA
COUNTY OF:- CLEARFIELD

I, JOHN H NAGLE, BEING DULY SWORN, DEPOSE AND SAY THAT I AM THE CHIEF ENGINEER OF THE NORTHWESTERN MINING AND EXCHANGE CO. AND THAT THIS 400FT. TO 1-INCH MAP OF ERITON MINE BELONGING TO THE NORTHWESTERN MINING AND EXCHANGE CO. AND ADJOINING MINES OF THE ROCHESTER AND PITTSBURG COAL CO. LEASED TO THE NORTHWEST MINING AND EXCHANGE CO. IN CLEARFIELD AND JEFFERSON COUN WHICH [illegible] ABANDONED, IS CORRECT AND TRUE TO THE BEST [illegible] KNOWLEDGE AND BELIEF.

SIGNED:- John H. Nagle

SWORN TO BEFORE ME THIS 29 DAY OF June, 1929

L. A. McC[illegible] NOTARY PUBLIC

NOTARY PUBLIC
MY COMMISSION EXPIRES
MARCH 7, 193[illegible]