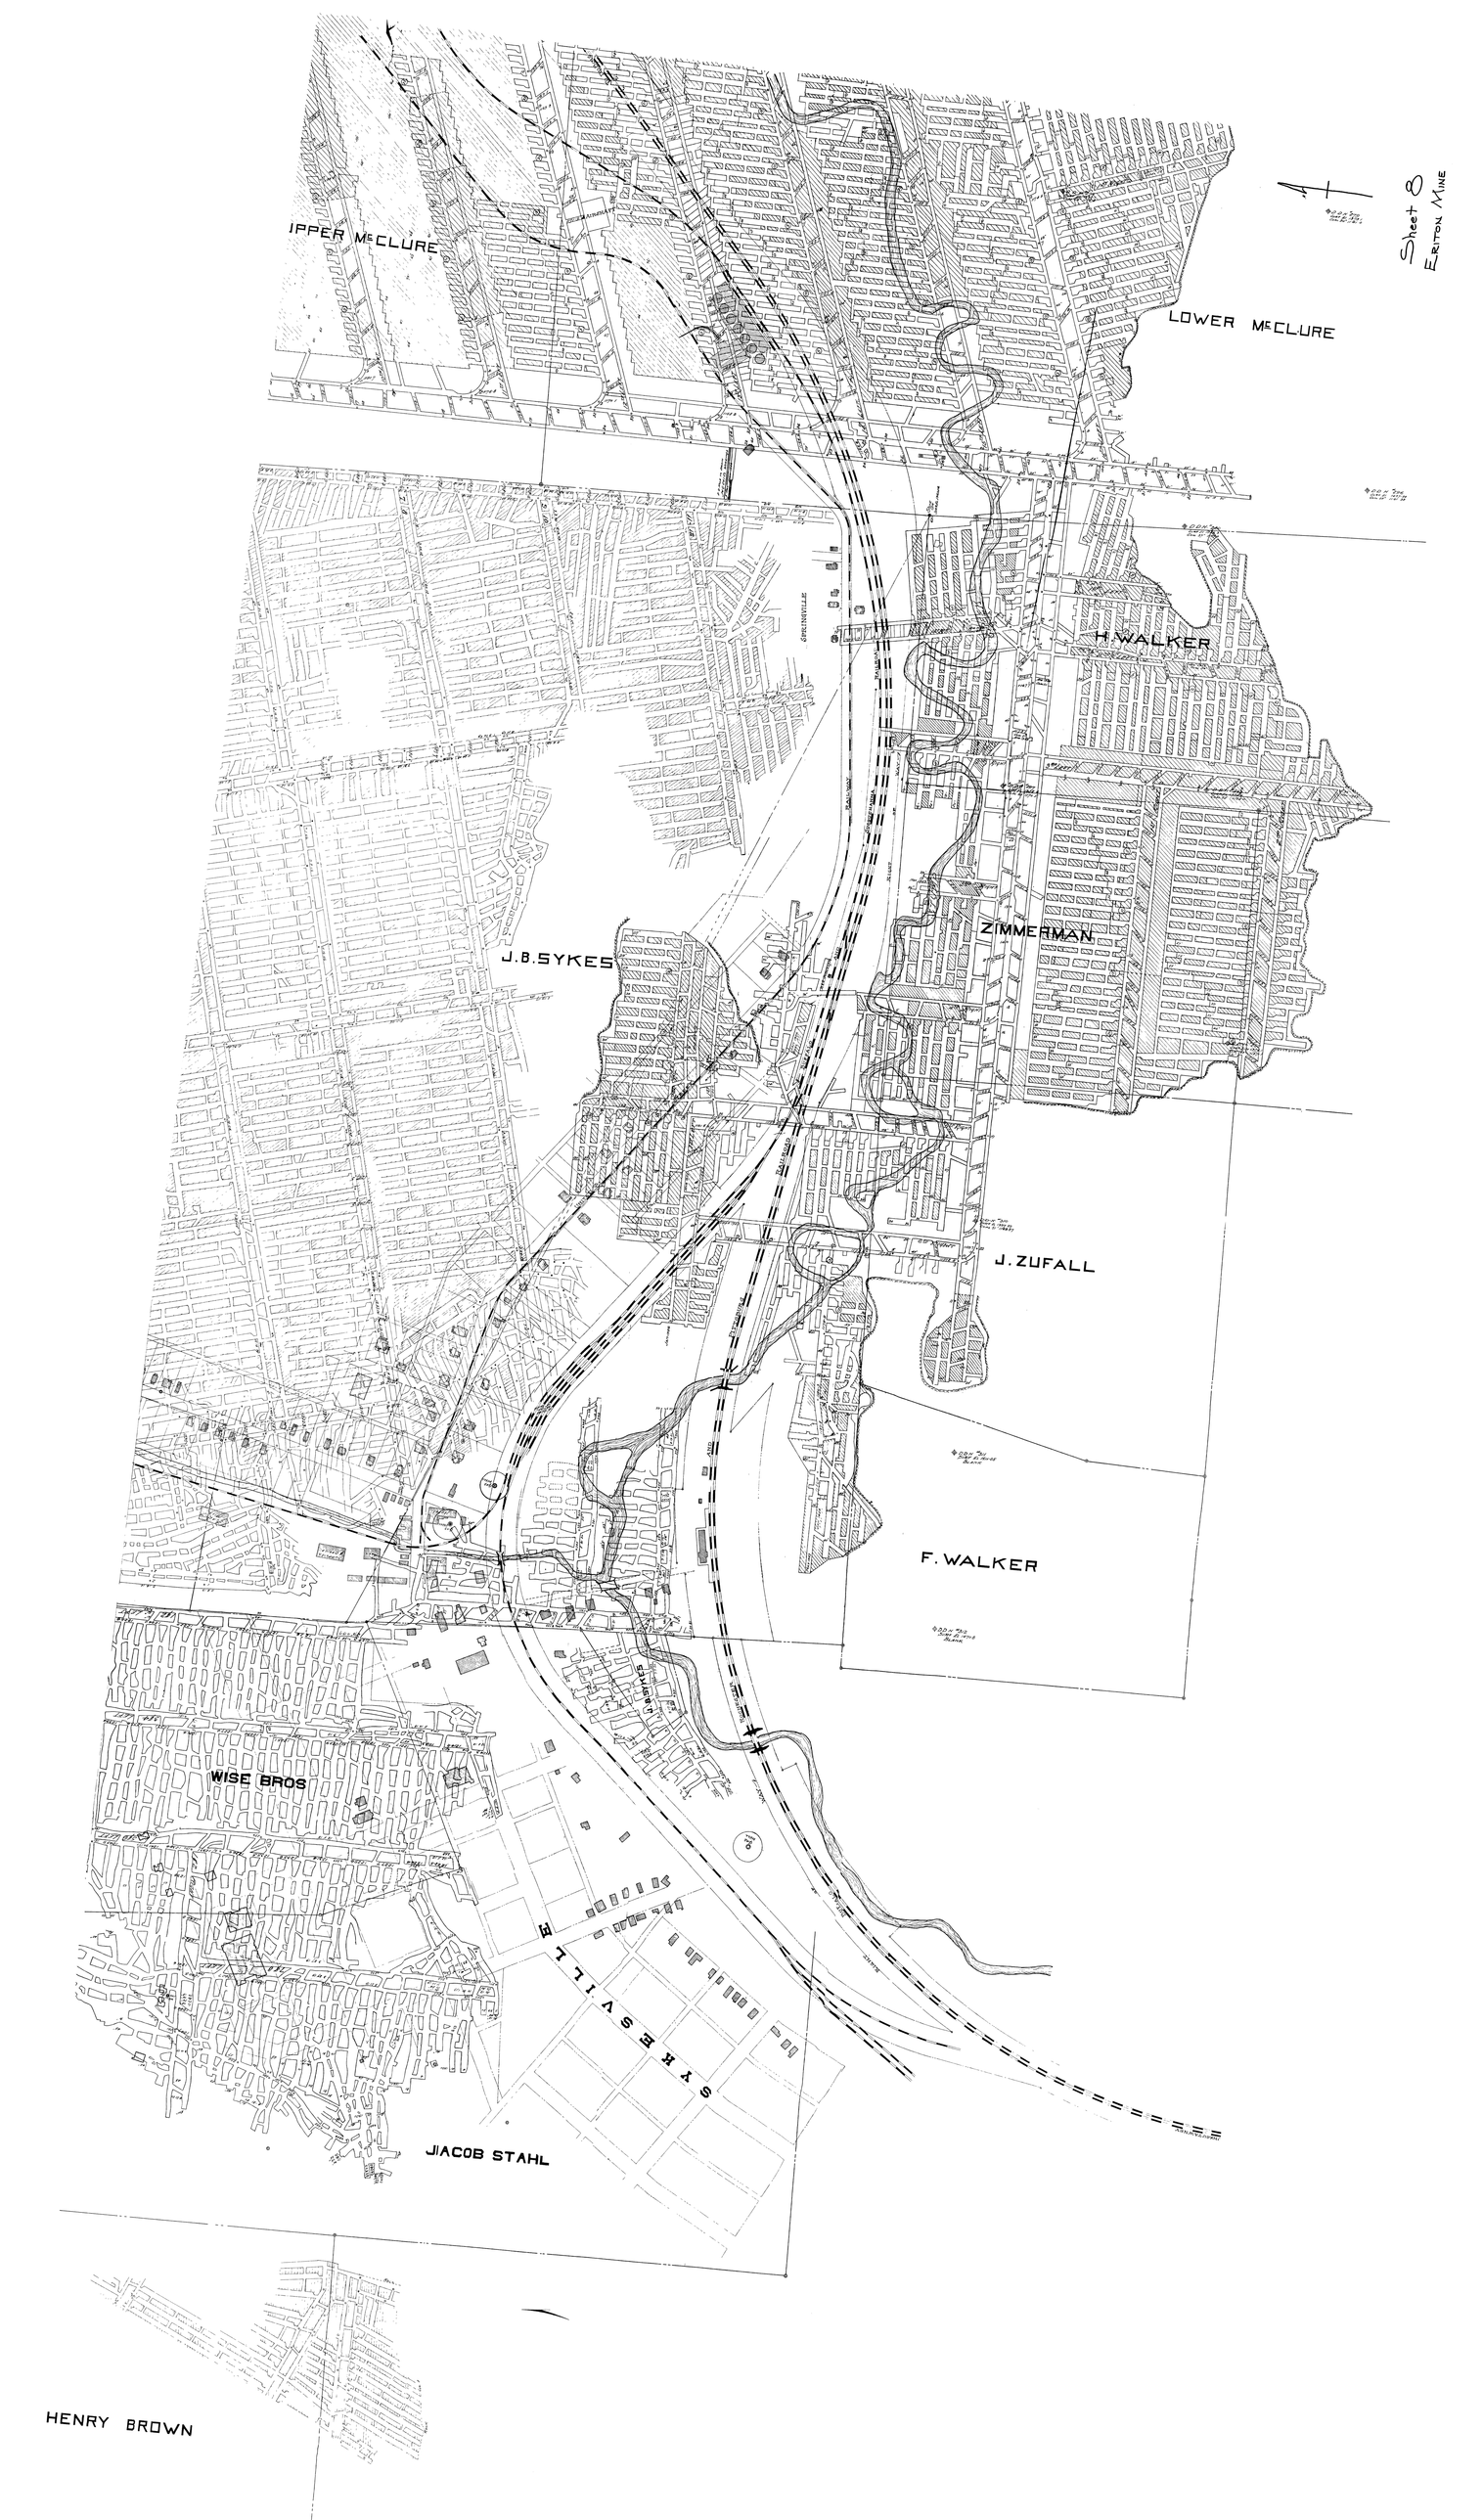
Sheet 8
UPPER McCLURE
LOWER McCLURE
H.WALKER
ZIMMERMAN
J.B.SYKES
J.ZUFALL
F.WALKER
WISE BROS
SYKESVILLE
JIACOB STAHL
HENRY BROWN