


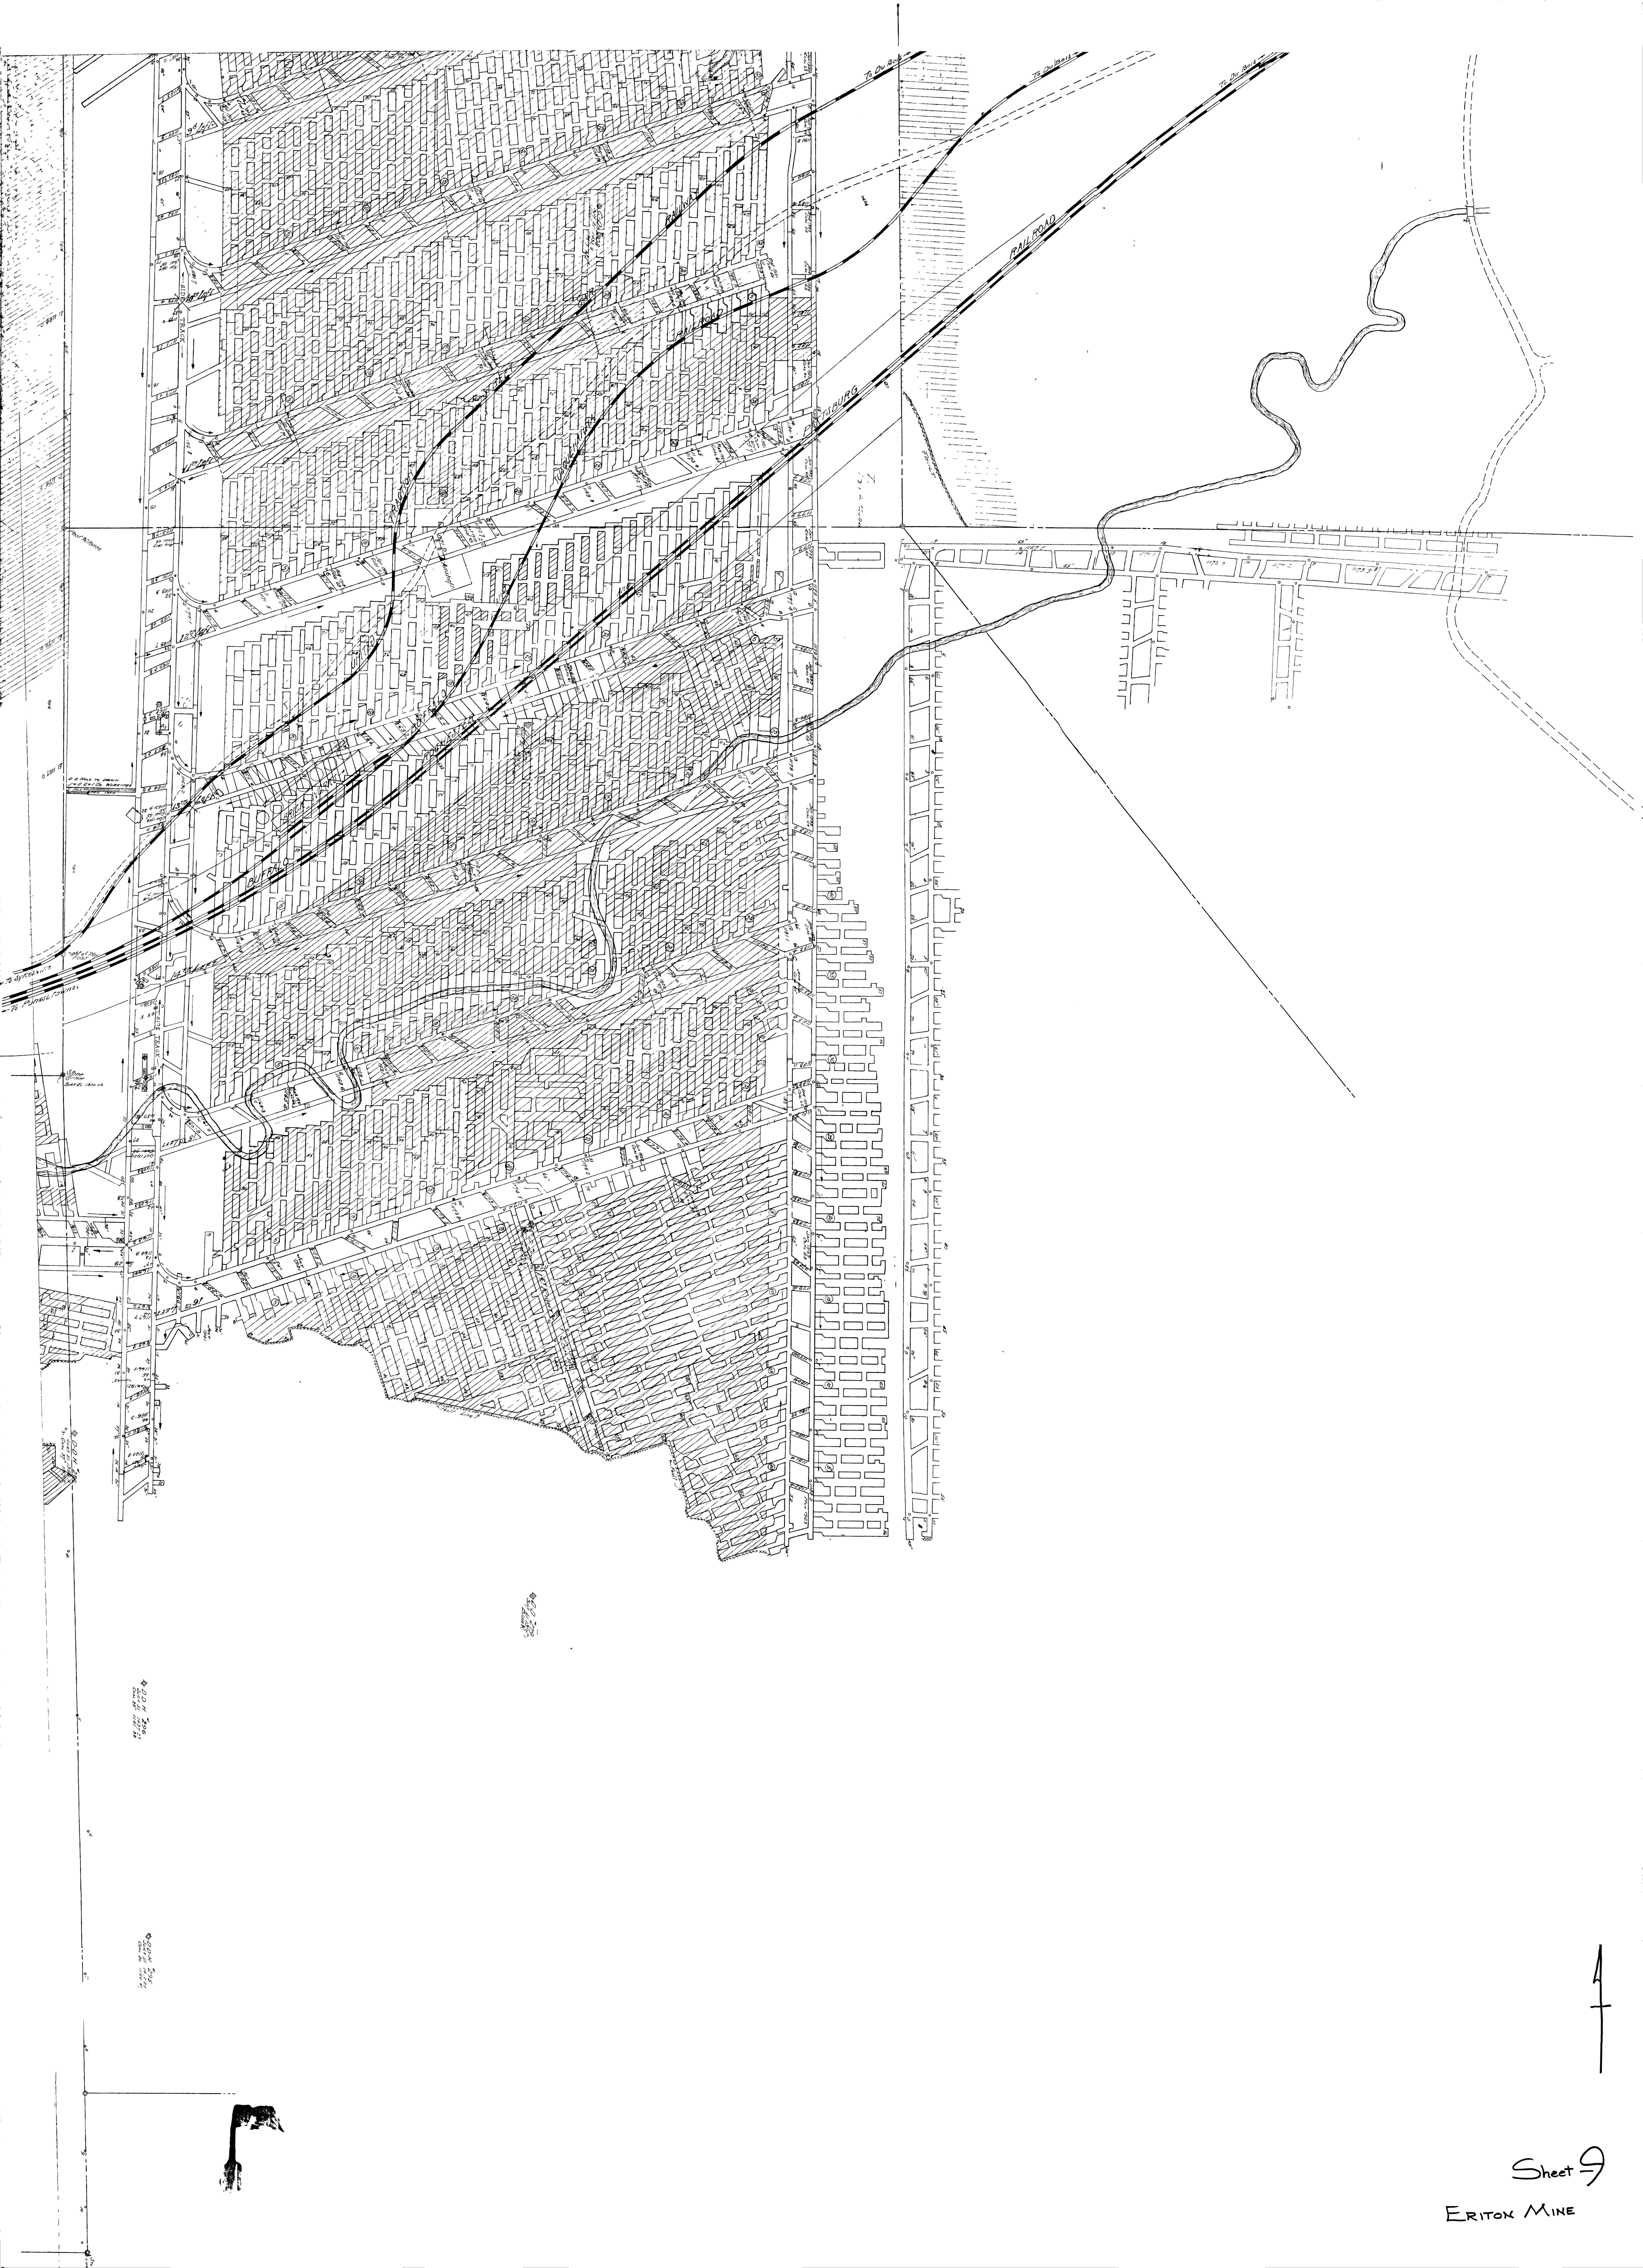

Sheet 9

ERITON MINE