


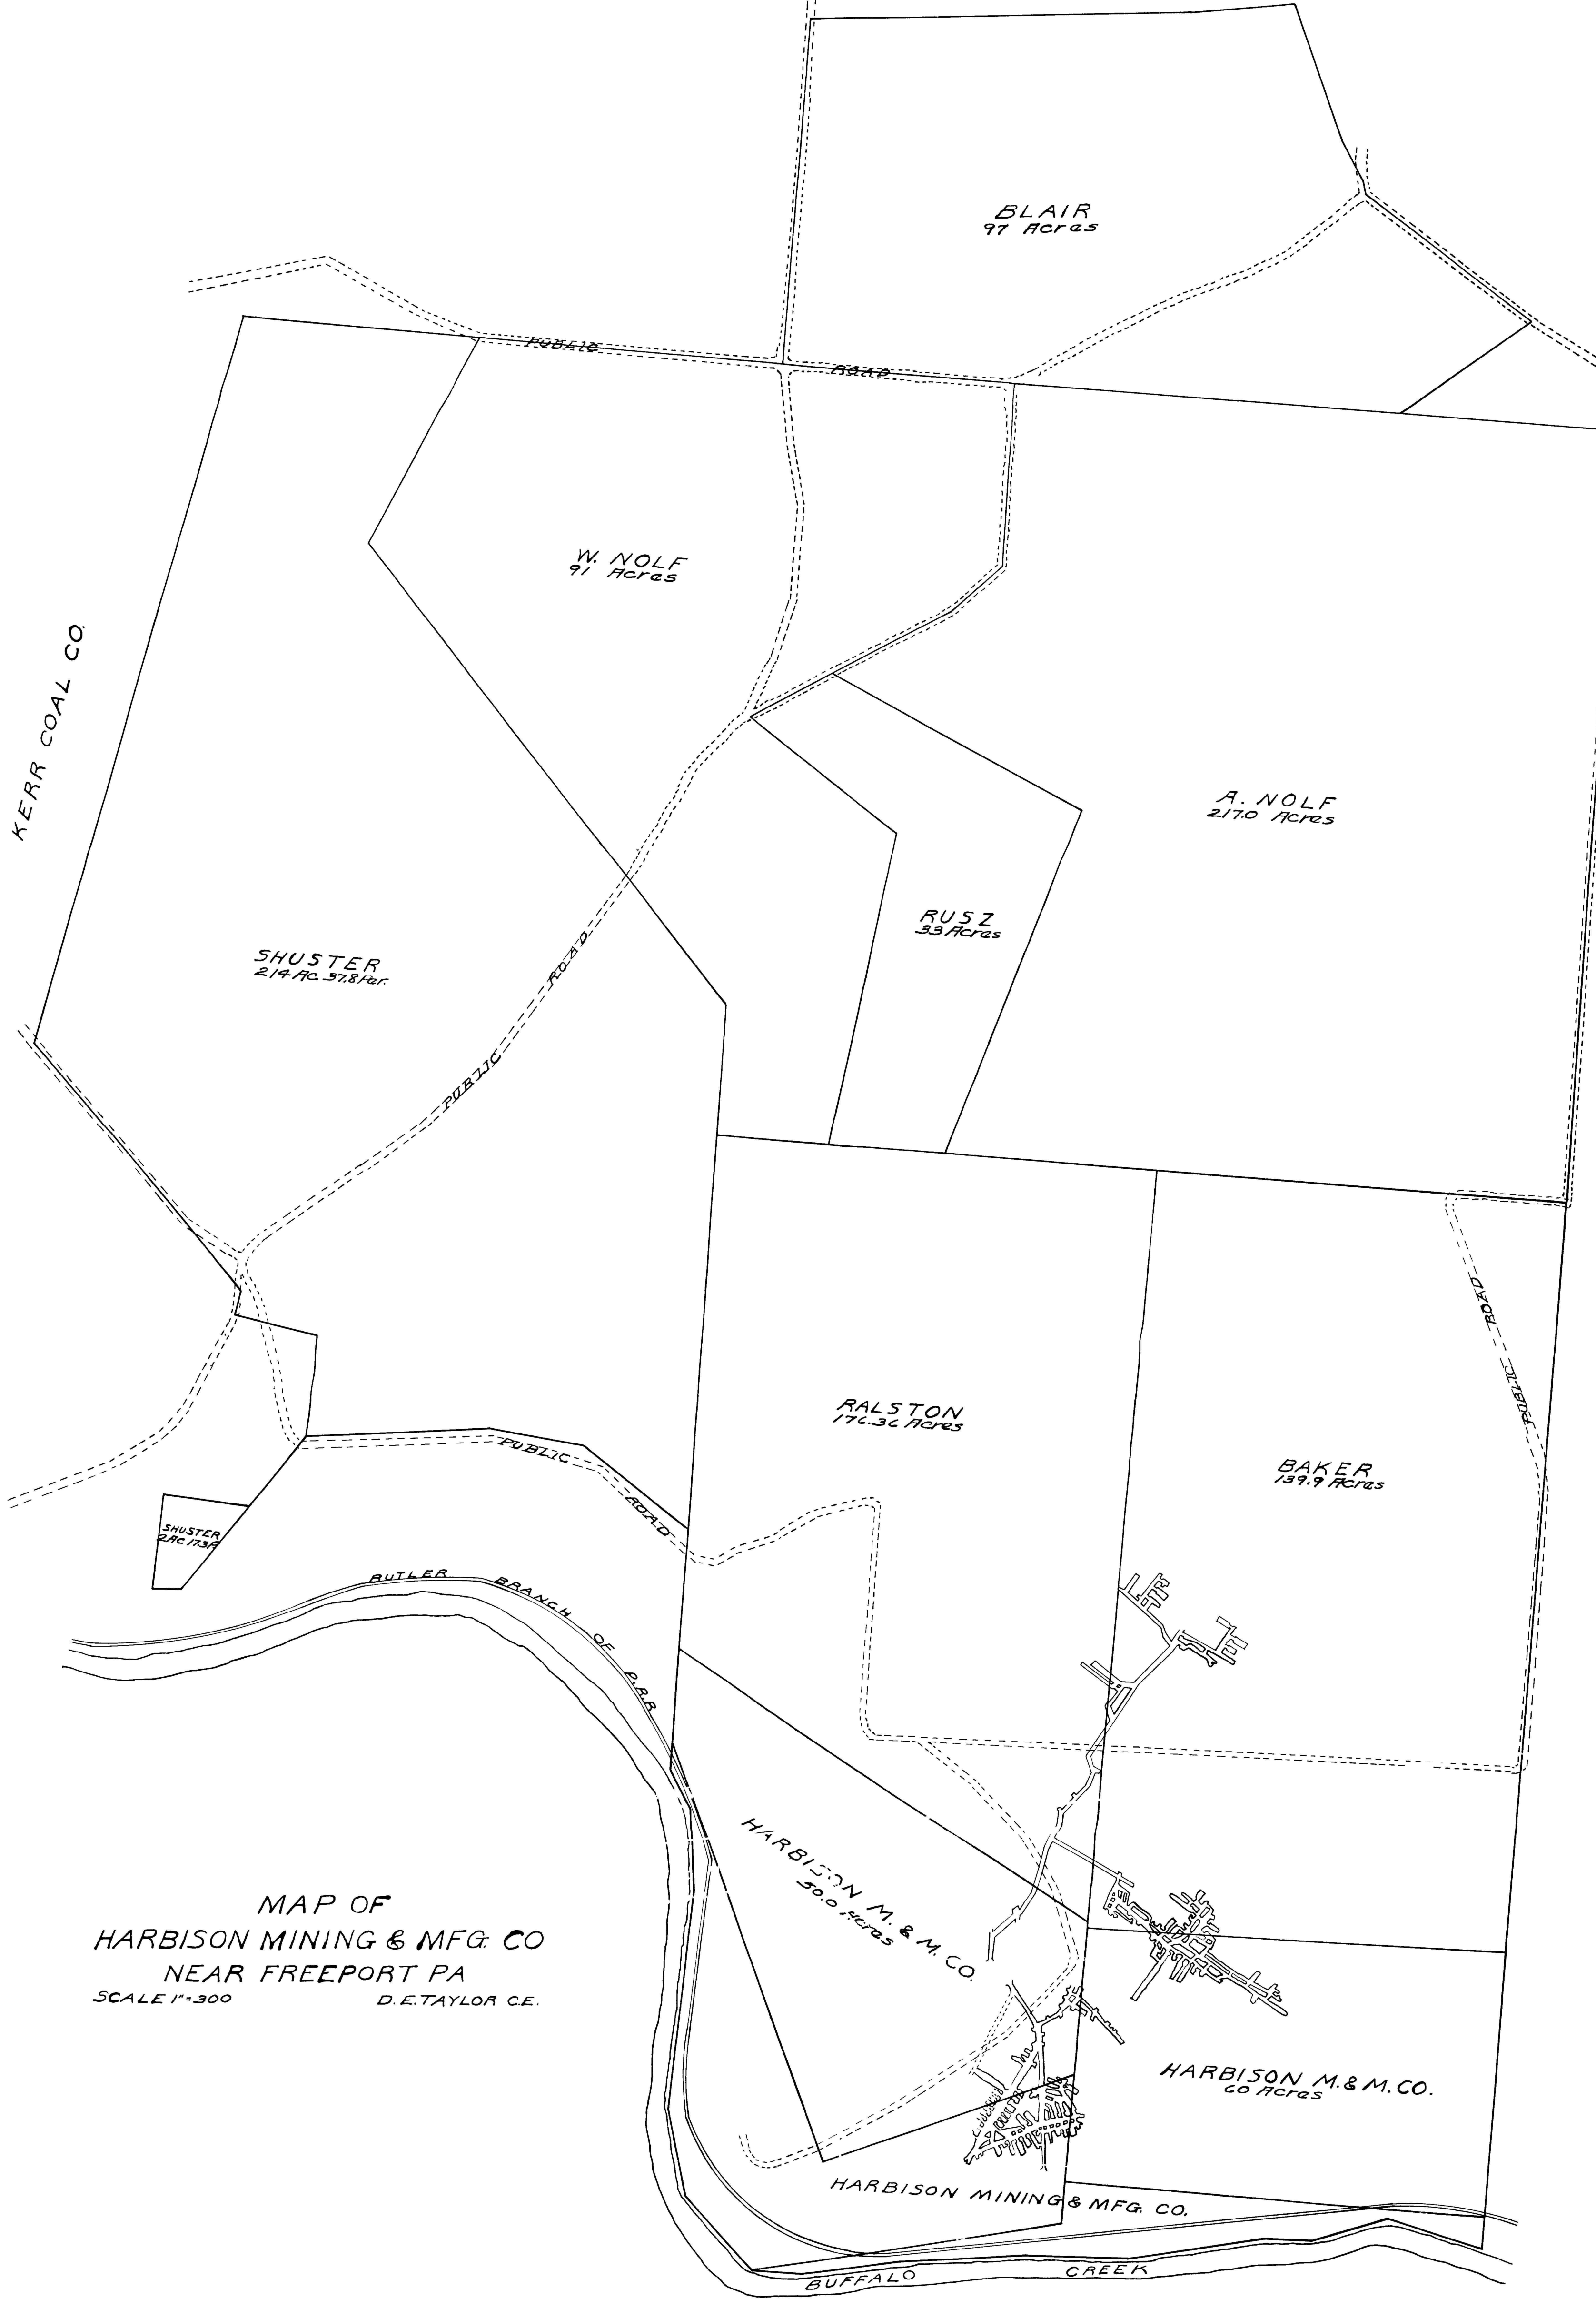

BLAIR
97 Acres

W. NOLF
91 Acres

A. NOLF
217.0 Acres

RUSZ
33 Acres

SHUSTER

RALSTON
176.36 Acres

BAKER
139.9 Acres

SHUSTER

HARBISON M. & M. CO.
50.0 Acres

HARBISON M. & M. CO.
60 Acres

HARBISON MINING & MFG. CO.

MAP OF
HARBISON MINING & MFG. CO
NEAR FREEPORT PA
SCALE 1" = 300
D.E. TAYLOR C.E.