


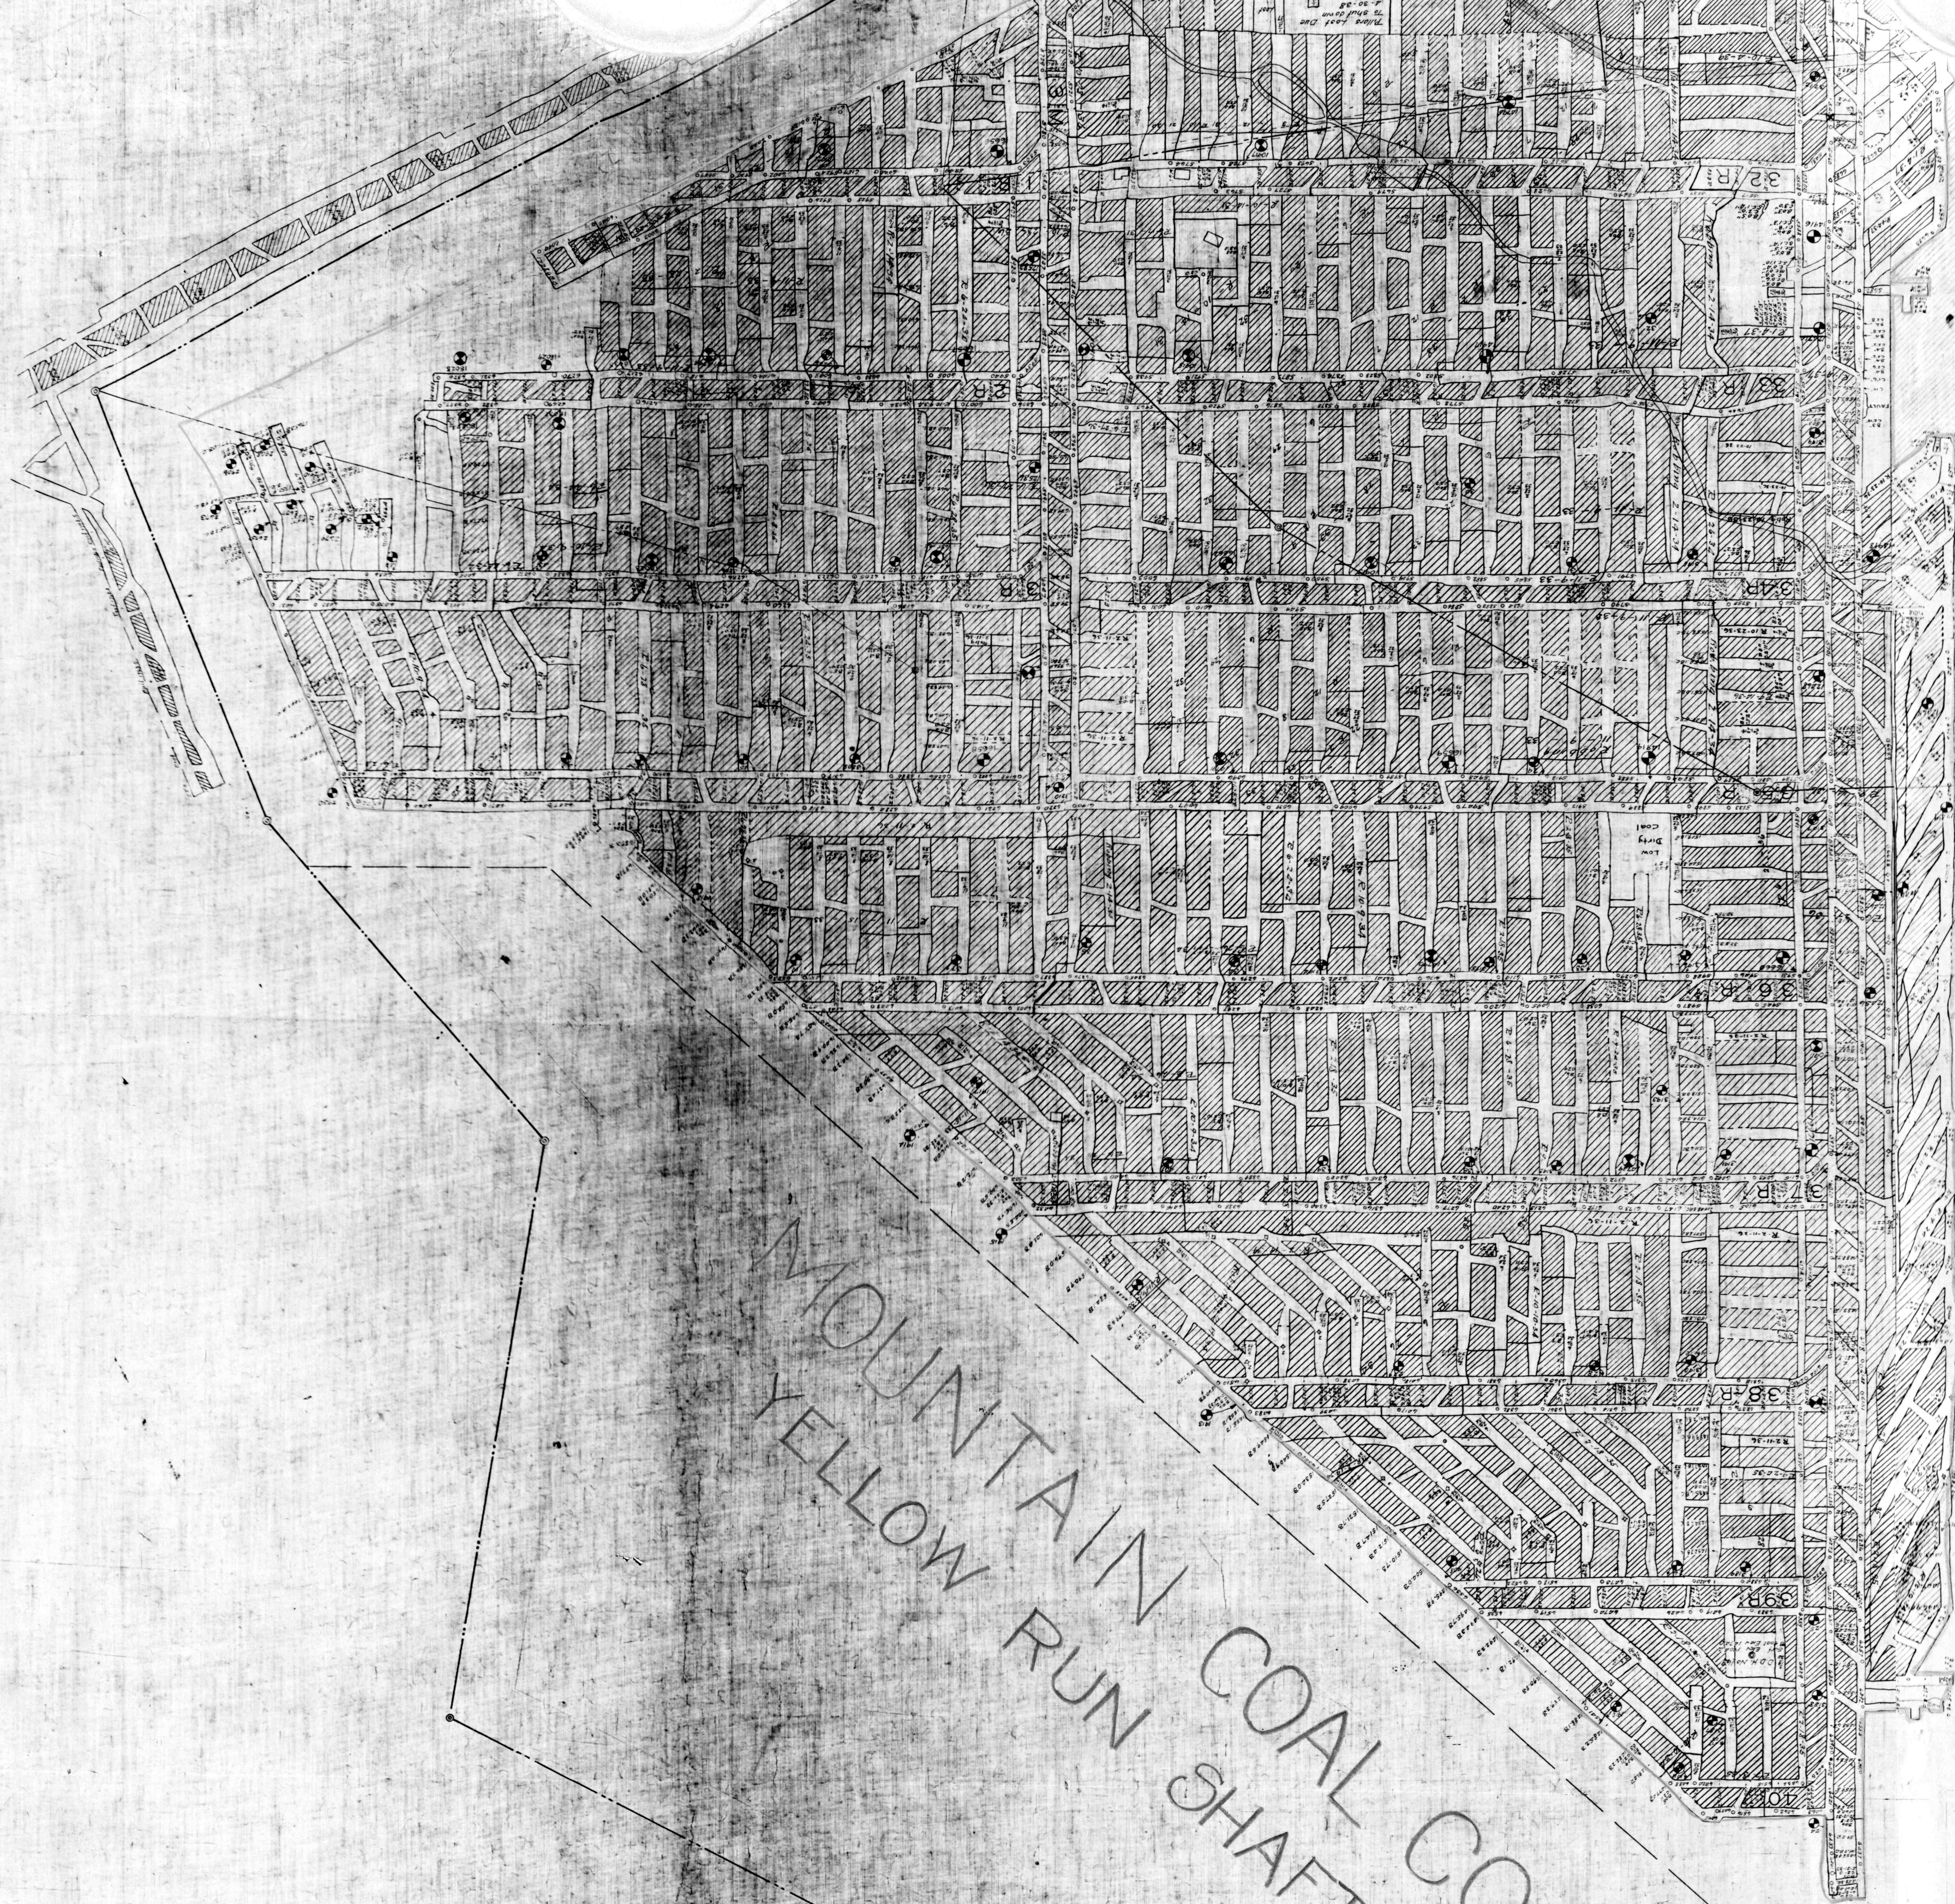

MOUNTAIN COAL CO
YELLOW RUN SHAFT

MARYLAND NO 1 SHAFT
TERRITORY

