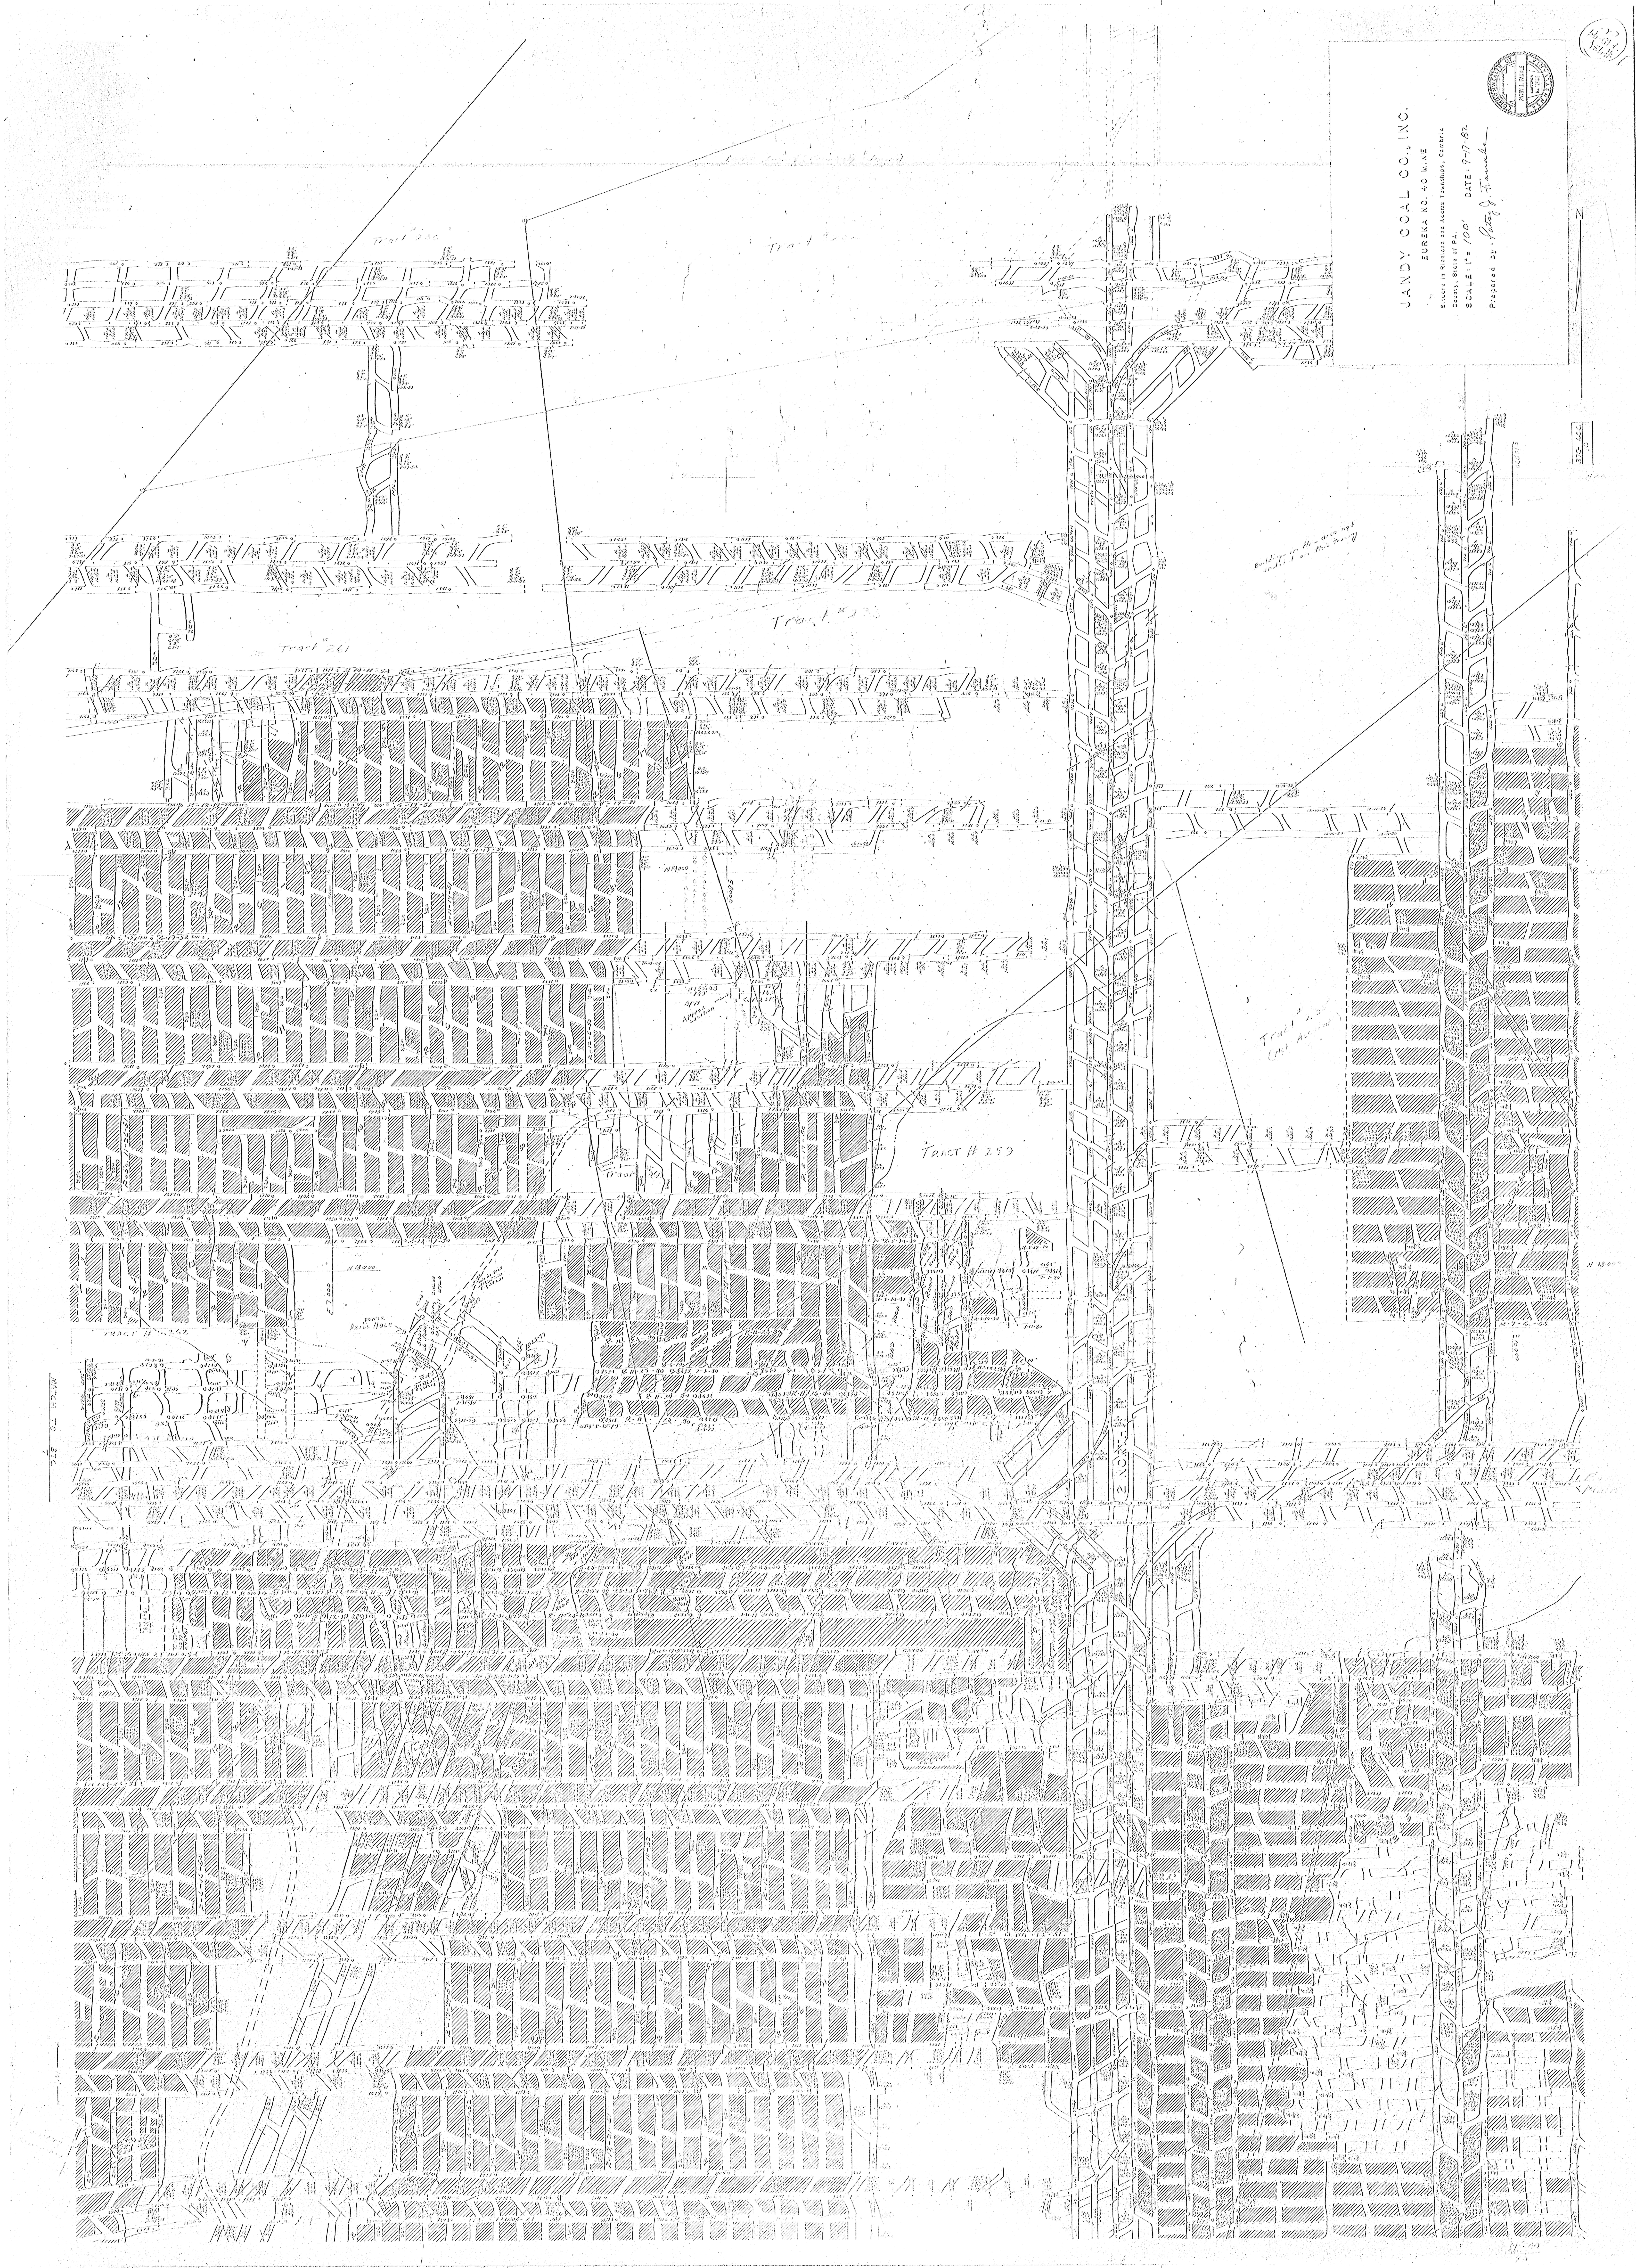

JANDY COAL CO., INC.
EUREKA NO. 40 MINE
Situate in Richland and Adams Townships, Cambria County, State of PA.
SCALE: 1" = 100'   DATE: 9-17-82
Prepared by: Patsy J. Famale

Tract 260
Tract 261
Tract #253
Tract #259
Tract 260
Tract #262
Tract #258 (Not Accounted)
Building in this area not updated on this tracing
2 NORTH
N 19000
E 8000
N 18000
E 7000
E 10000
A/W Approx. Location
Power Drill Hole
N
37C
MATCH TO 37C