

WINE MAR


-- OF

ANITA COAL MINE CO.

EUREKA NSE

Scale 1"=100'


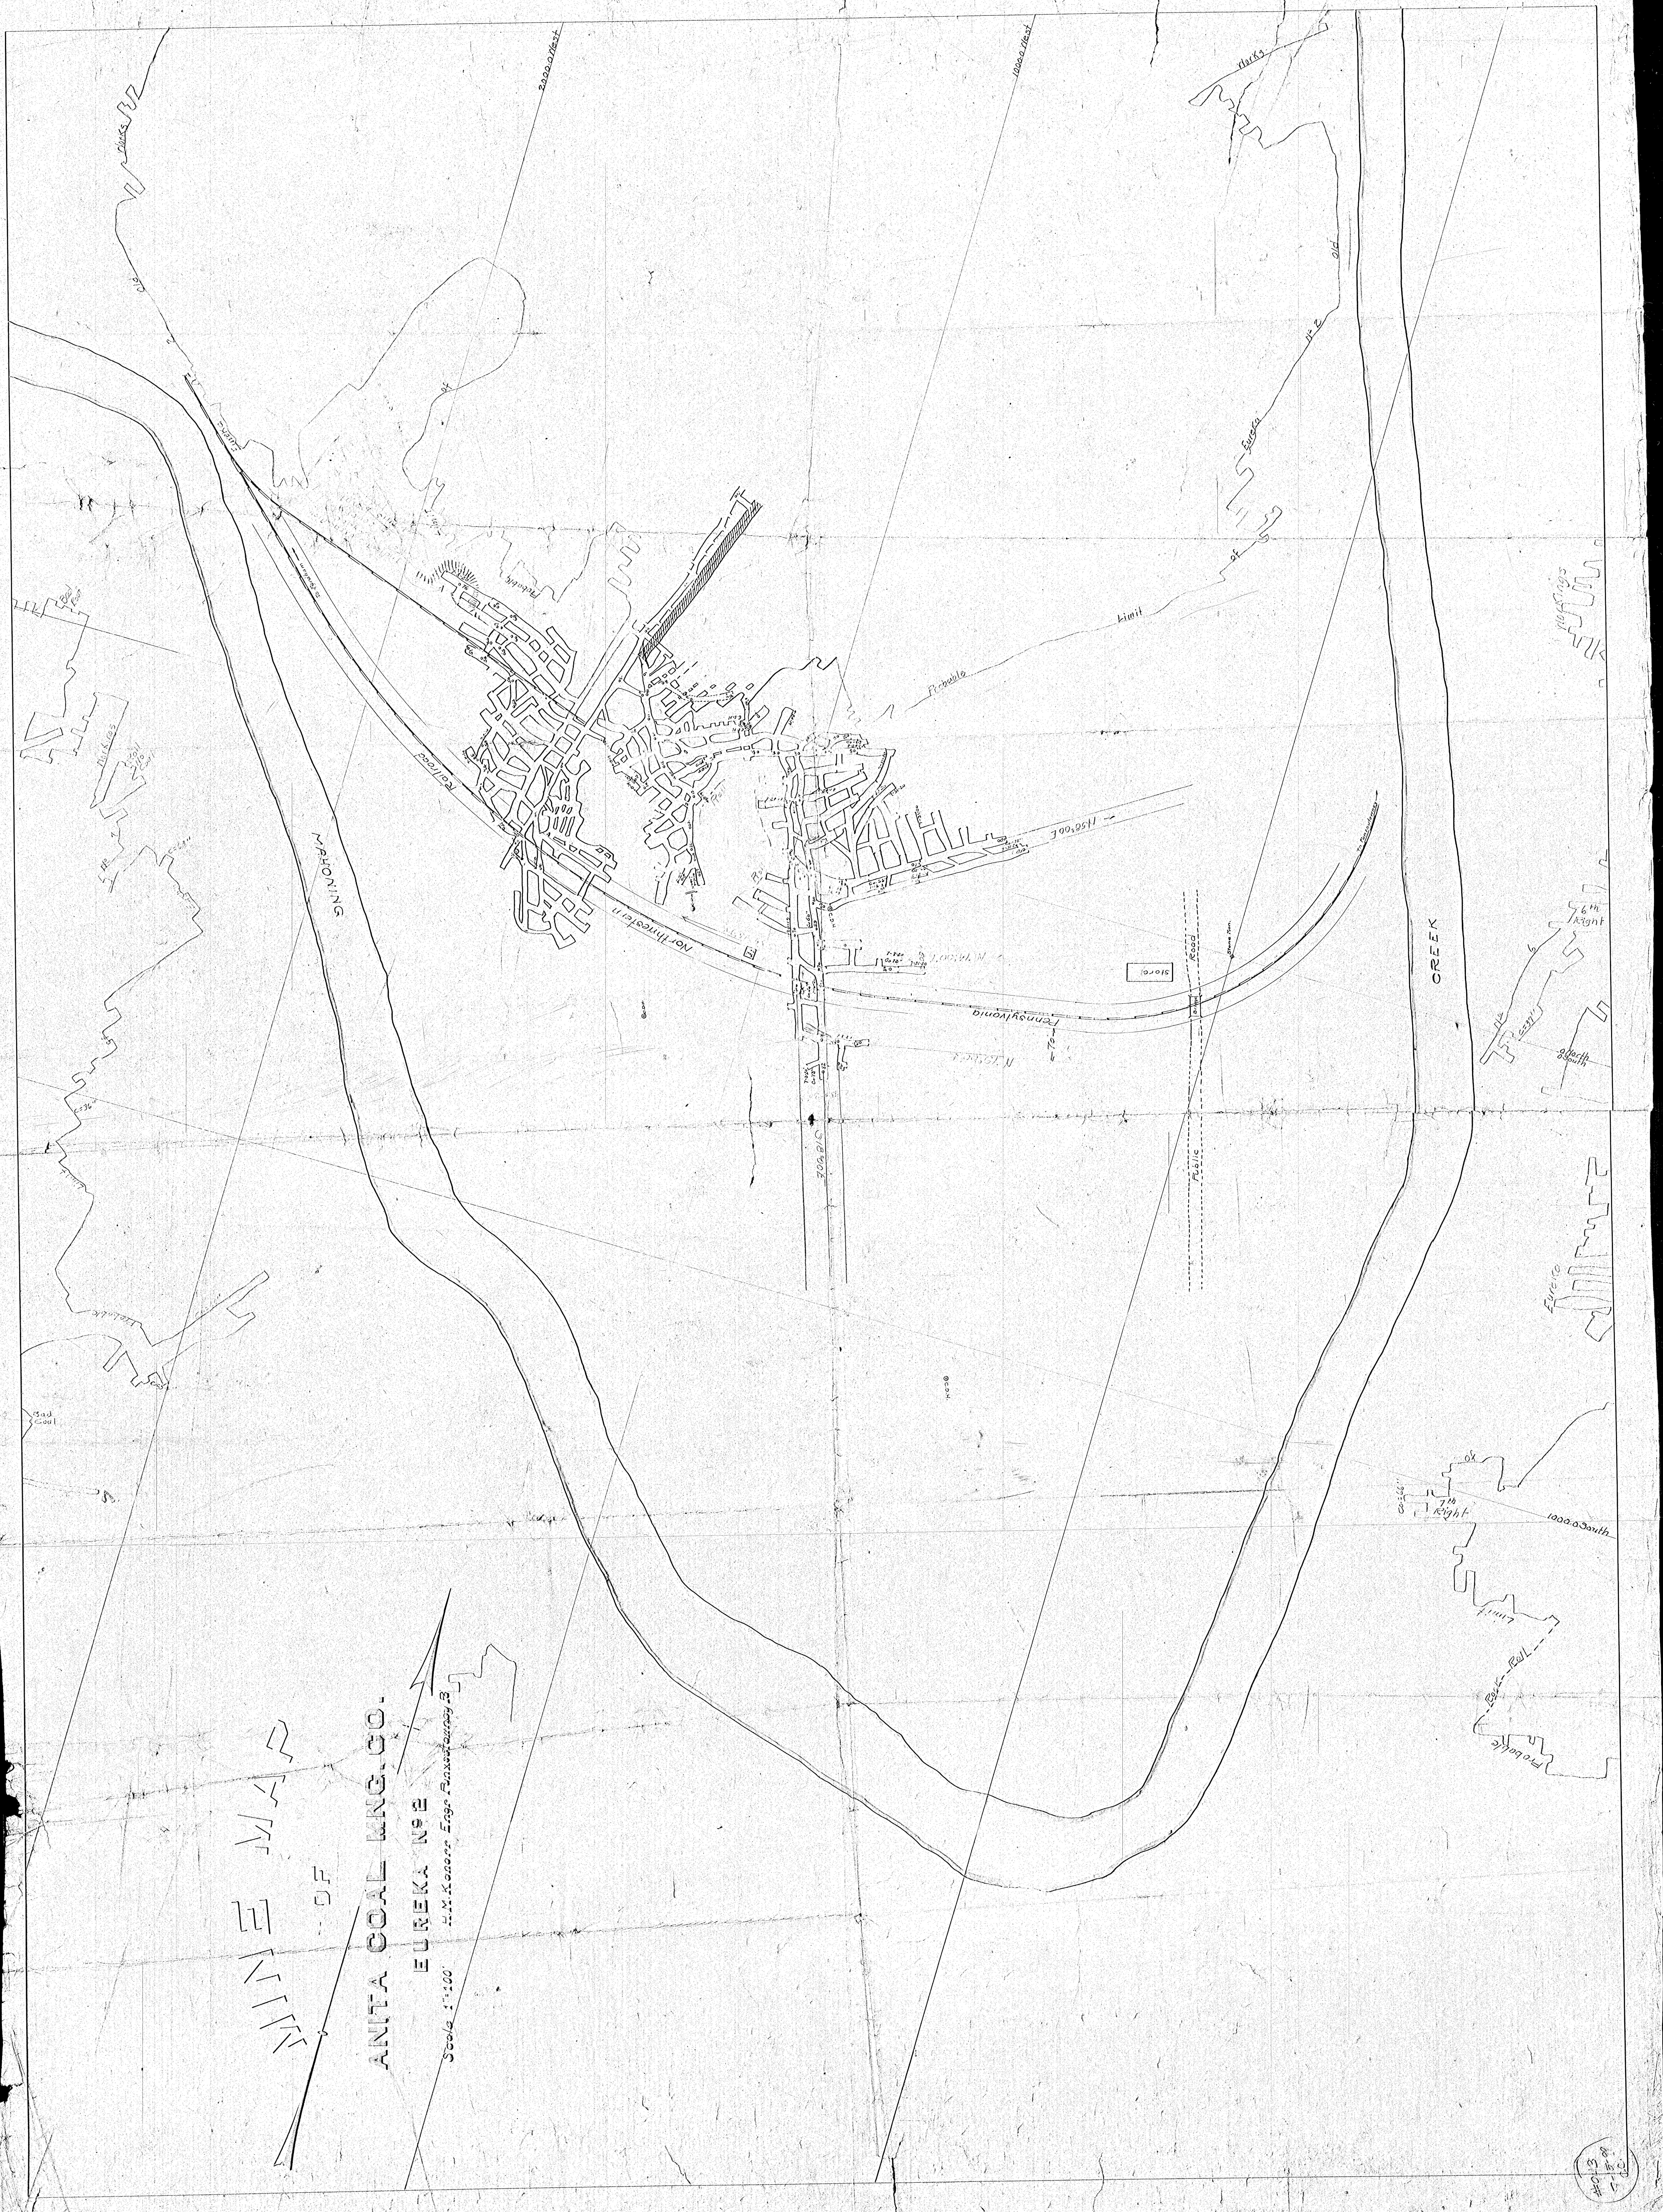

4013 9
7-18-9
100