


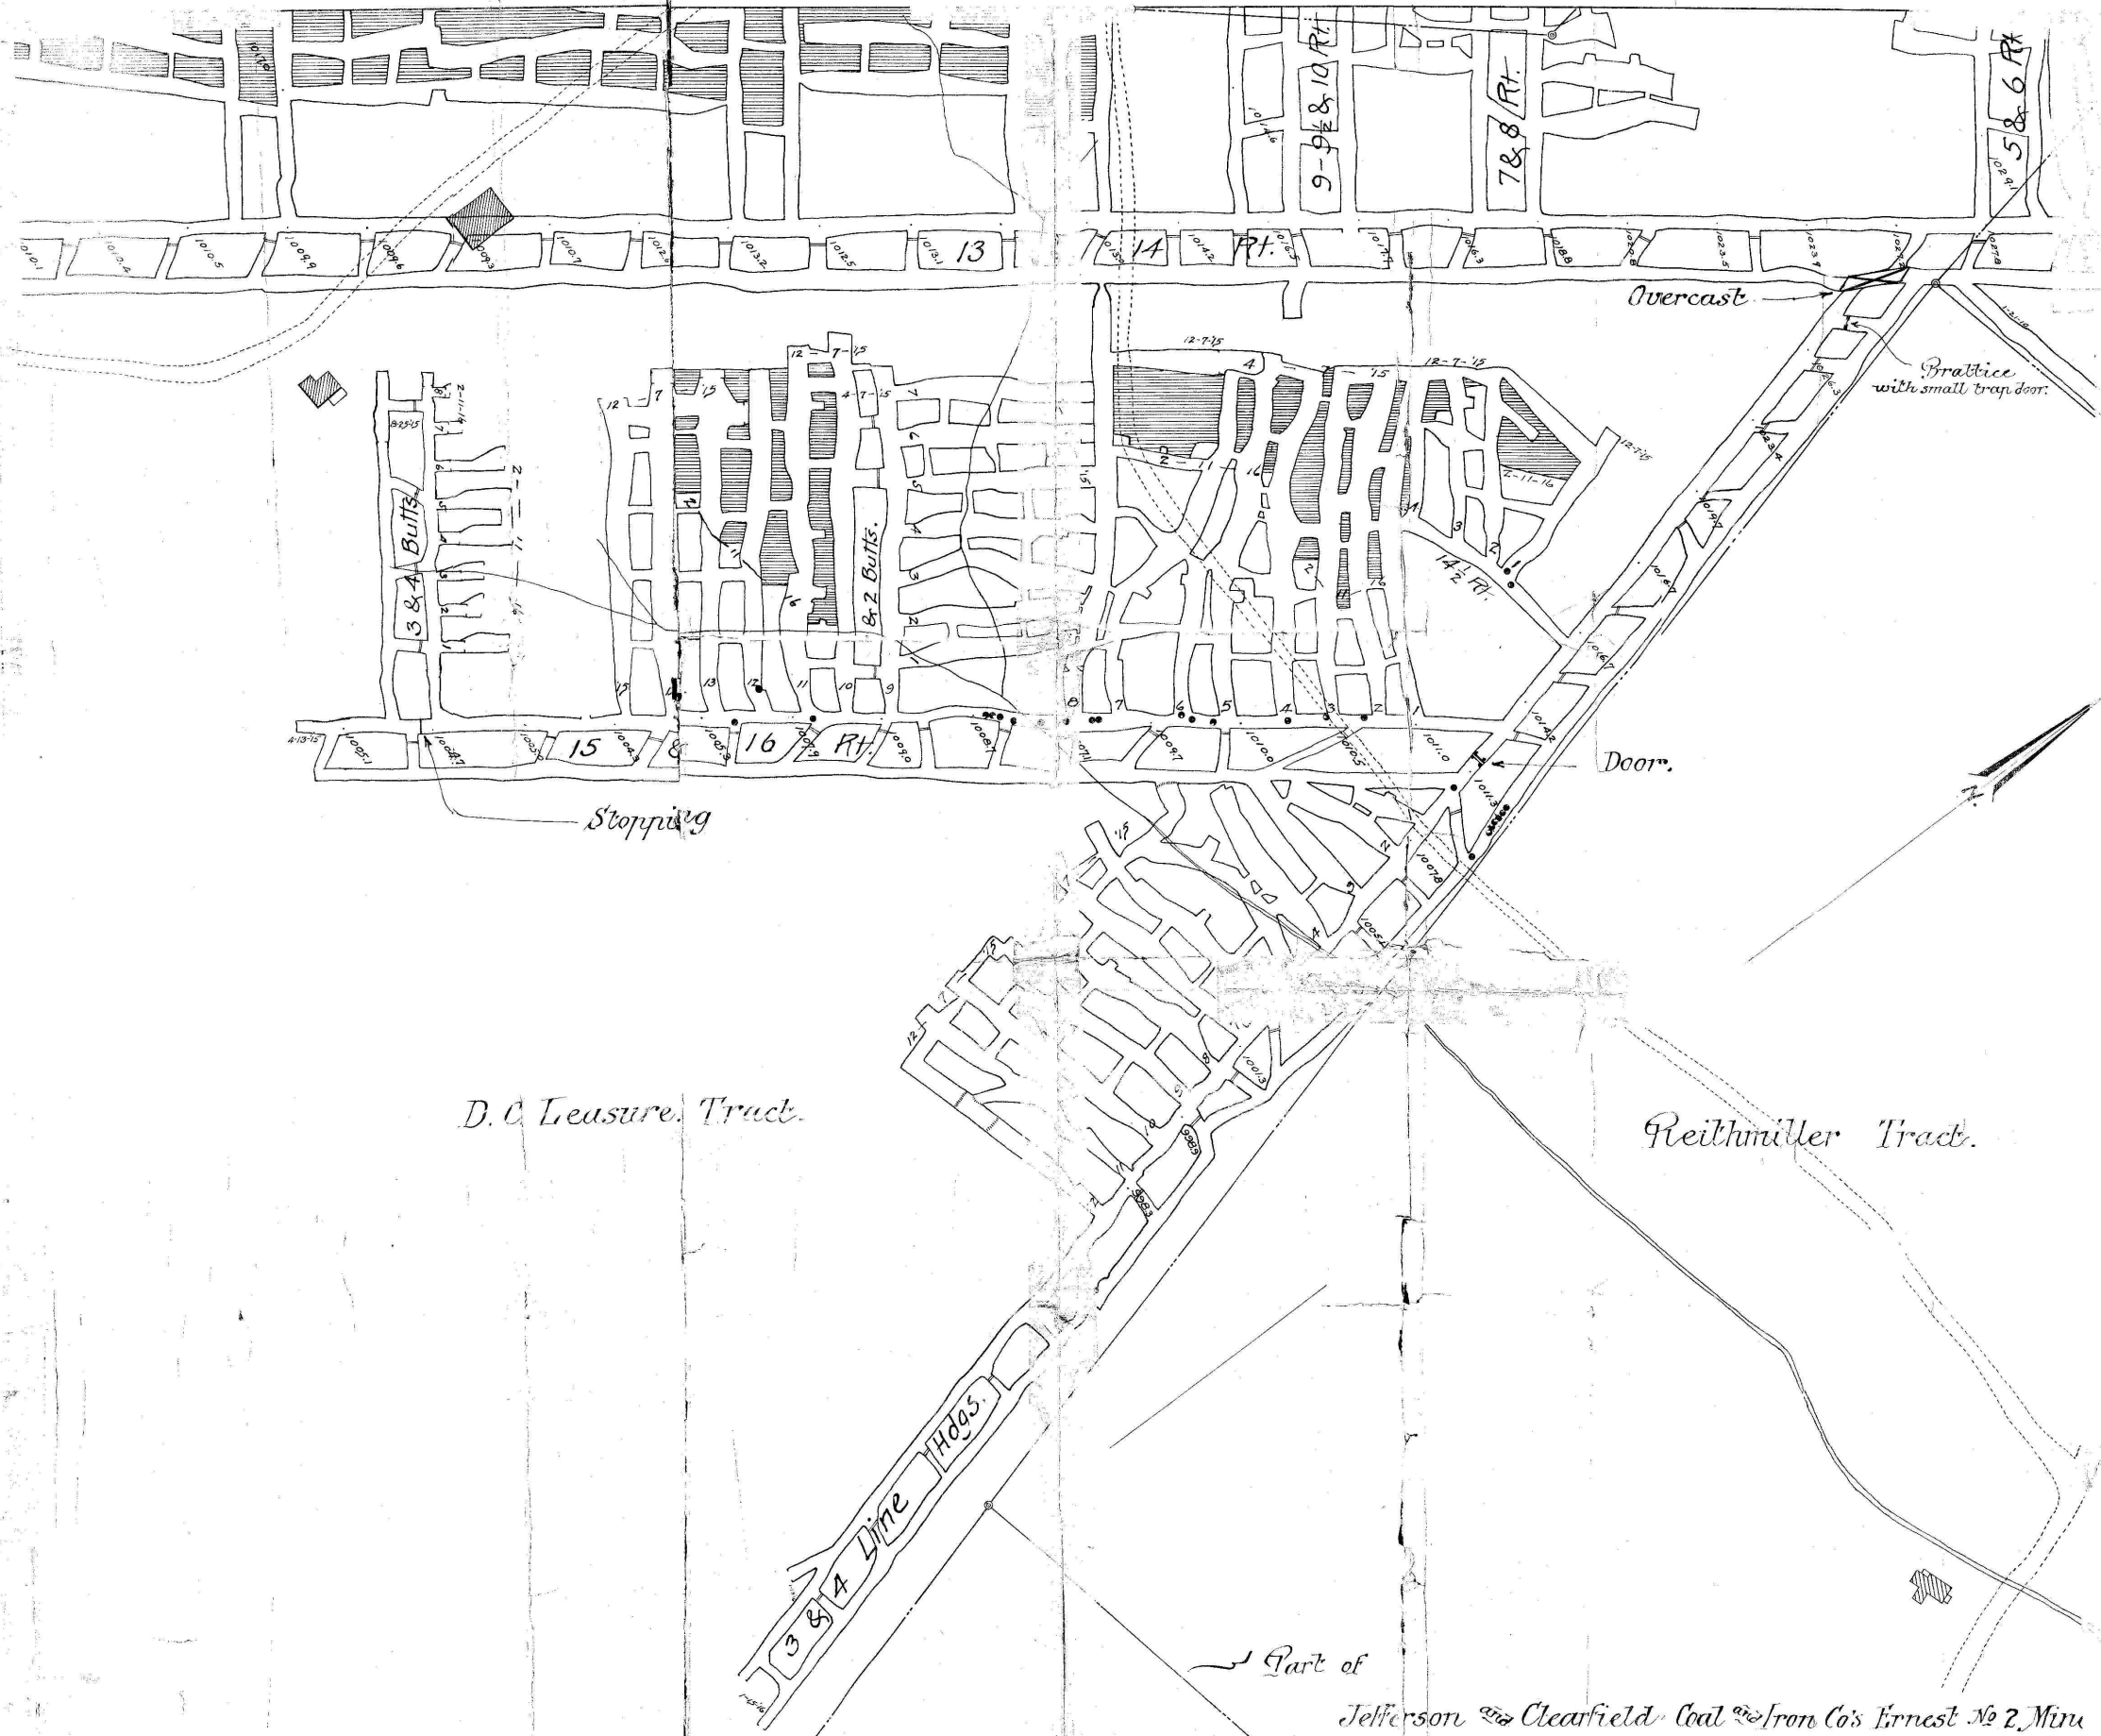

Part of
Jefferson & Clearfield Coal & Iron Co's Ernest No 2 Mine
in which Explosion Occurred Feb. 11th 1916.