

PART OF THE JOHN CARSON PROPERTY AND OTHERS
SITUATE IN
ALLENPORT BOROUGH, WASHINGTON COUNTY PA.

OLD PLAN AND SURVEYS OCT. 1940 - FEB. 1941. Scale 1 in = 100 FT.


ADDITIONS - May 6-7-1941.

" Feb 27 - 1942

" May 4 - 1942

" Nov. 21 - 1942.

Alex. L. McVicker - Reg. Prof. Engr. #825

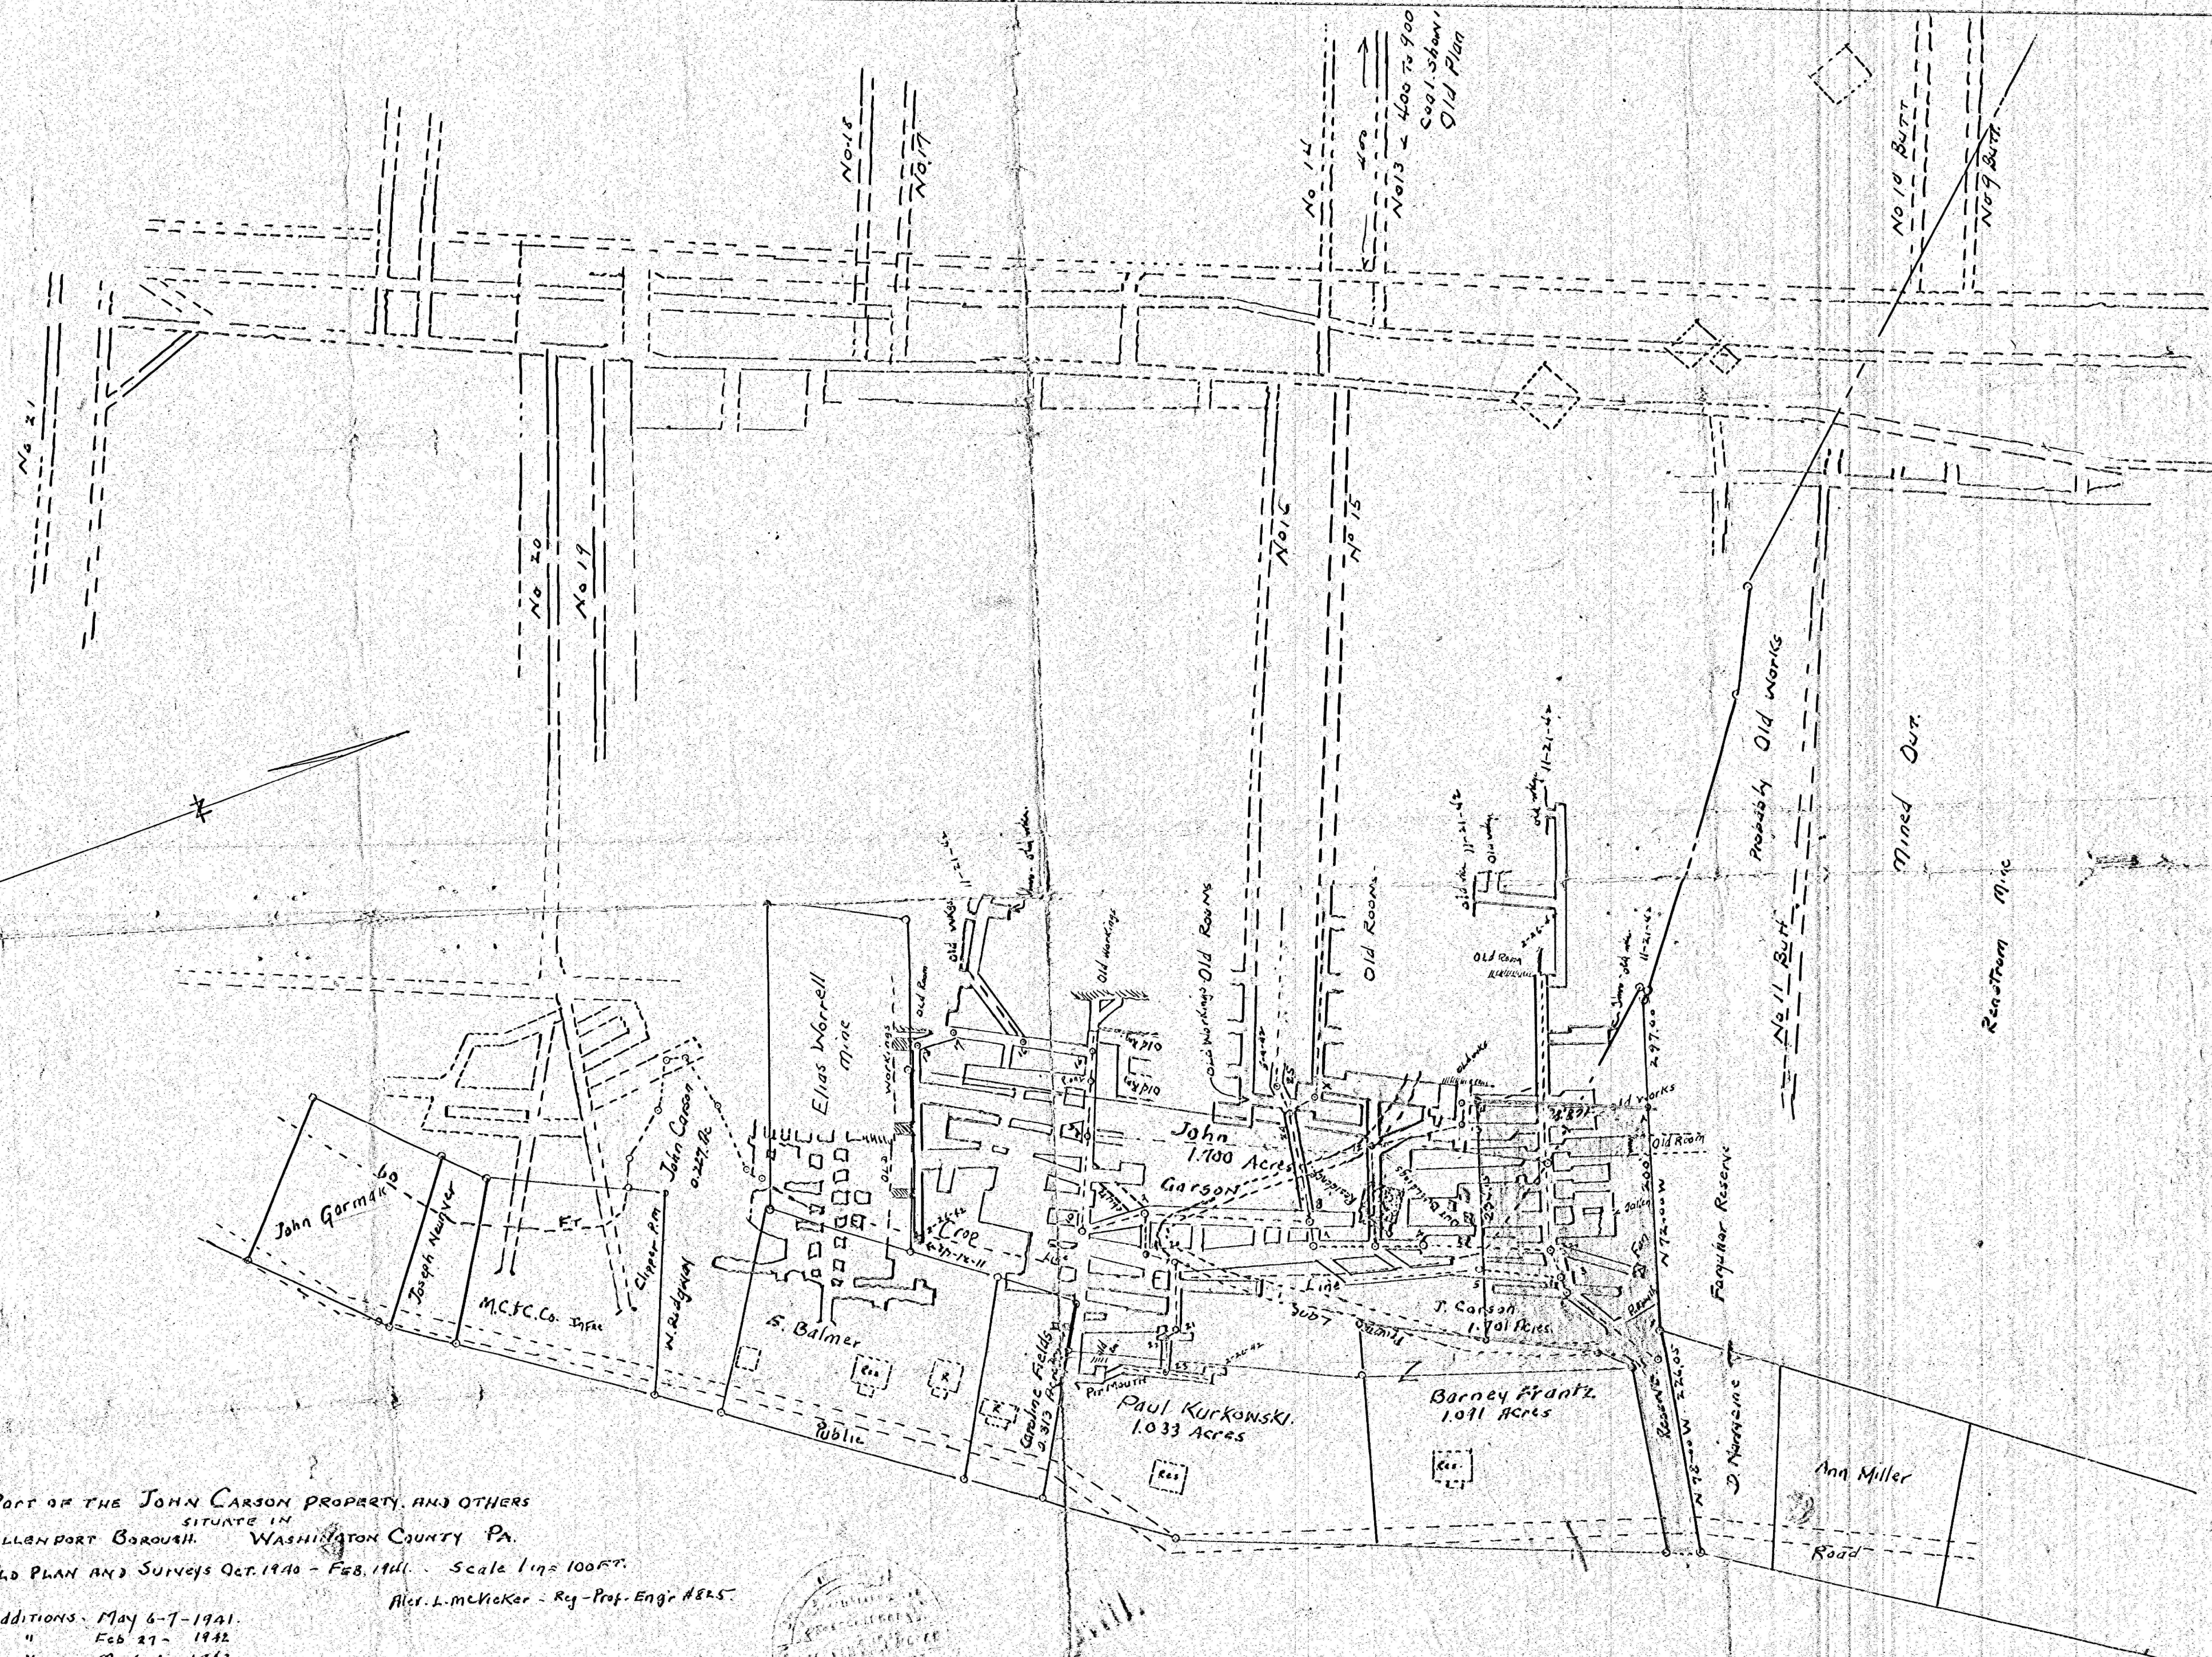

1049
7-15-42
CC