

Lucinda Chalfant Tract

John R. Winnett Tract

Hester Winnett Tract

I CERTIFY THIS IS A TRUE AND CORRECT
COPY OF THE ORIGINAL MINE MAP SHOWING
COAL LAND UNDER LEASE TO:

GEORGE F. BUERGER


FALLOWFIELD TWP. - WASHINGTON COUNTY - PENNA.

August R. Werft
REGISTERED PROFESSIONAL ENGINEER

DATE: *June 29, 1966* 12" LINE

GREENSBORO GAS CO.

FINAL SURVEY APRIL 22, 1966

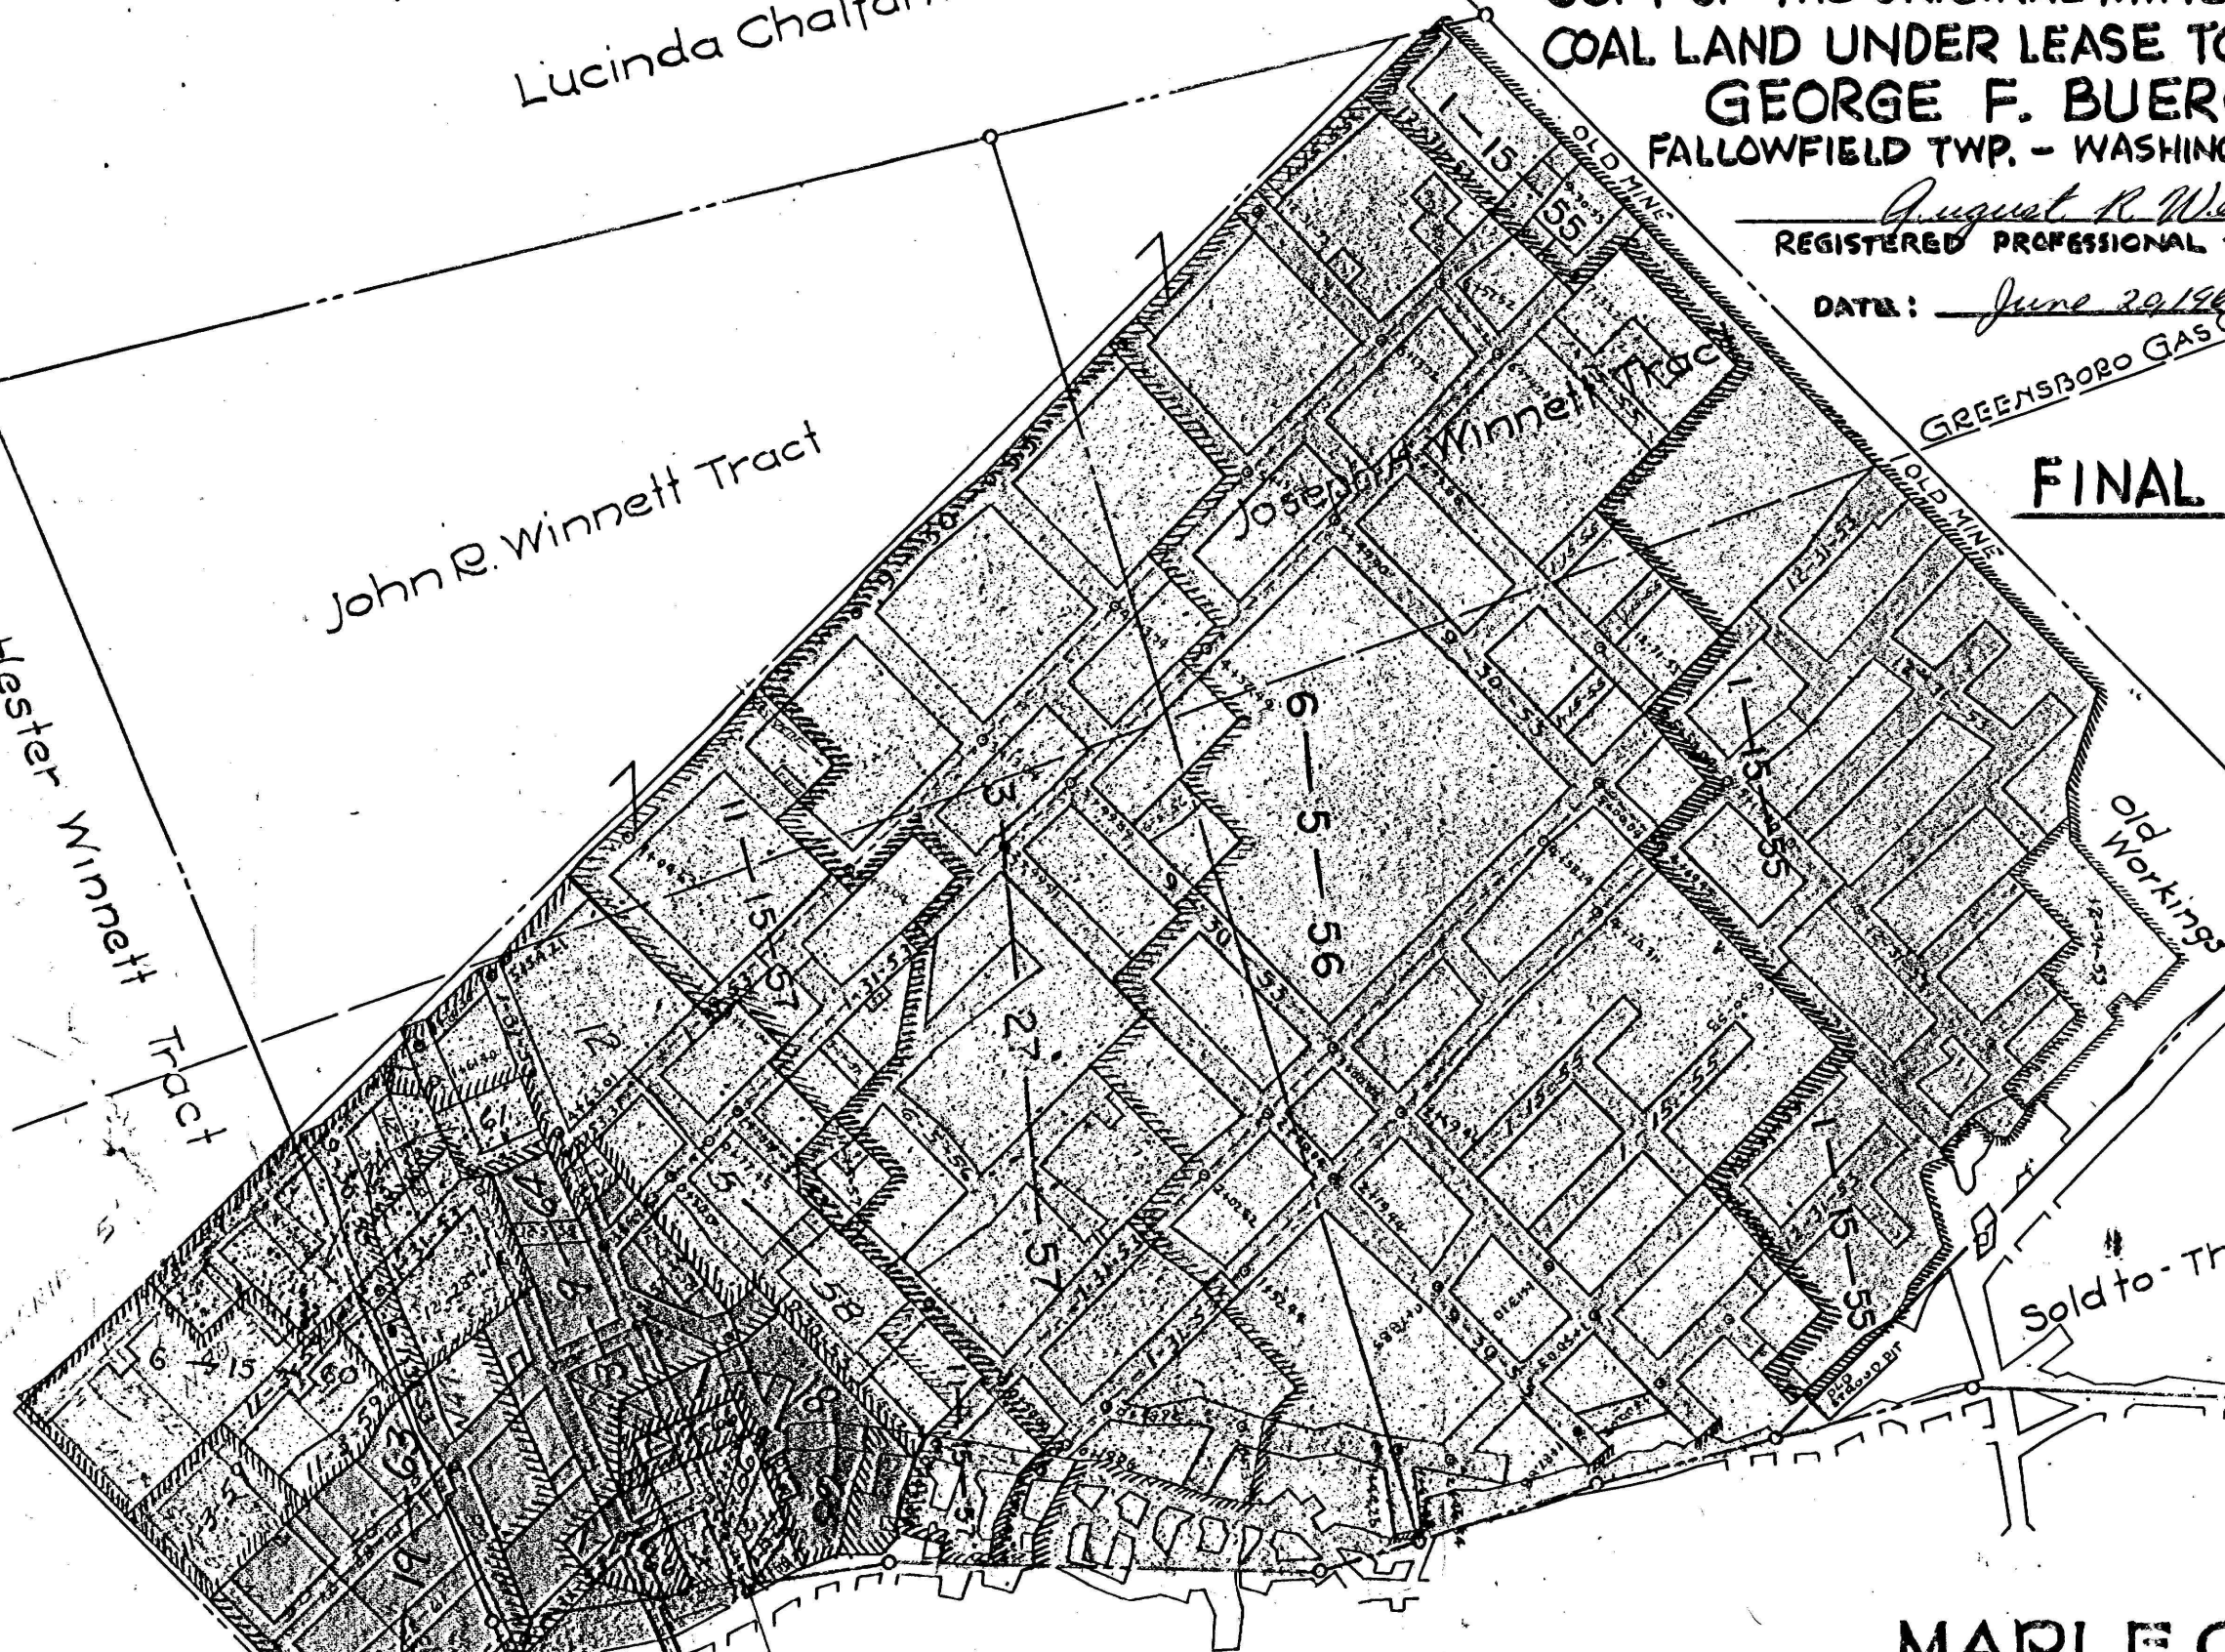

Rider Coal Co
Workings

By Corporation Consent
Assigned To George F. Buerger
February 11, 1957

MAPLE CREEK FIELD
Plan Showing Coal Leased
To

O'Neal Hawker

Fallowfield Twp., Washington County, Pa.

Scale - 1" = 100' Sept. 6, 1951

A.M.M.

14-D-752

#750
7-15-94
C.C.