


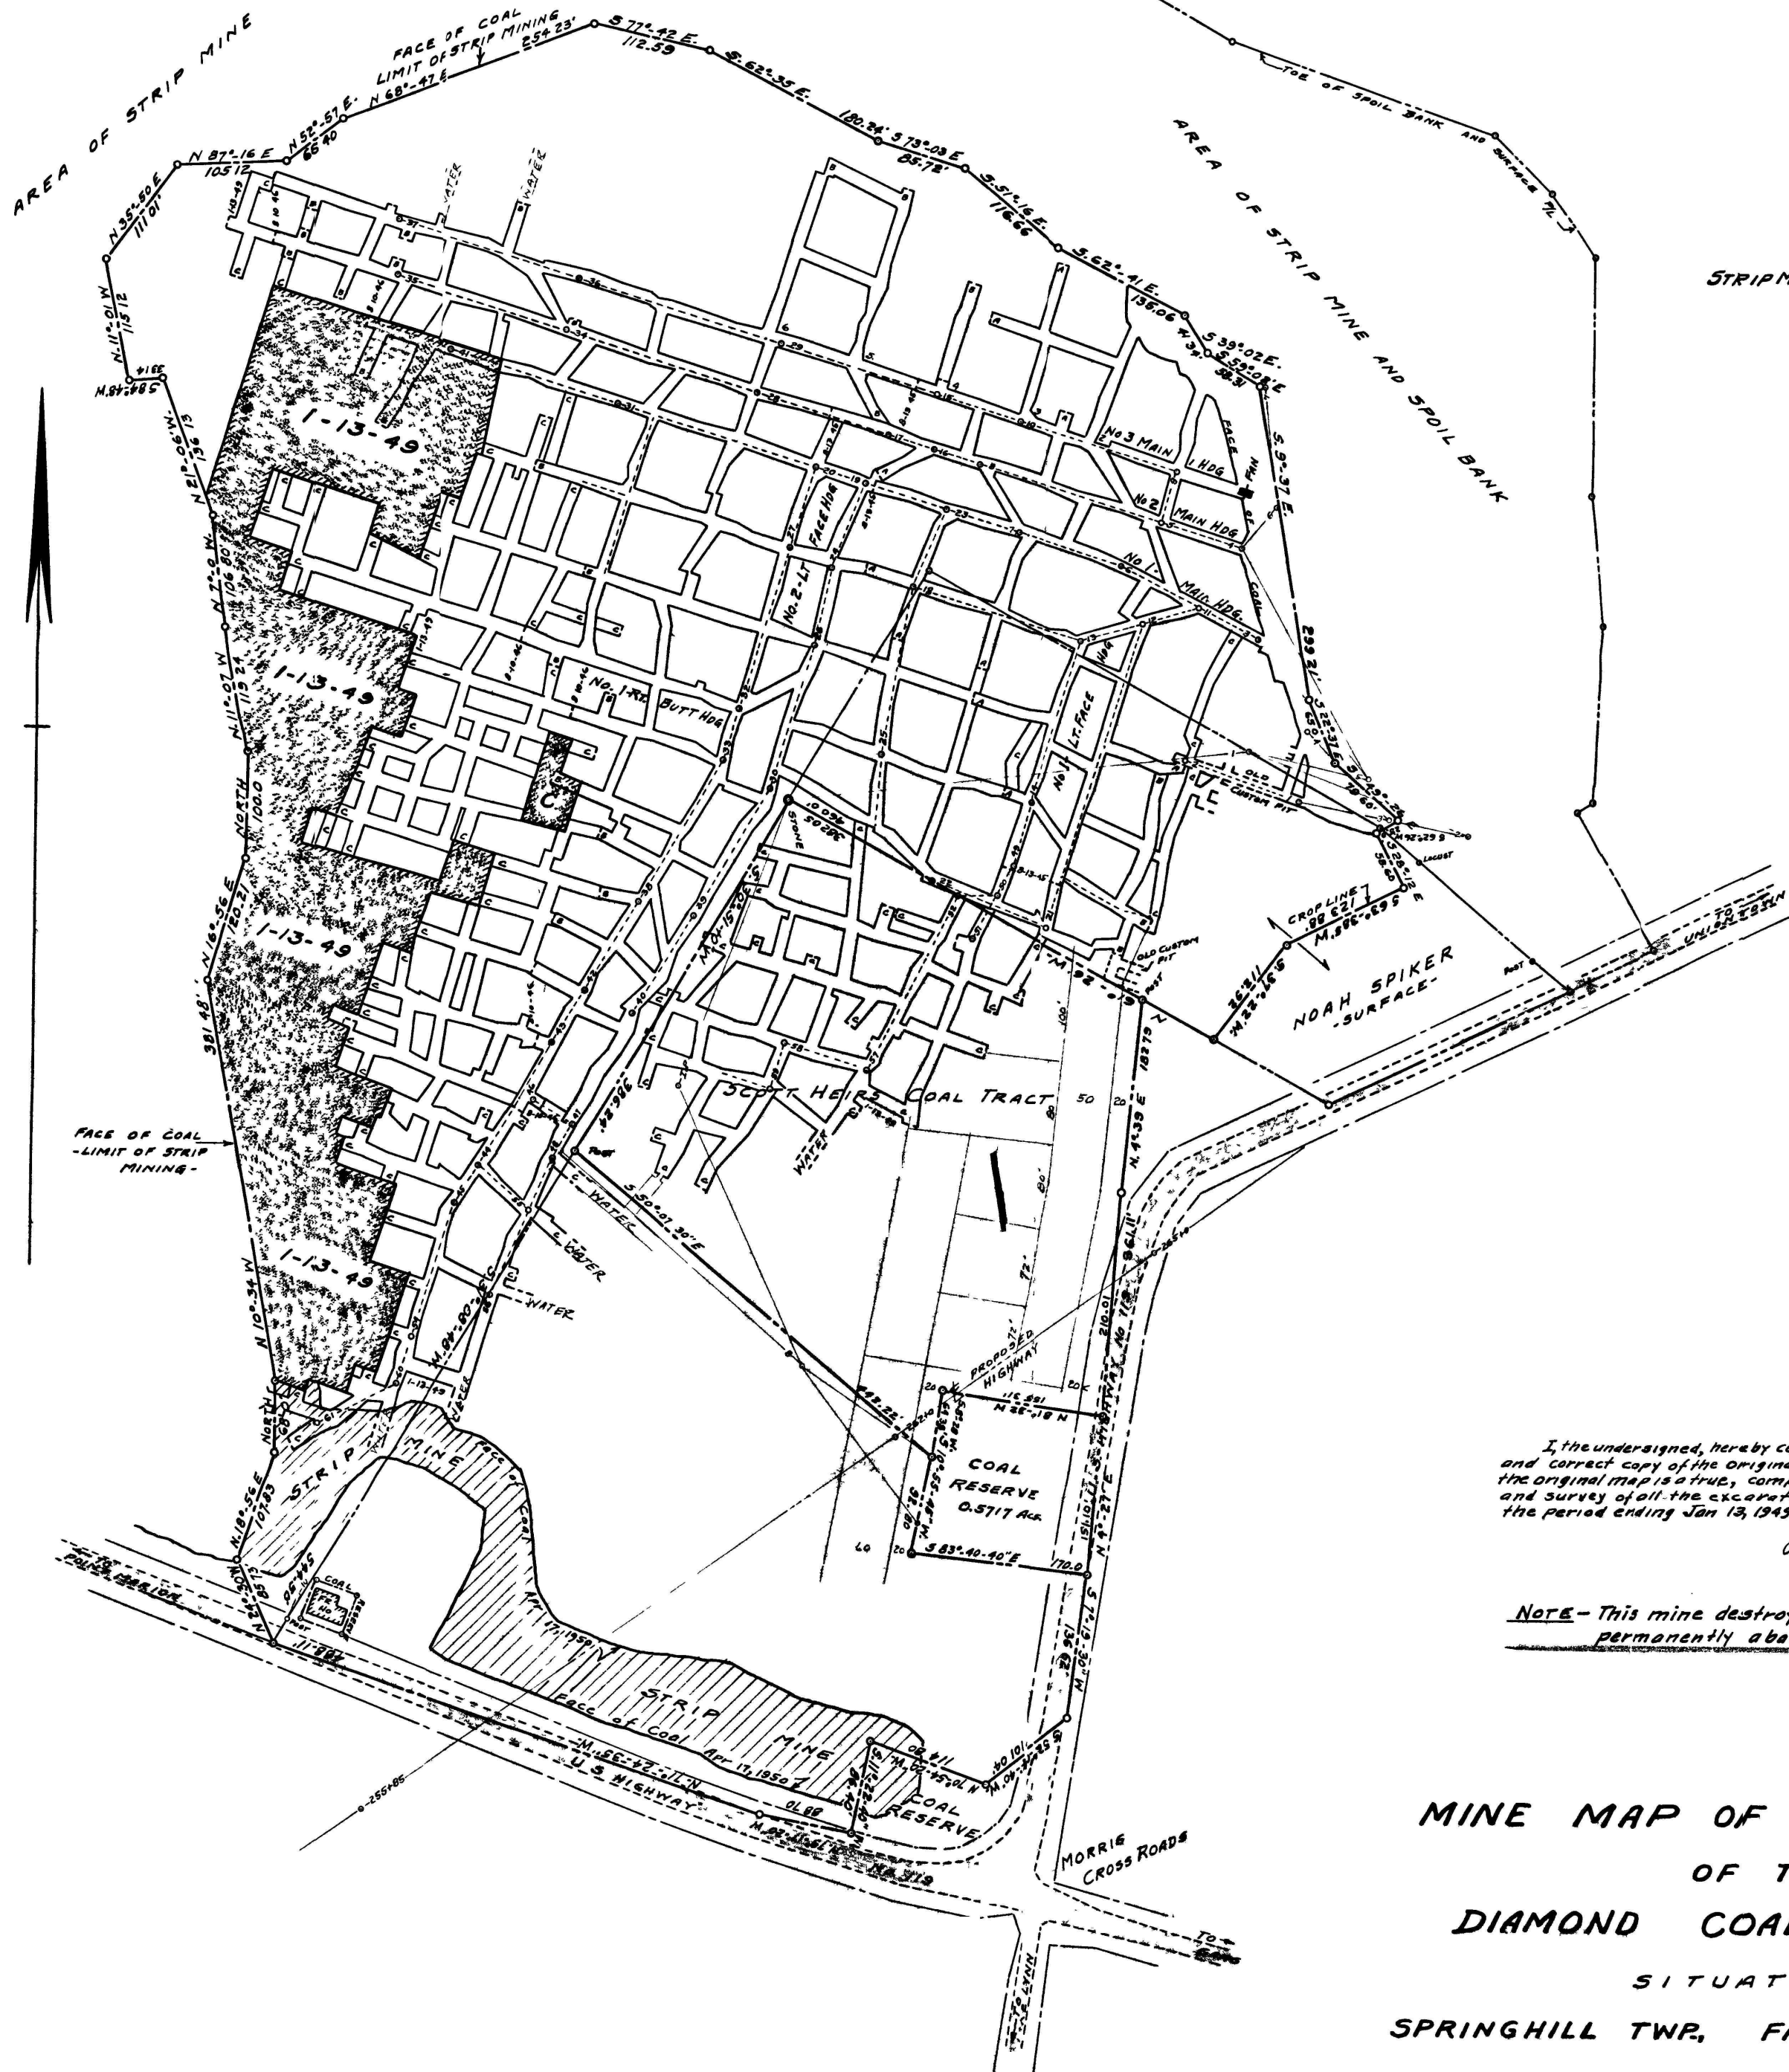

SURVEY DATES

A = AUG. 13, 1945
 B = AUG. 10, 1946
 C = JAN. 13, 1949
 STRIP MINE = APR. 17, 1950

I, the undersigned, hereby certify that this map is a true and correct copy of the original map of this mine, and that the original map is a true, complete, and correct map and survey of all the excavations made in this mine for the period ending Jan 13, 1949.

James M. Cabbage
 Reg. Surveyor No. 3185

NOTE - This mine destroyed by Fire and permanently abandoned during 1952.

MINE MAP OF "EVELYN" MINE OF THE DIAMOND COAL COMPANY

SITUATE IN
 SPRINGHILL TWP, FAYETTE CO., PENNA.

SCALE - 1" = 100'

APRIL, 1945

James M. Cabbage, Reg. Surveyor
 Point Marion, Pa.