

Eyre Collier
Company
Near Clif
Lawrence Twp.
1917.

cond.

CLEARFIELD
QUAD

Original map based on 500'
R.R.R. over crossing of N.V.C.


Fairmont 1495

This map 138
Added to 657
all elevations.

Ashley seems
to be 12' high

1959 Clearfield 7 1/2'
gives this as 1145

actually 1157
RRR 500

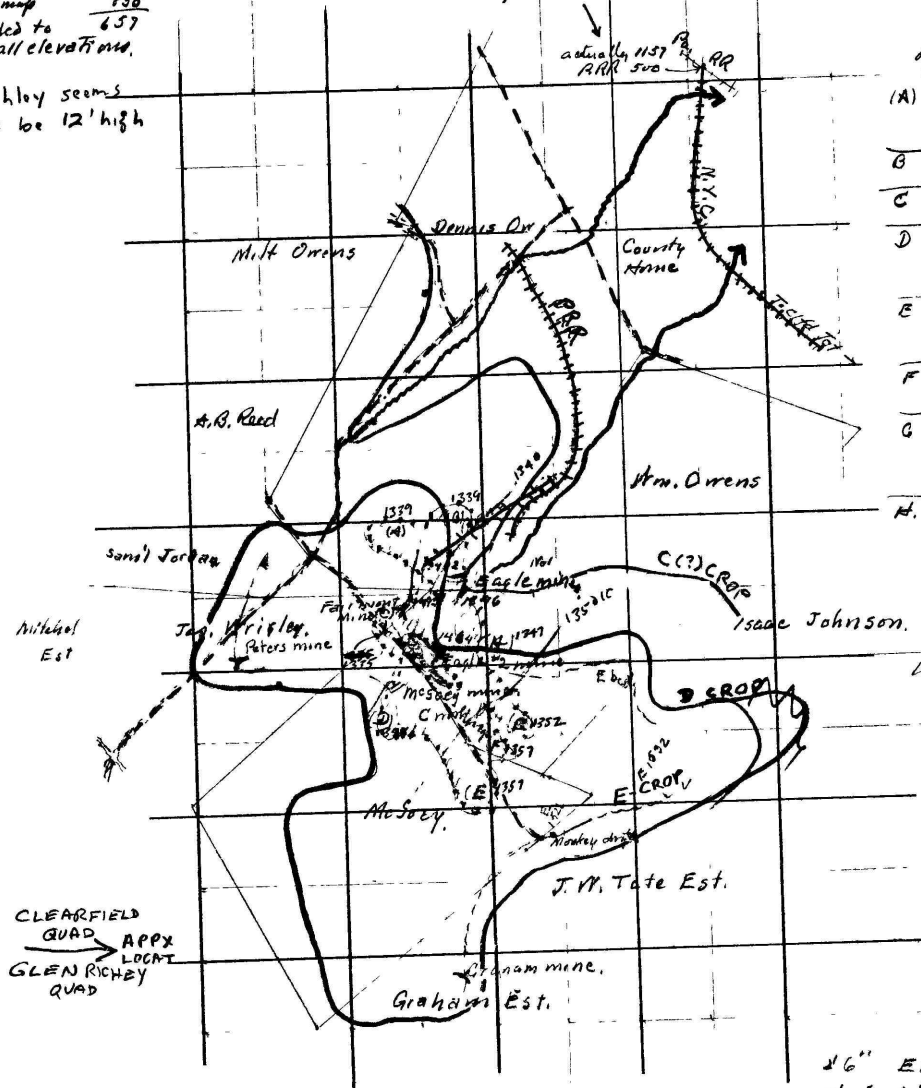

A + D. M.E.s

1 inch = 1000

from 1917 map of Eagle
and Ele. Coal Section

(A) C? 1351	B 0.8
	C 1.5
	R 0.1
	E 1.7
B C? 1351	B 0.6
	C 2.8
C C? 1347	B 1.0
	C 3.2
D C? 1353	B 0.8
	C 1.0
	R 0.15
	C 1.6
E C? 1361	B 1.0
	C 0.8
	R 0.2
	C 1.2
F C? 1362	B 1.4
	C 2.8
G C? 1364	B 0.8
	C 1.5
	R 0.1
	C 1.3
H. 1359	B 0.6
	C 0.7
	R 0.1
	C 2.0

Adams in D
Eagle #2

Under water 10/1/1920
Sections by Adams

C 2.8, semi
R 0.1
C 0.9, butyri

CLEARFIELD
QUAD
APPX
LOCAT
GLEN RICHEY
QUAD

RR. Clif June 1162
" 1200 322 1126 + 115 = 1144

1532
+ 455
37

12 + 110 + 127
+ 97

1447
1540
1532

185 at road
1270 top private road.
only 1920 coal, 13.
1362 private C
1447 " C'
1540 " D
1532 " D'

176

16" E Fairmont 1495 } 391
2'10" D Eagle #2 1464 } 311
28" C Eagle #1. 1346
B estimated 1900.

E 1532
195
1337
1250
87