

MAGNETIC NOV. 1940

N




E. A. JONES COAL CO. FAIR-VIEW MINE OPERATING IN "E" SEAM

SITUATE IN STONYCREEK TWP. SOMERSET CO. PA.
SCALE: 1" = 100'

NOV. 30-1940
RALPH E. SMITH R.P.E.

LETTER	DATE	SURVEYED BY
A	11-23-40	RALPH E. SMITH
B	3-8-42	RALPH E. SMITH
C	4-13-47	CLYDE S. DAVIS
D	1-31-49	CLYDE S. DAVIS
E	12-19-50	CLYDE S. DAVIS
F	5-29-54	CLYDE S. DAVIS

TRACED FROM BLUE PRINT BY DEPARTMENT OF
ENVIRONMENTAL RESOURCES OFFICE OF RESOURCES
MANAGEMENT EBENSBURG DISTRICT
BLUE PRINT ACQUIRED FROM JOHN YOUNG
MINE FOREMAN

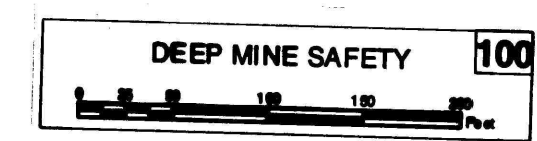

#965
7-16-99
CC