


JACOB SNYDER

M.B. KUNSELMAN

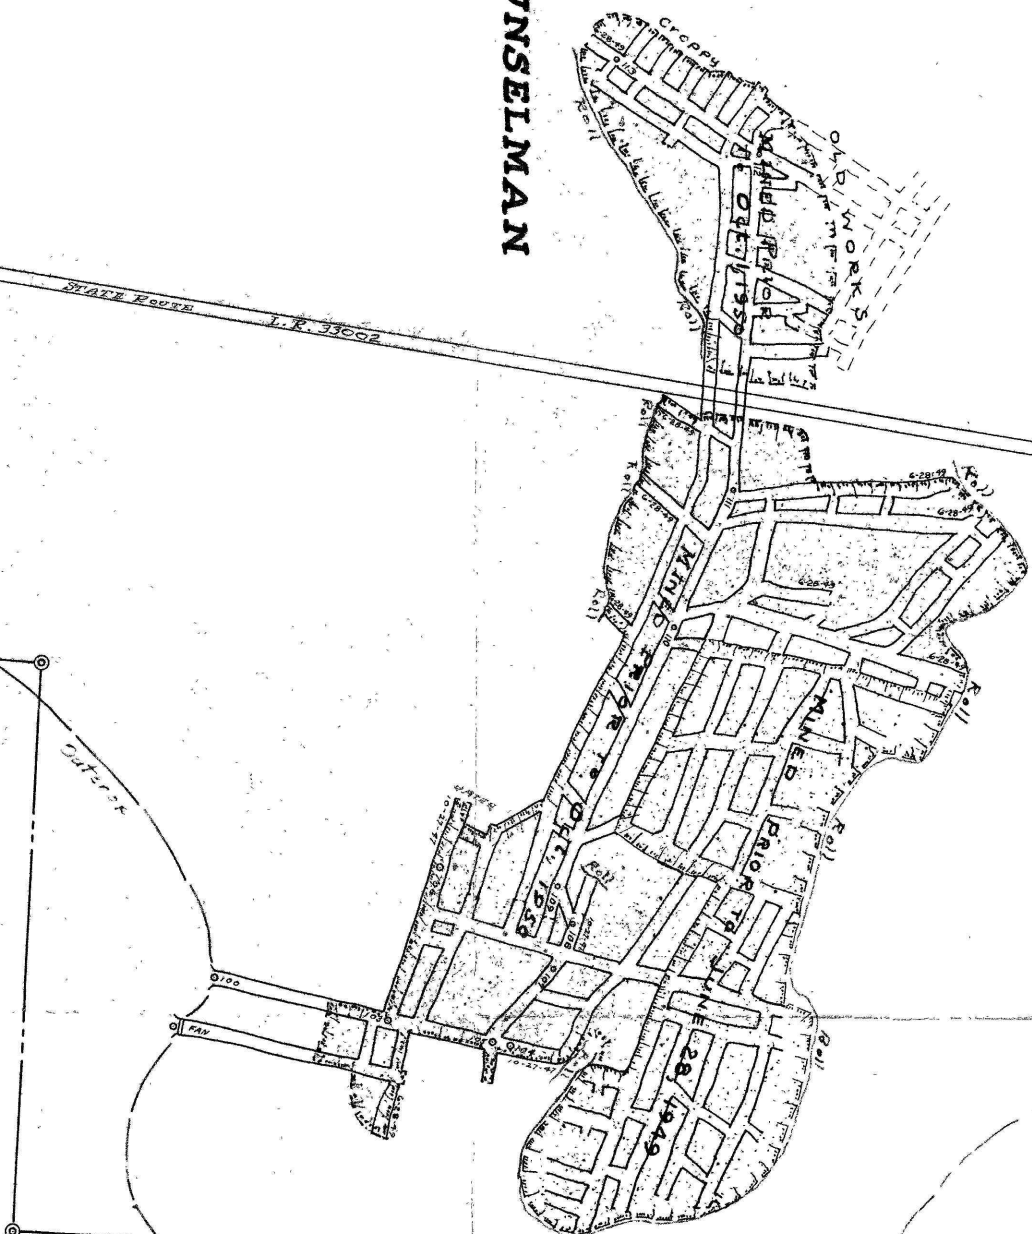

I hereby certify that this is a true and correct copy of the original map of Fairview Coal Co., Mine No. 2, and that the original map is true, complete, and correct map and survey of all the excavations made in said mine.

Walter J. Zimmermann
Walter J. Zimmermann
Reg. Surveyor No. 4940

FAIRVIEW COAL CO.
MINE NO. 2

PORTER TOWNSHIP, JEFFERSON COUNTY, PA.

SCALE 1" = 100'
OCTOBER 1947
WALTER J. ZIMMERMAN SURVEYOR PUNXSUTAWNEY, PA.

General Survey
June 28, 1949

