U.S. GEOLOGICAL SURVEY
GEORGE OTIS SMITH, DIRECTOR

TOPOGRAPHY

PENNSYLVANIA
MASONTOWN QUADRANGLE

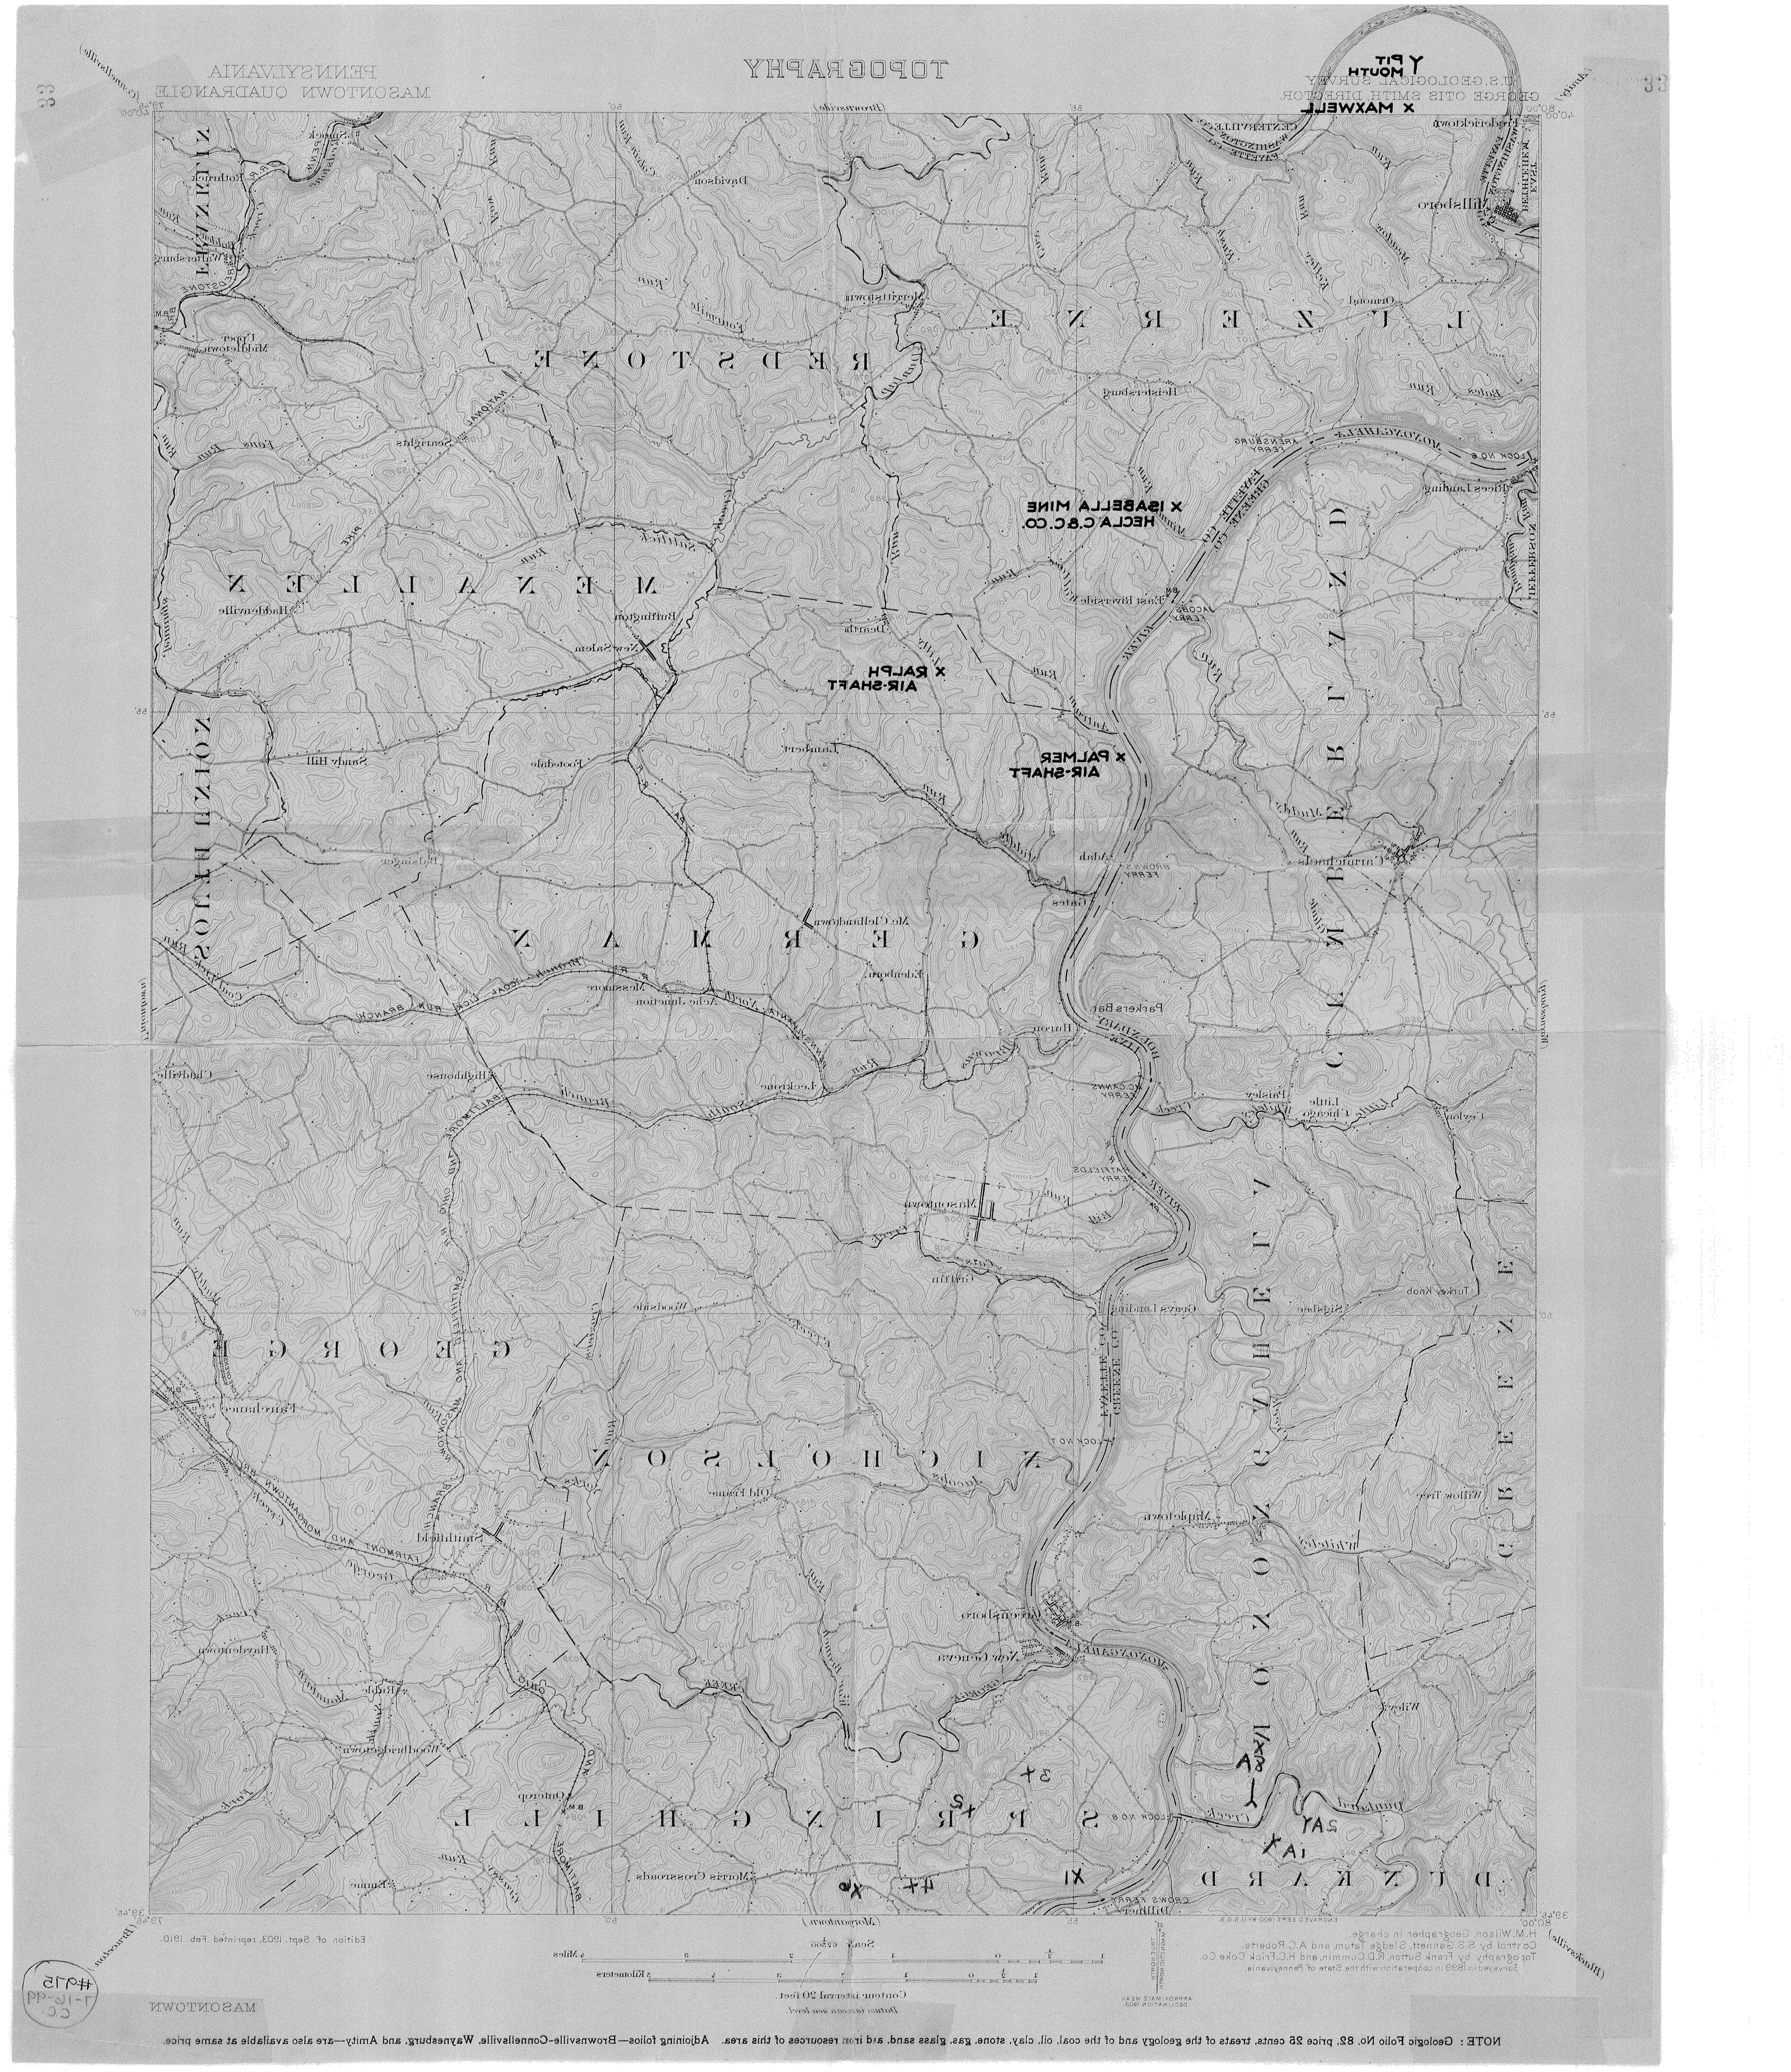
Y PIT MOUTH
X MAXWELL
X ISABELLA MINE
HECLA C.&C.CO.
X RALPH AIR-SHAFT
X PALMER AIR-SHAFT
LUZERNE
REDSTONE
MENALLEN
GERMAN
GEORGE
NICHOLSON
SPRINGHILL
DUNKARD
CUMBERLAND
MONONGAHELA
GREENE
SOUTH UNION
FRANKLIN
MONONGAHELA RIVER
Masontown
Greensboro
New Geneva
Smithfield
Carmichaels
Millsboro
Fredericktown
New Salem
Point Marion
Morris Crossroads
Scale 1/62500
Contour interval 20 feet.
Datum is mean sea level.

H.M.Wilson, Geographer in charge.
Control by S.S.Gannett, Sledge Tatum, and A.C.Roberts.
Topography by Frank Sutton, R.D.Cummin, and H.C.Frick Coke Co.
Surveyed in 1899 in cooperation with the State of Pennsylvania.

Edition of Sept. 1903, reprinted Feb. 1910.

MASONTOWN

#915
1-16-99
C.C.

NOTE: Geologic Folio No. 82, price 25 cents, treats of the geology and of the coal, oil, clay, stone, gas, glass sand, and iron resources of this area. Adjoining folios—Brownsville-Connellsville, Waynesburg, and Amity—are also available at same price.