


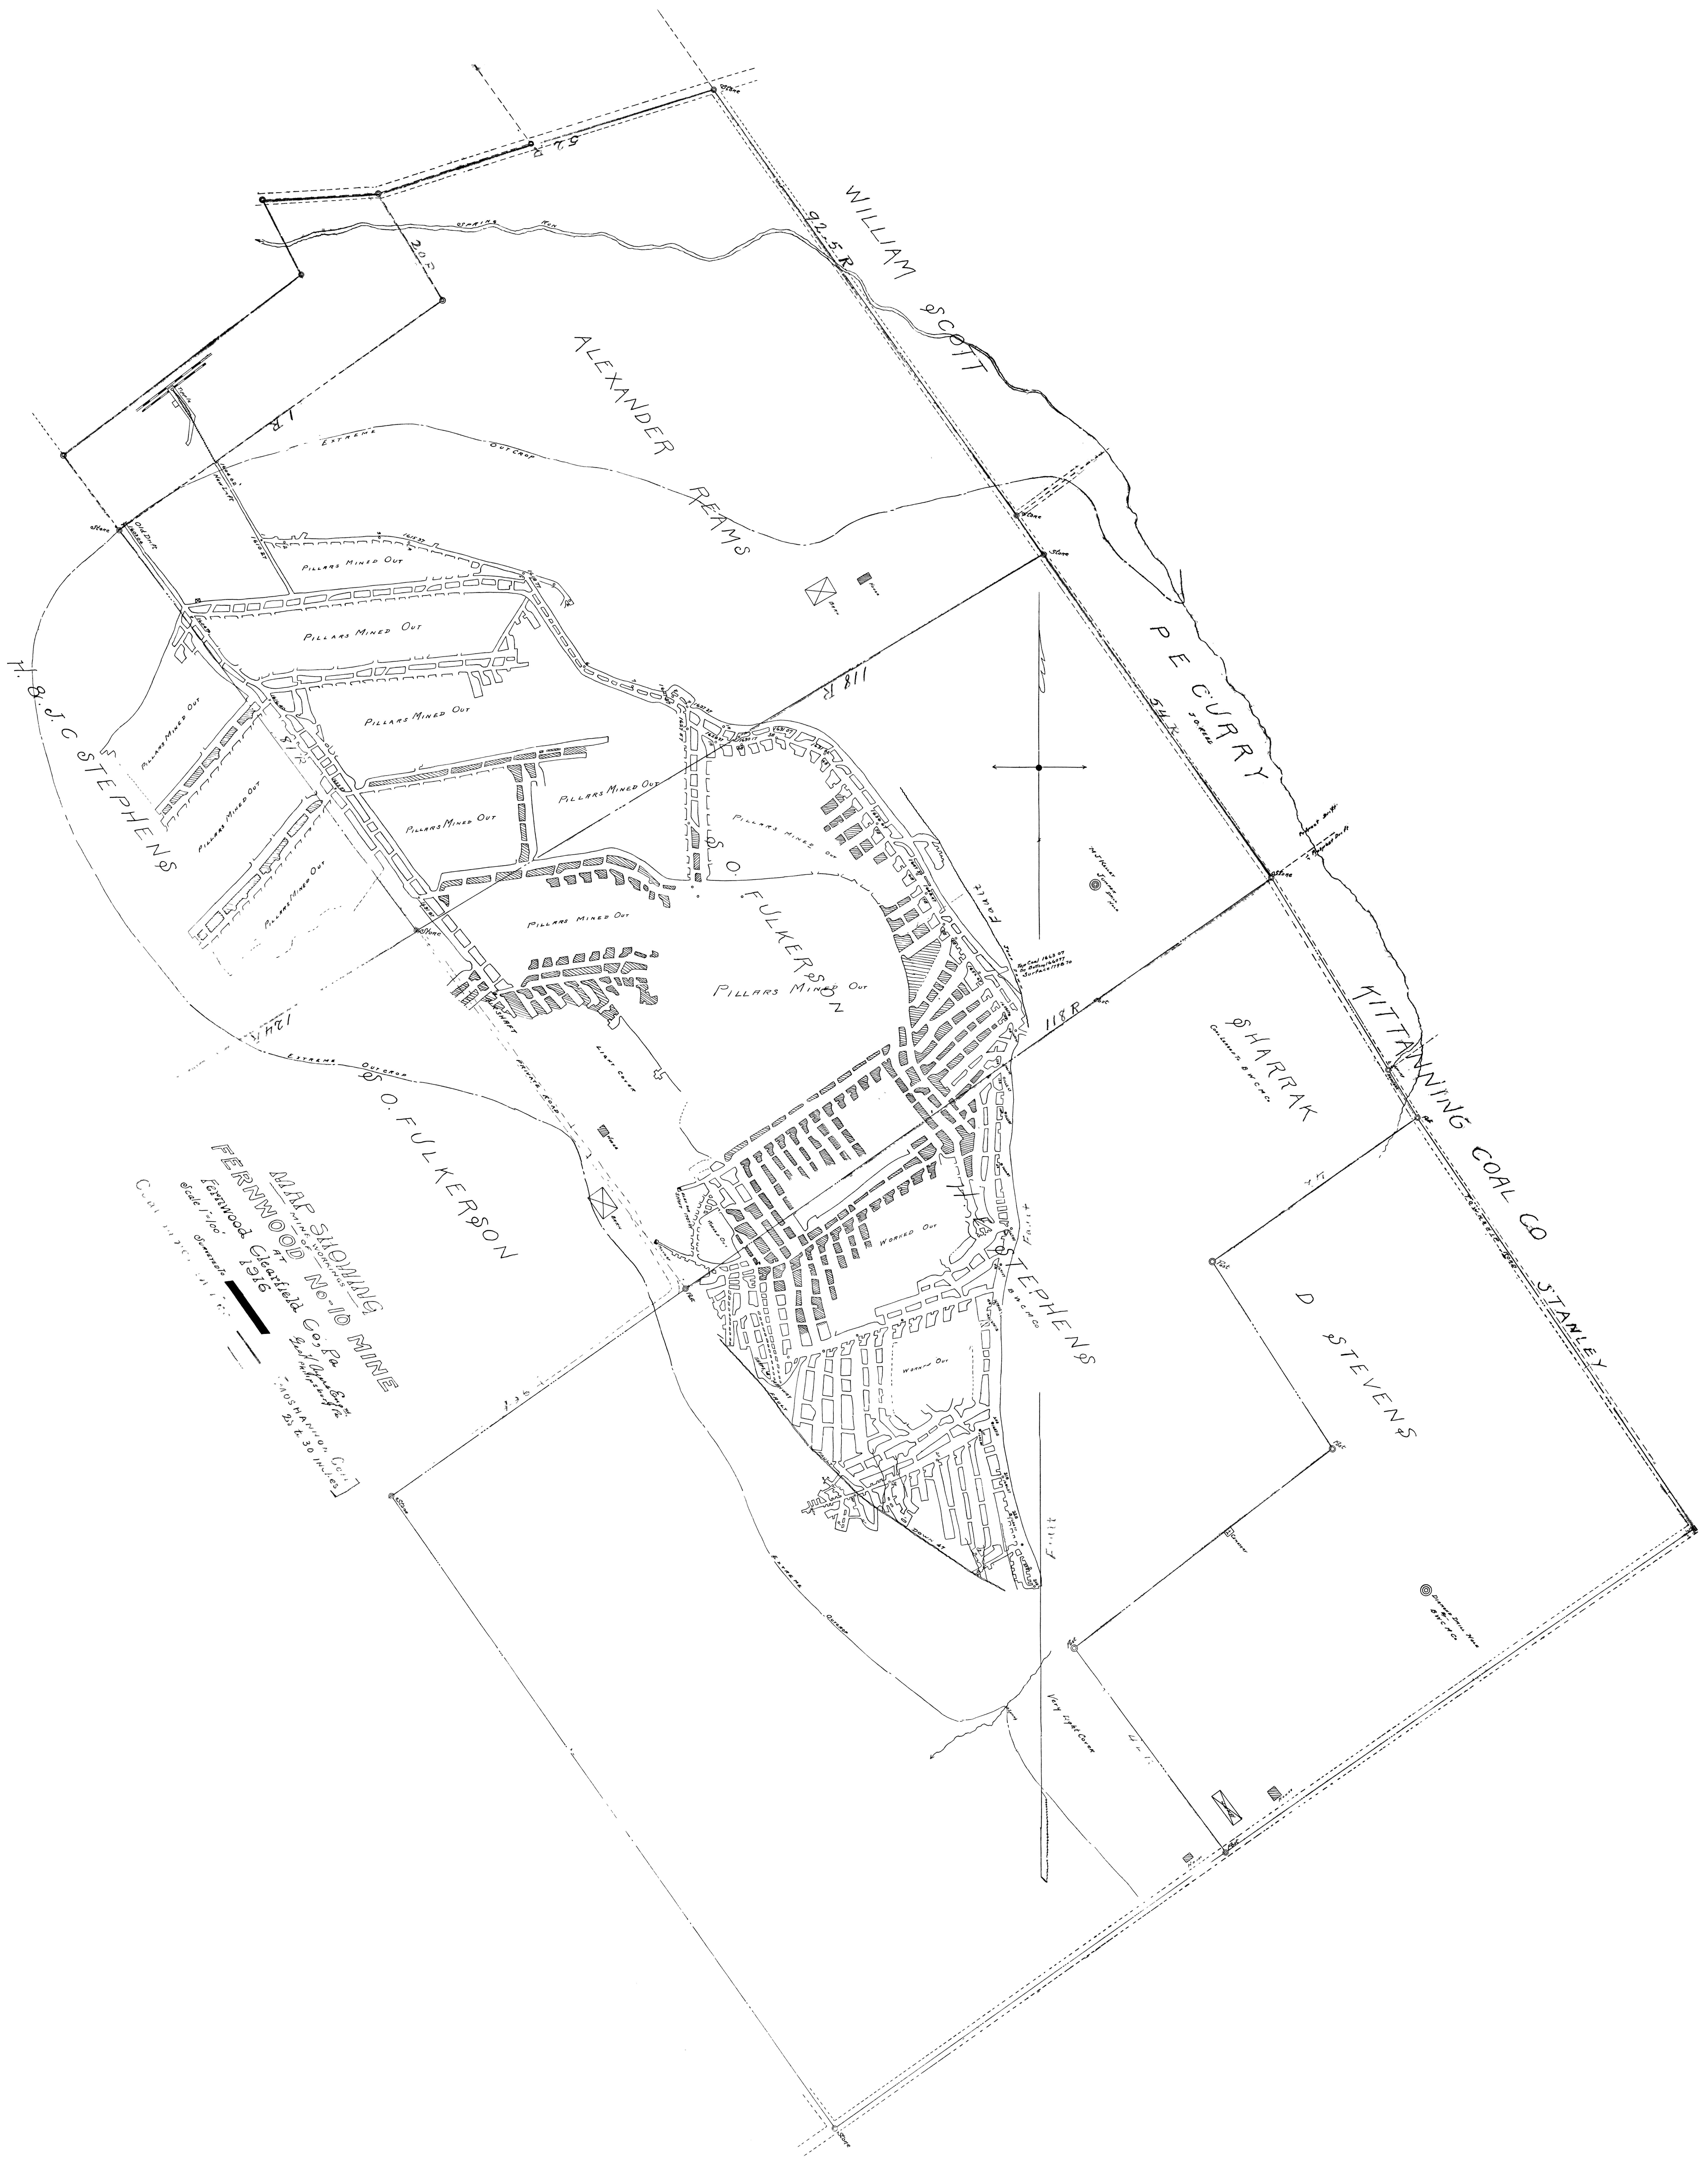

MAP SHOWING
FERNWOOD No. 10 MINE
at
Fernwood, Clearfield Co., Pa.
Scale 1" = 100' 1916
