


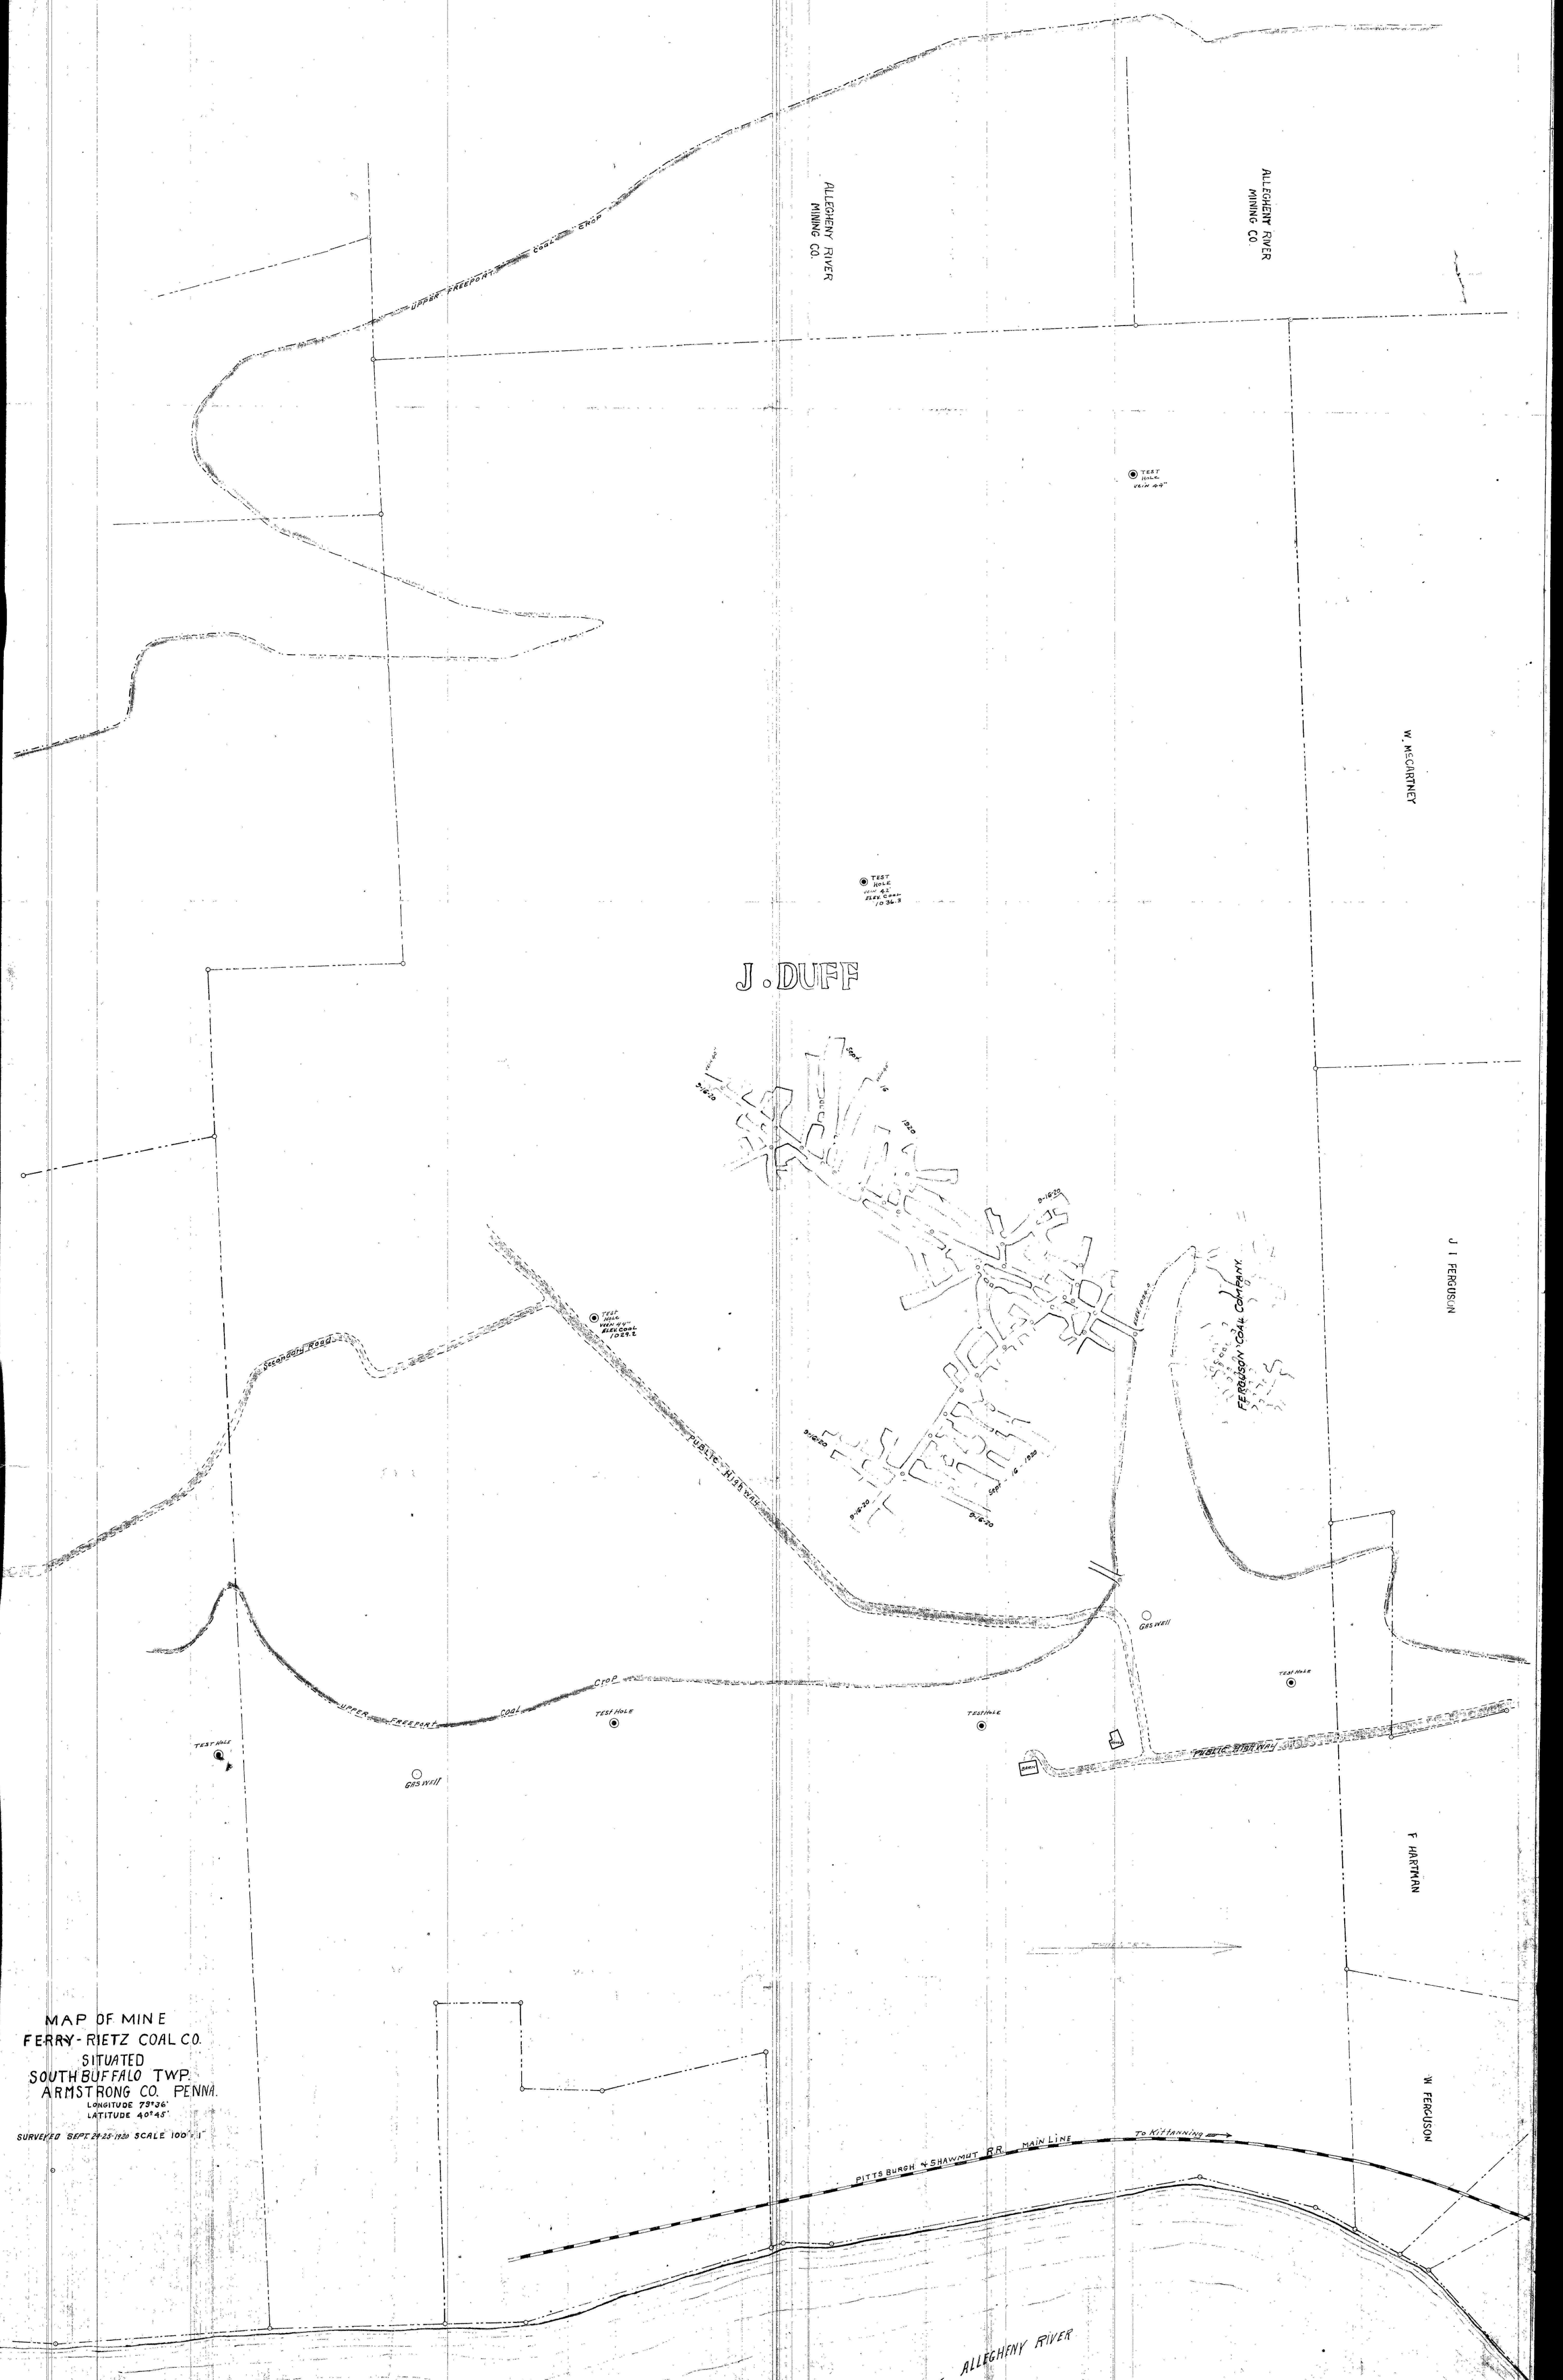

MAP OF MINE
FERRY-RIETZ COAL CO.
SITUATED
SOUTH BUFFALO TWP
ARMSTRONG CO. PENNA.
LONGITUDE 79°36'
LATITUDE 40°45'
