


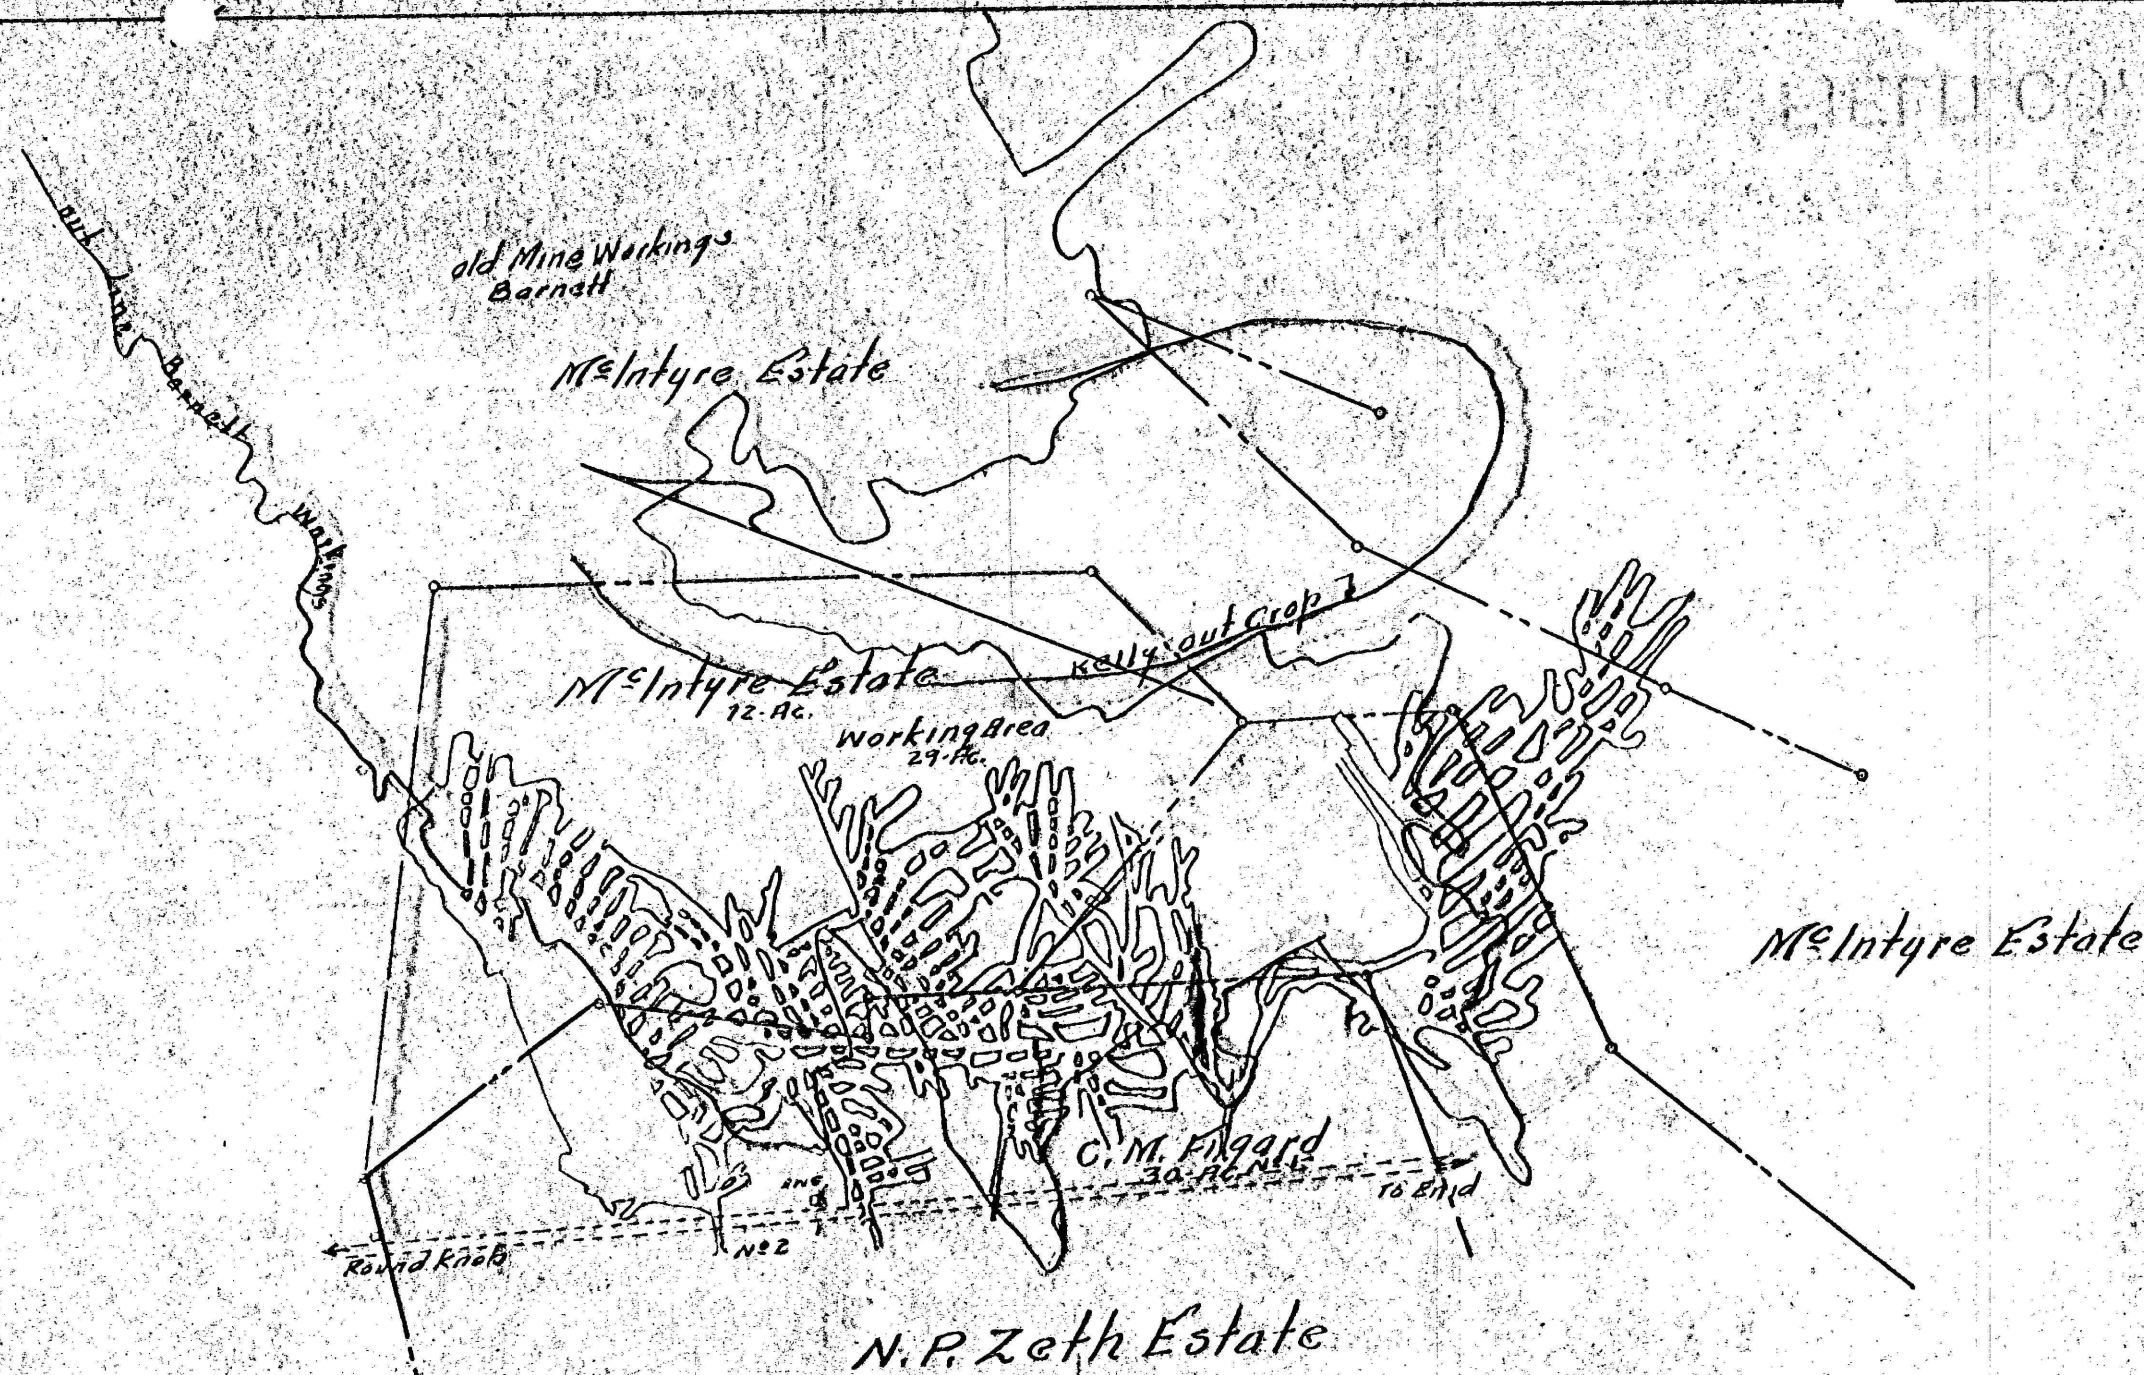

Map Showing Boundary of Figard No. 1 Mine operated by Ritchey Brothers Coal Co. Situated in Broad Top Twp. Bedford County
 Pennsylvania Aug - 1966 E. Corrie Engr. 1" = 500'