


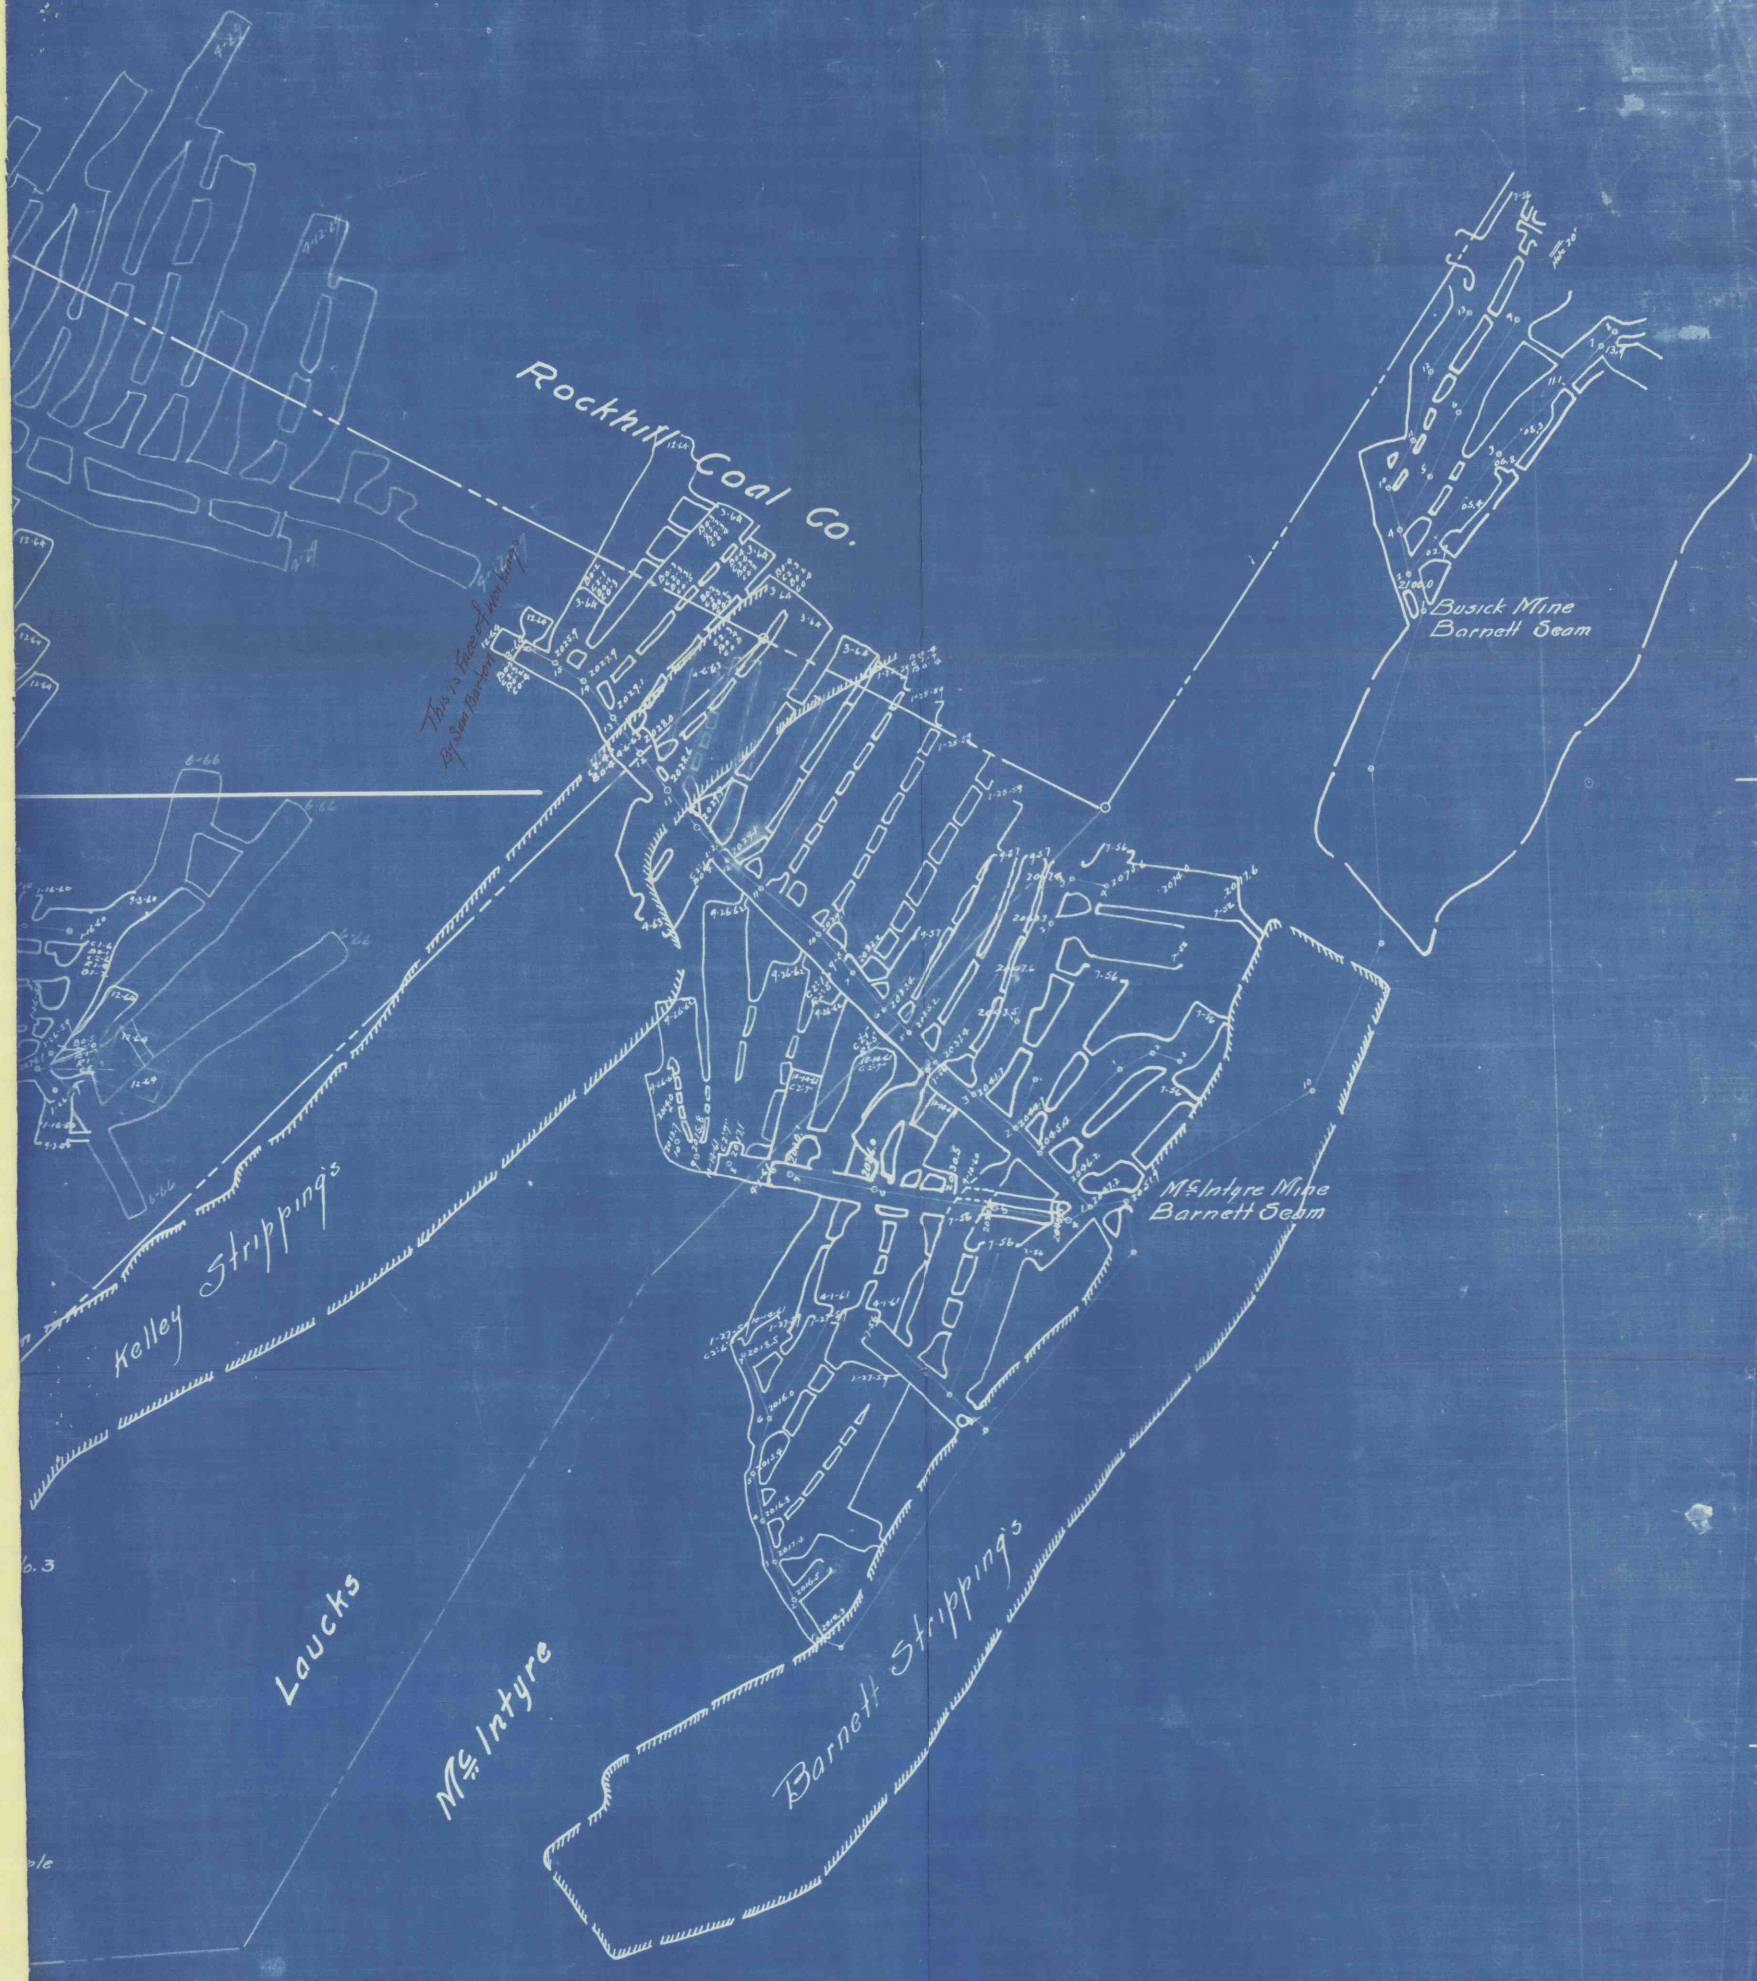

Figand 4

316592

Map showing Barnett Strippings on McIntyre property in Bedford Co. Pa. 1"=100' E. Corrie