

STATE OF PENNSYLVANIA,)
COUNTY OF JEFFERSON. (


Fred D. Sayer, a Registered Professional Engineer in the State of Pennsylvania, first being sworn according to law does depose and say that this survey of mine situate in Oliver Township, Jefferson County, Pa., is true and correct according to surveys made and makes this affidavit to the end that it may be recorded as such.

Fred D. Sayer

Sworn and Subscribed to before me this 12, day of December A.D., 1947

Mary E. Ralston
NOTARY PUBLIC

My Commission Expires JANUARY 21, 1951

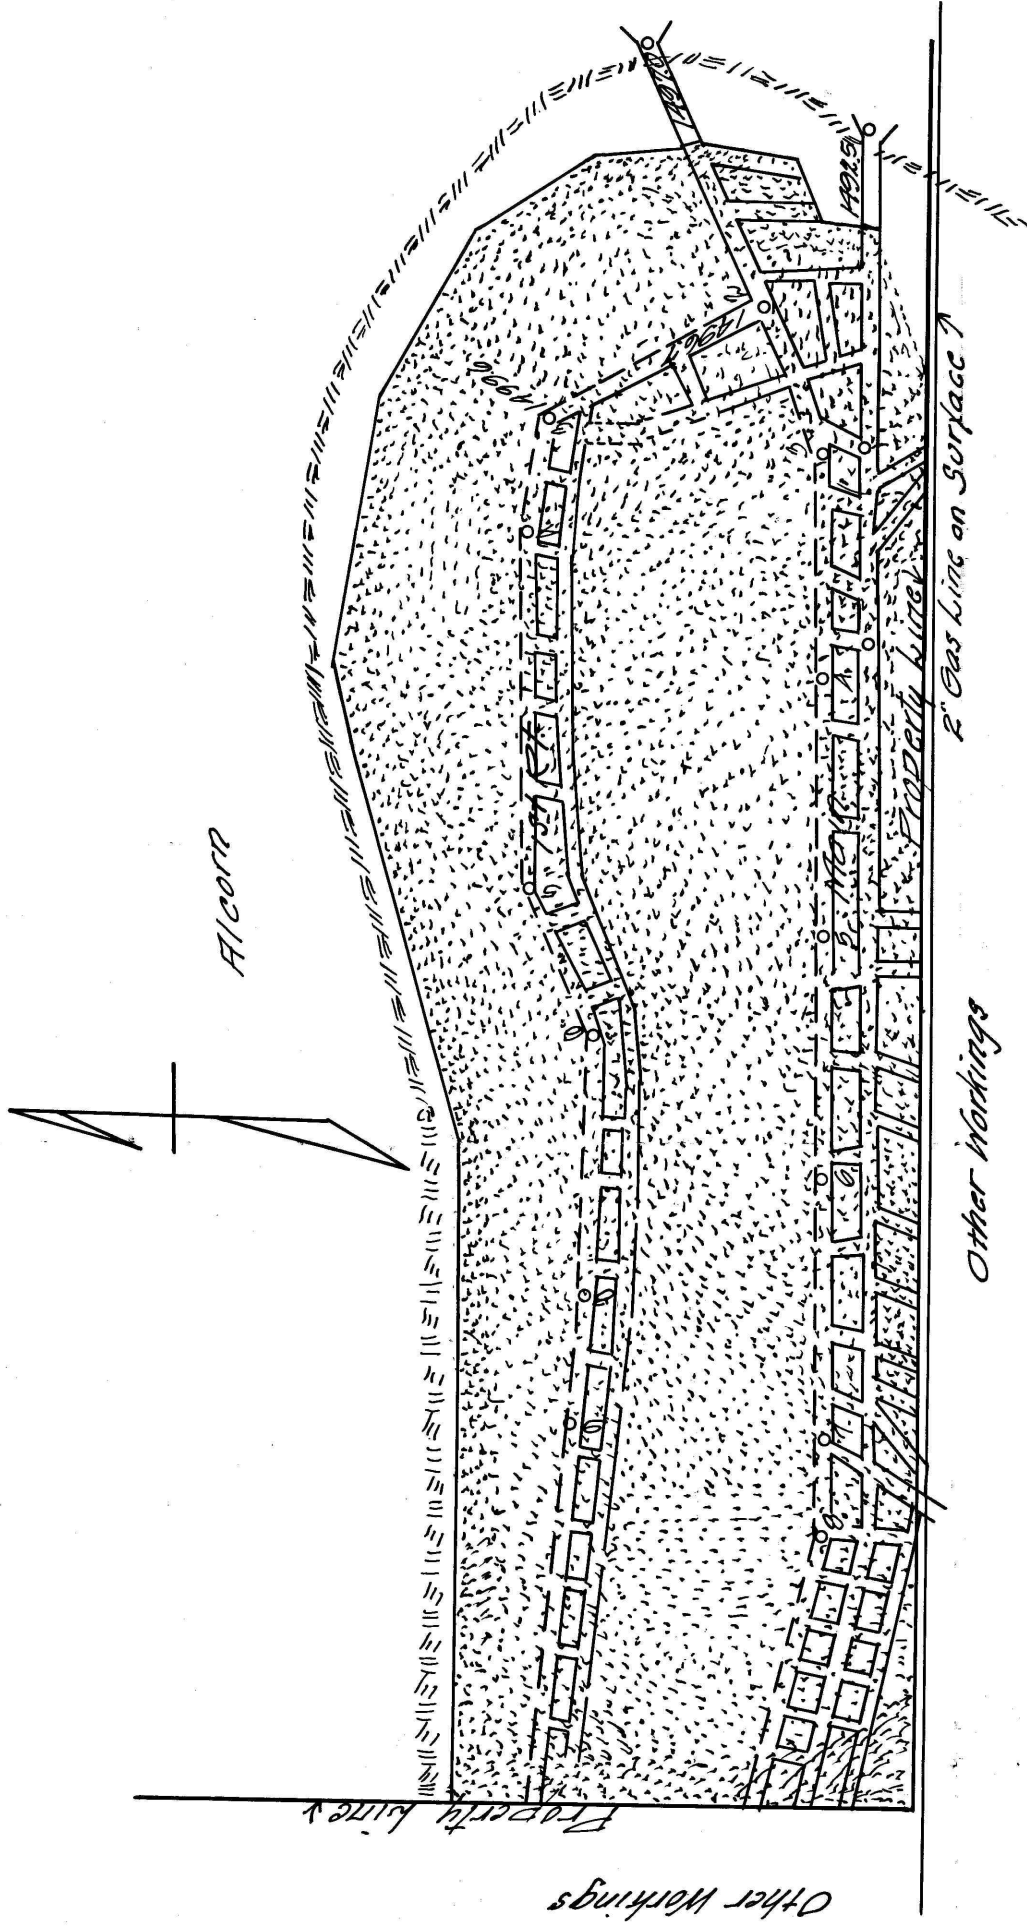

Fike Mine #3
Oliver Twp. Jefferson Co., Pa.
Scale 1"=100' October 30, 1947

#994
7-19-99
C.C.