


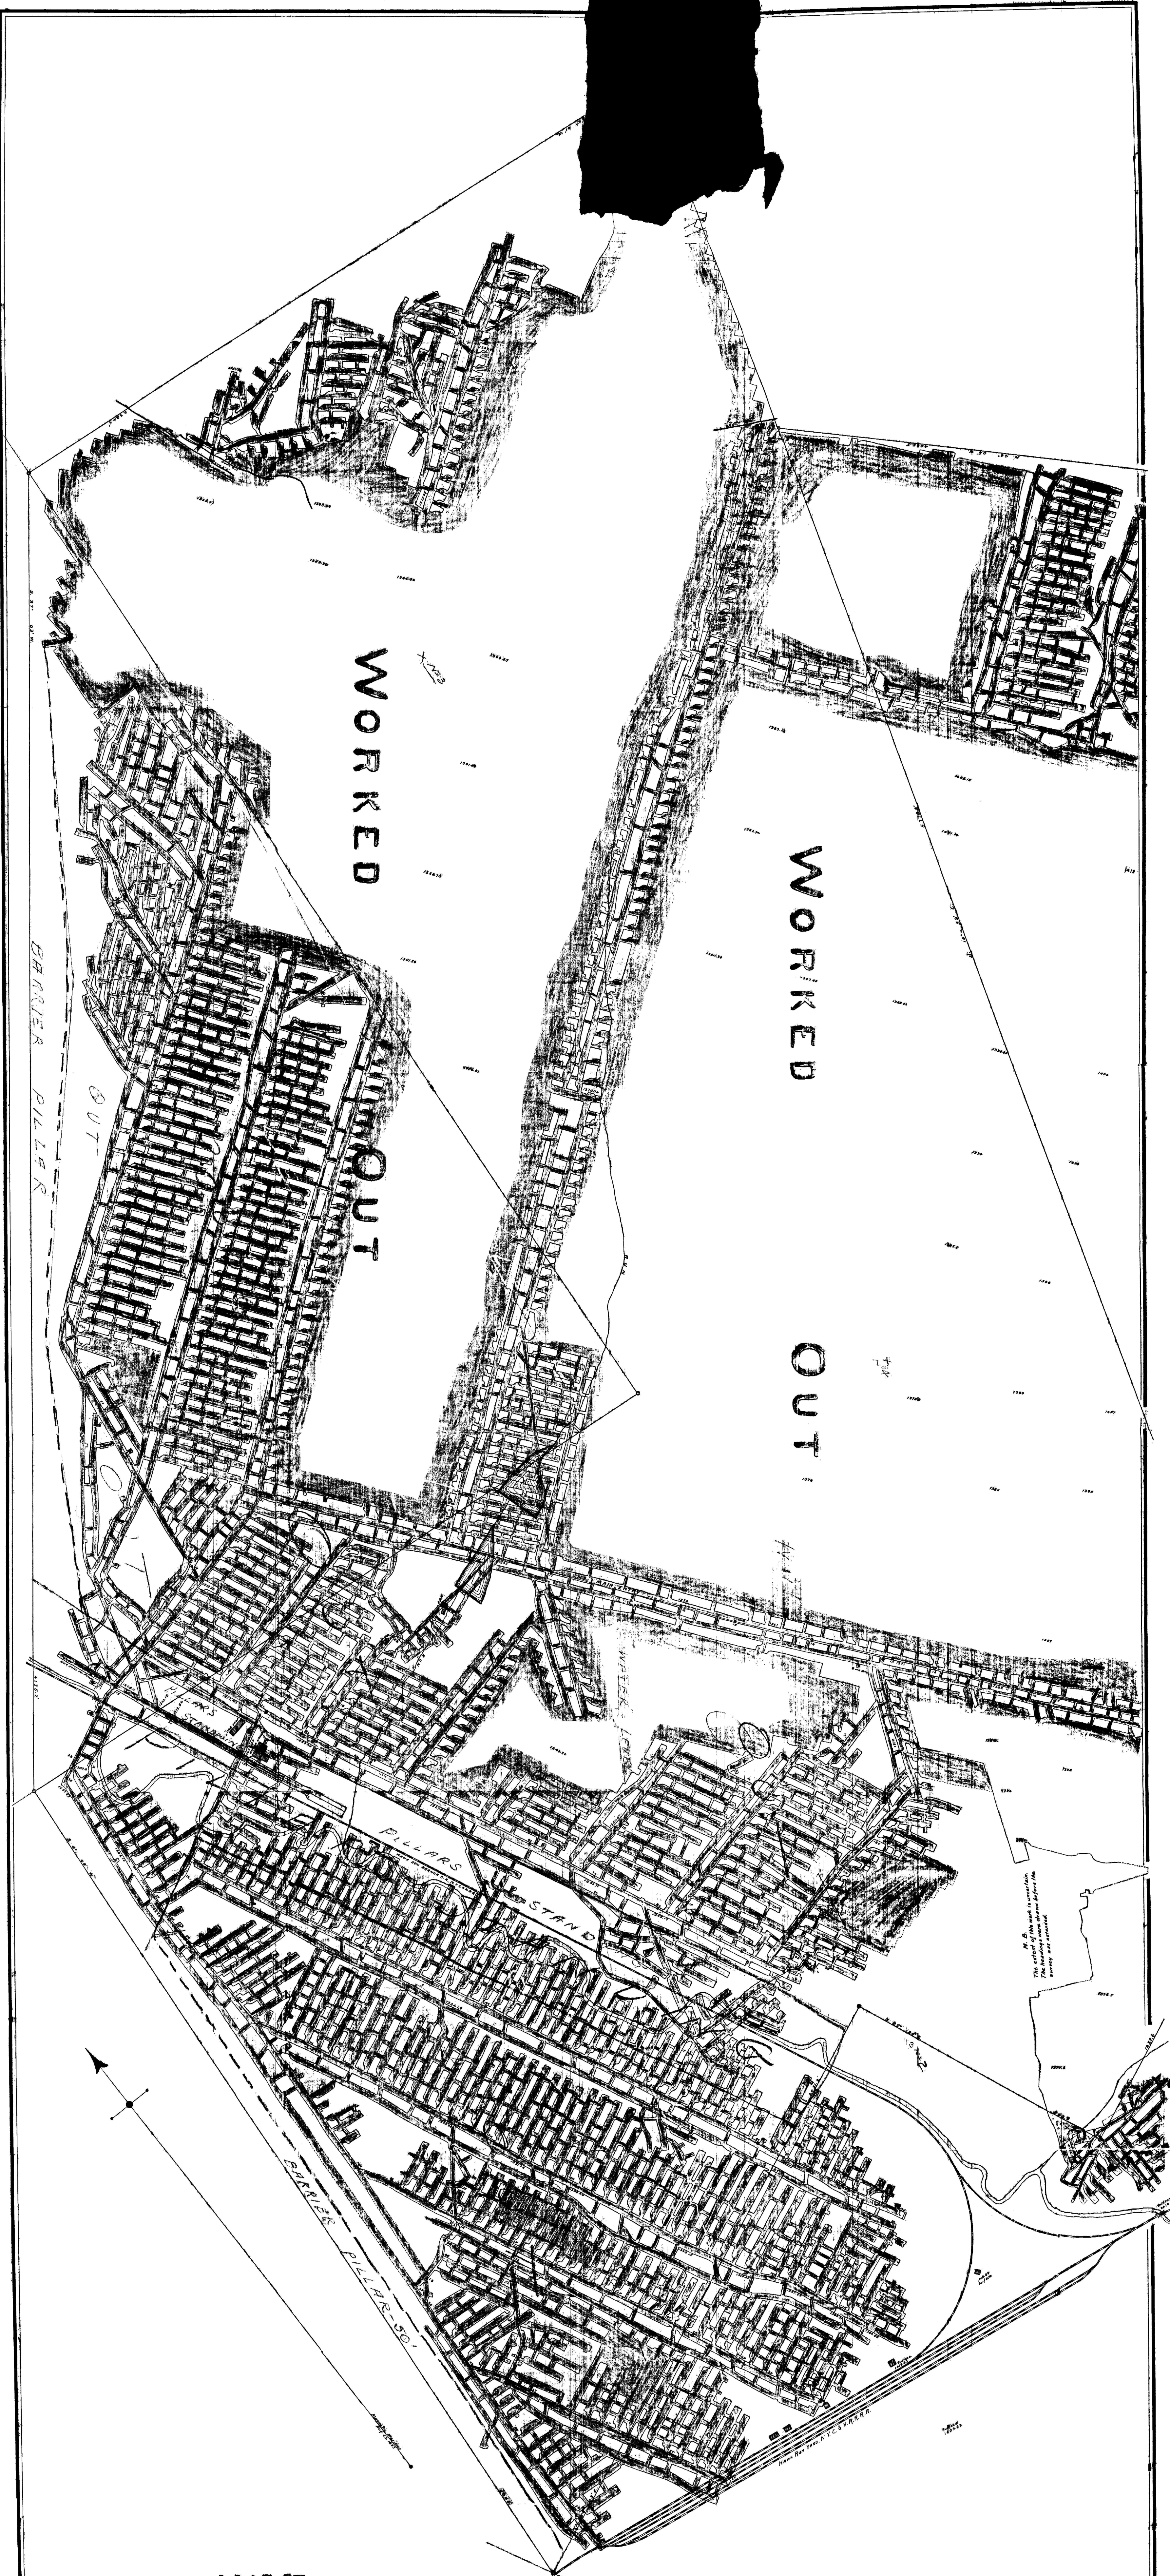



Scale, 1 in = 100 ft.

