
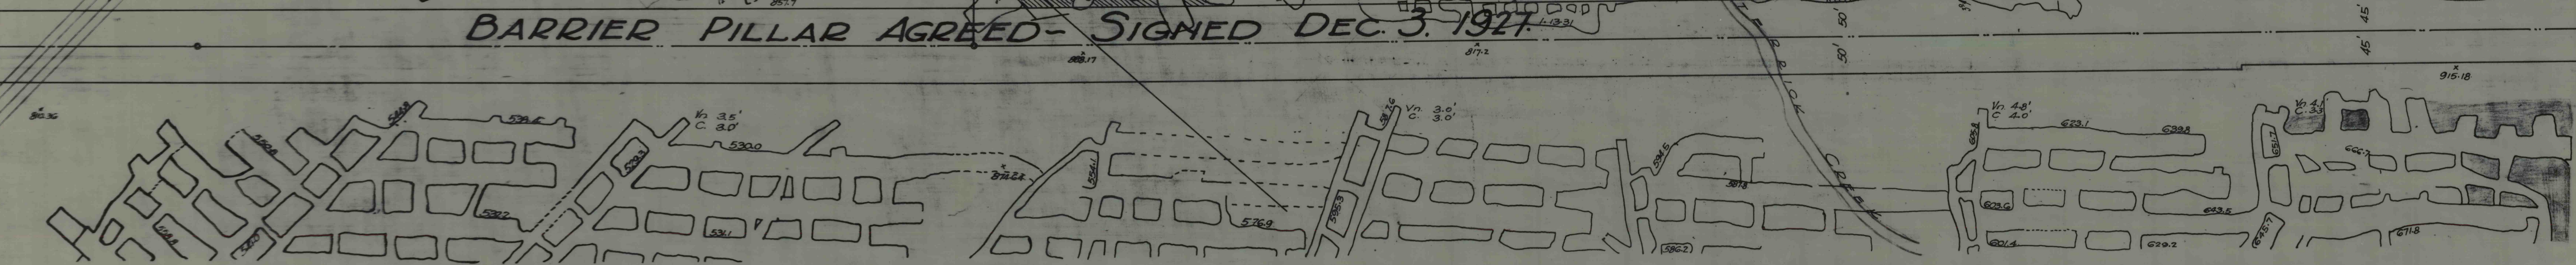


LACKA COAL CO.

LACKAWANNA RIVER

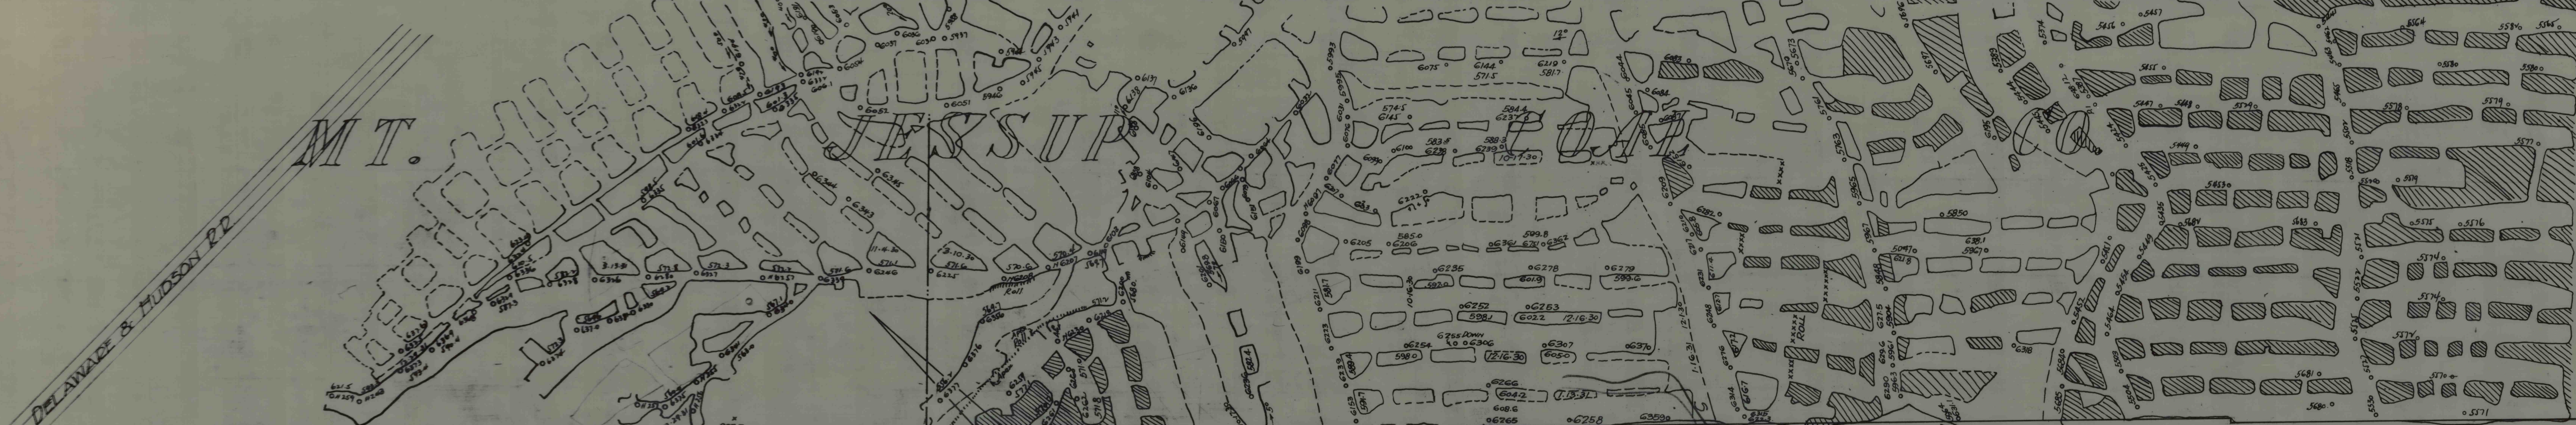

THE HUDSON COAL CO.

STERRICK CREEK COAL CO.

BARRIER PILLAR AGREEMENT - NEW COUNTY BED.

Scale 1" = 100' Date - April 16, 1932.

THE HUDSON COAL CO. COLLIERY, _____

By _____

MT. JESSUP COAL CO. COLLIERY, _____

By _____ MINING ENGINEER.

INSPECTOR OF MINES DISTRICT _____