


LACKAWANNA COAL CO.

LACKAWANNA

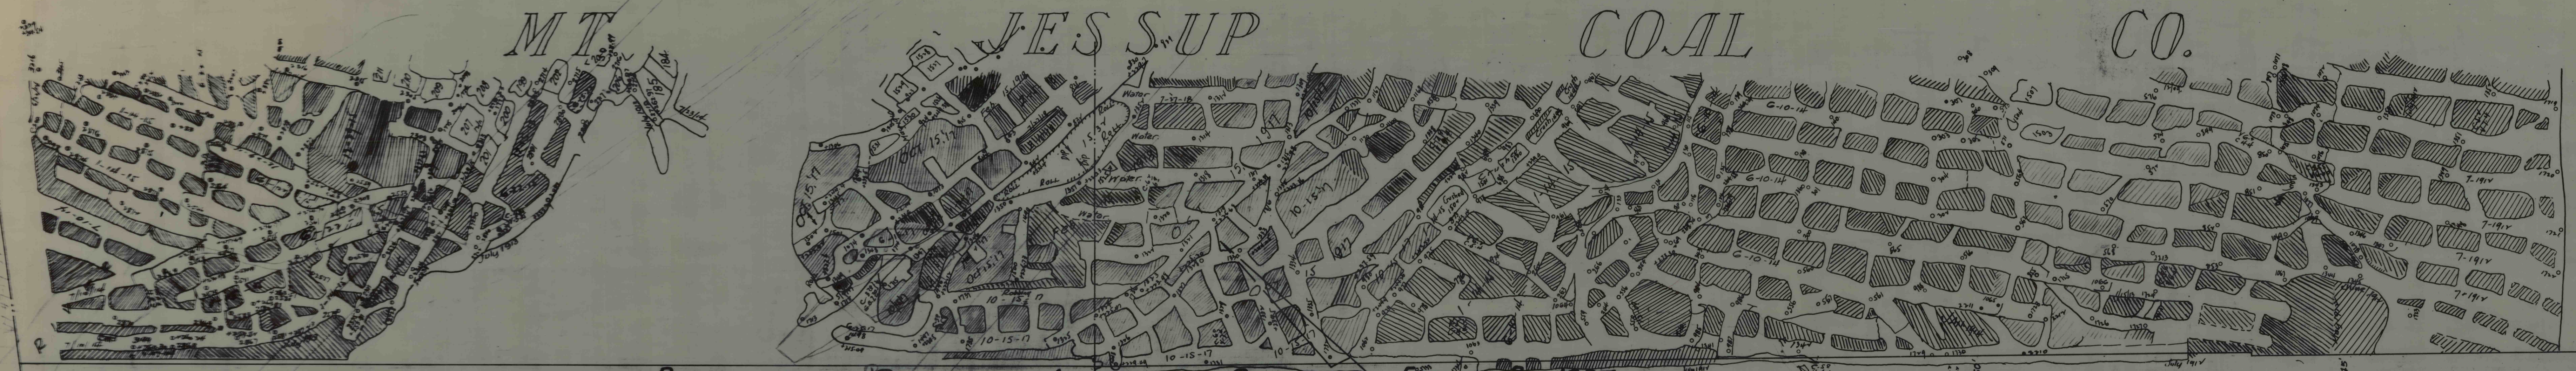

BARRIER PILLAR AGREED - SIGNED DEC. 3, 1927

THE HUDSON COAL CO.

**BARRIER PILLAR AGREEMENT
DUNMORE No 3 BED**

Scale 1" = 100' Date - April 16, 1932.

THE HUDSON COAL CO.	COLLIERY -----
By-	MINING ENGINEER.
MT. JESSUP COAL CO.	COLLIERY, -----
By-	MINING ENGINEER.
INSPECTOR OF MINES	DISTRICT -----