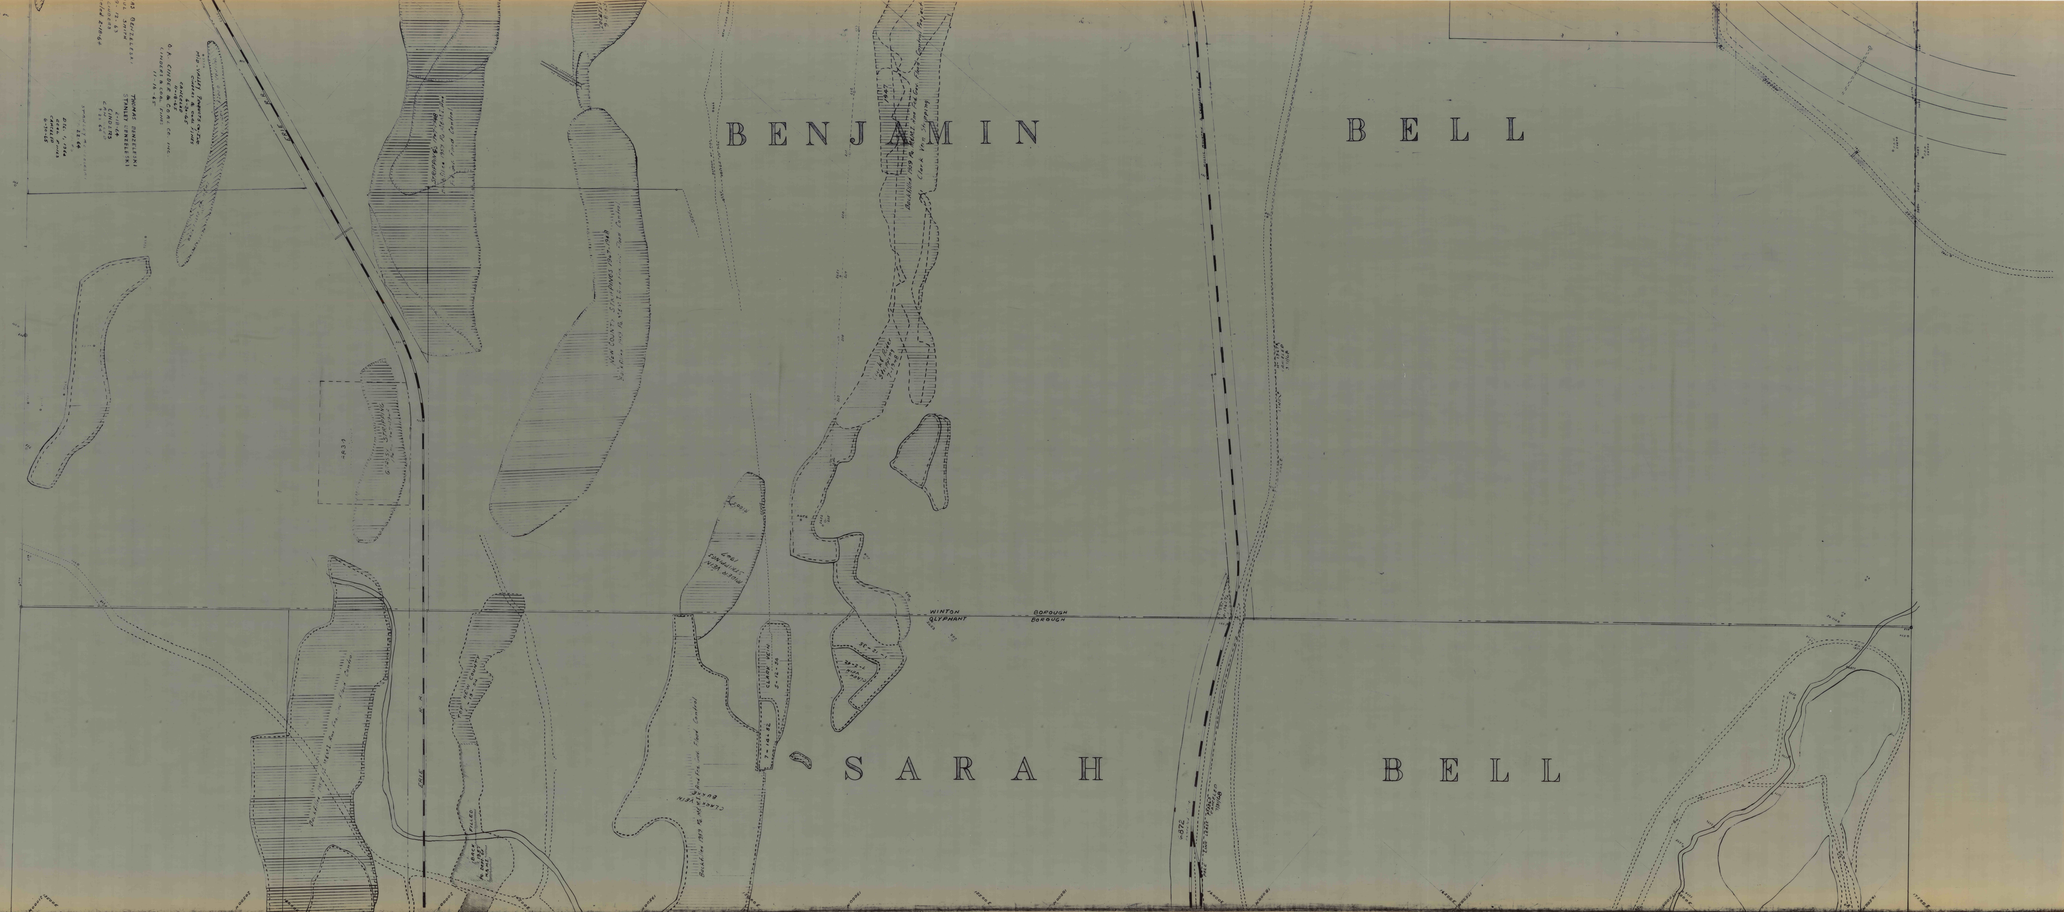

BENJAMIN BELL SURVEYED