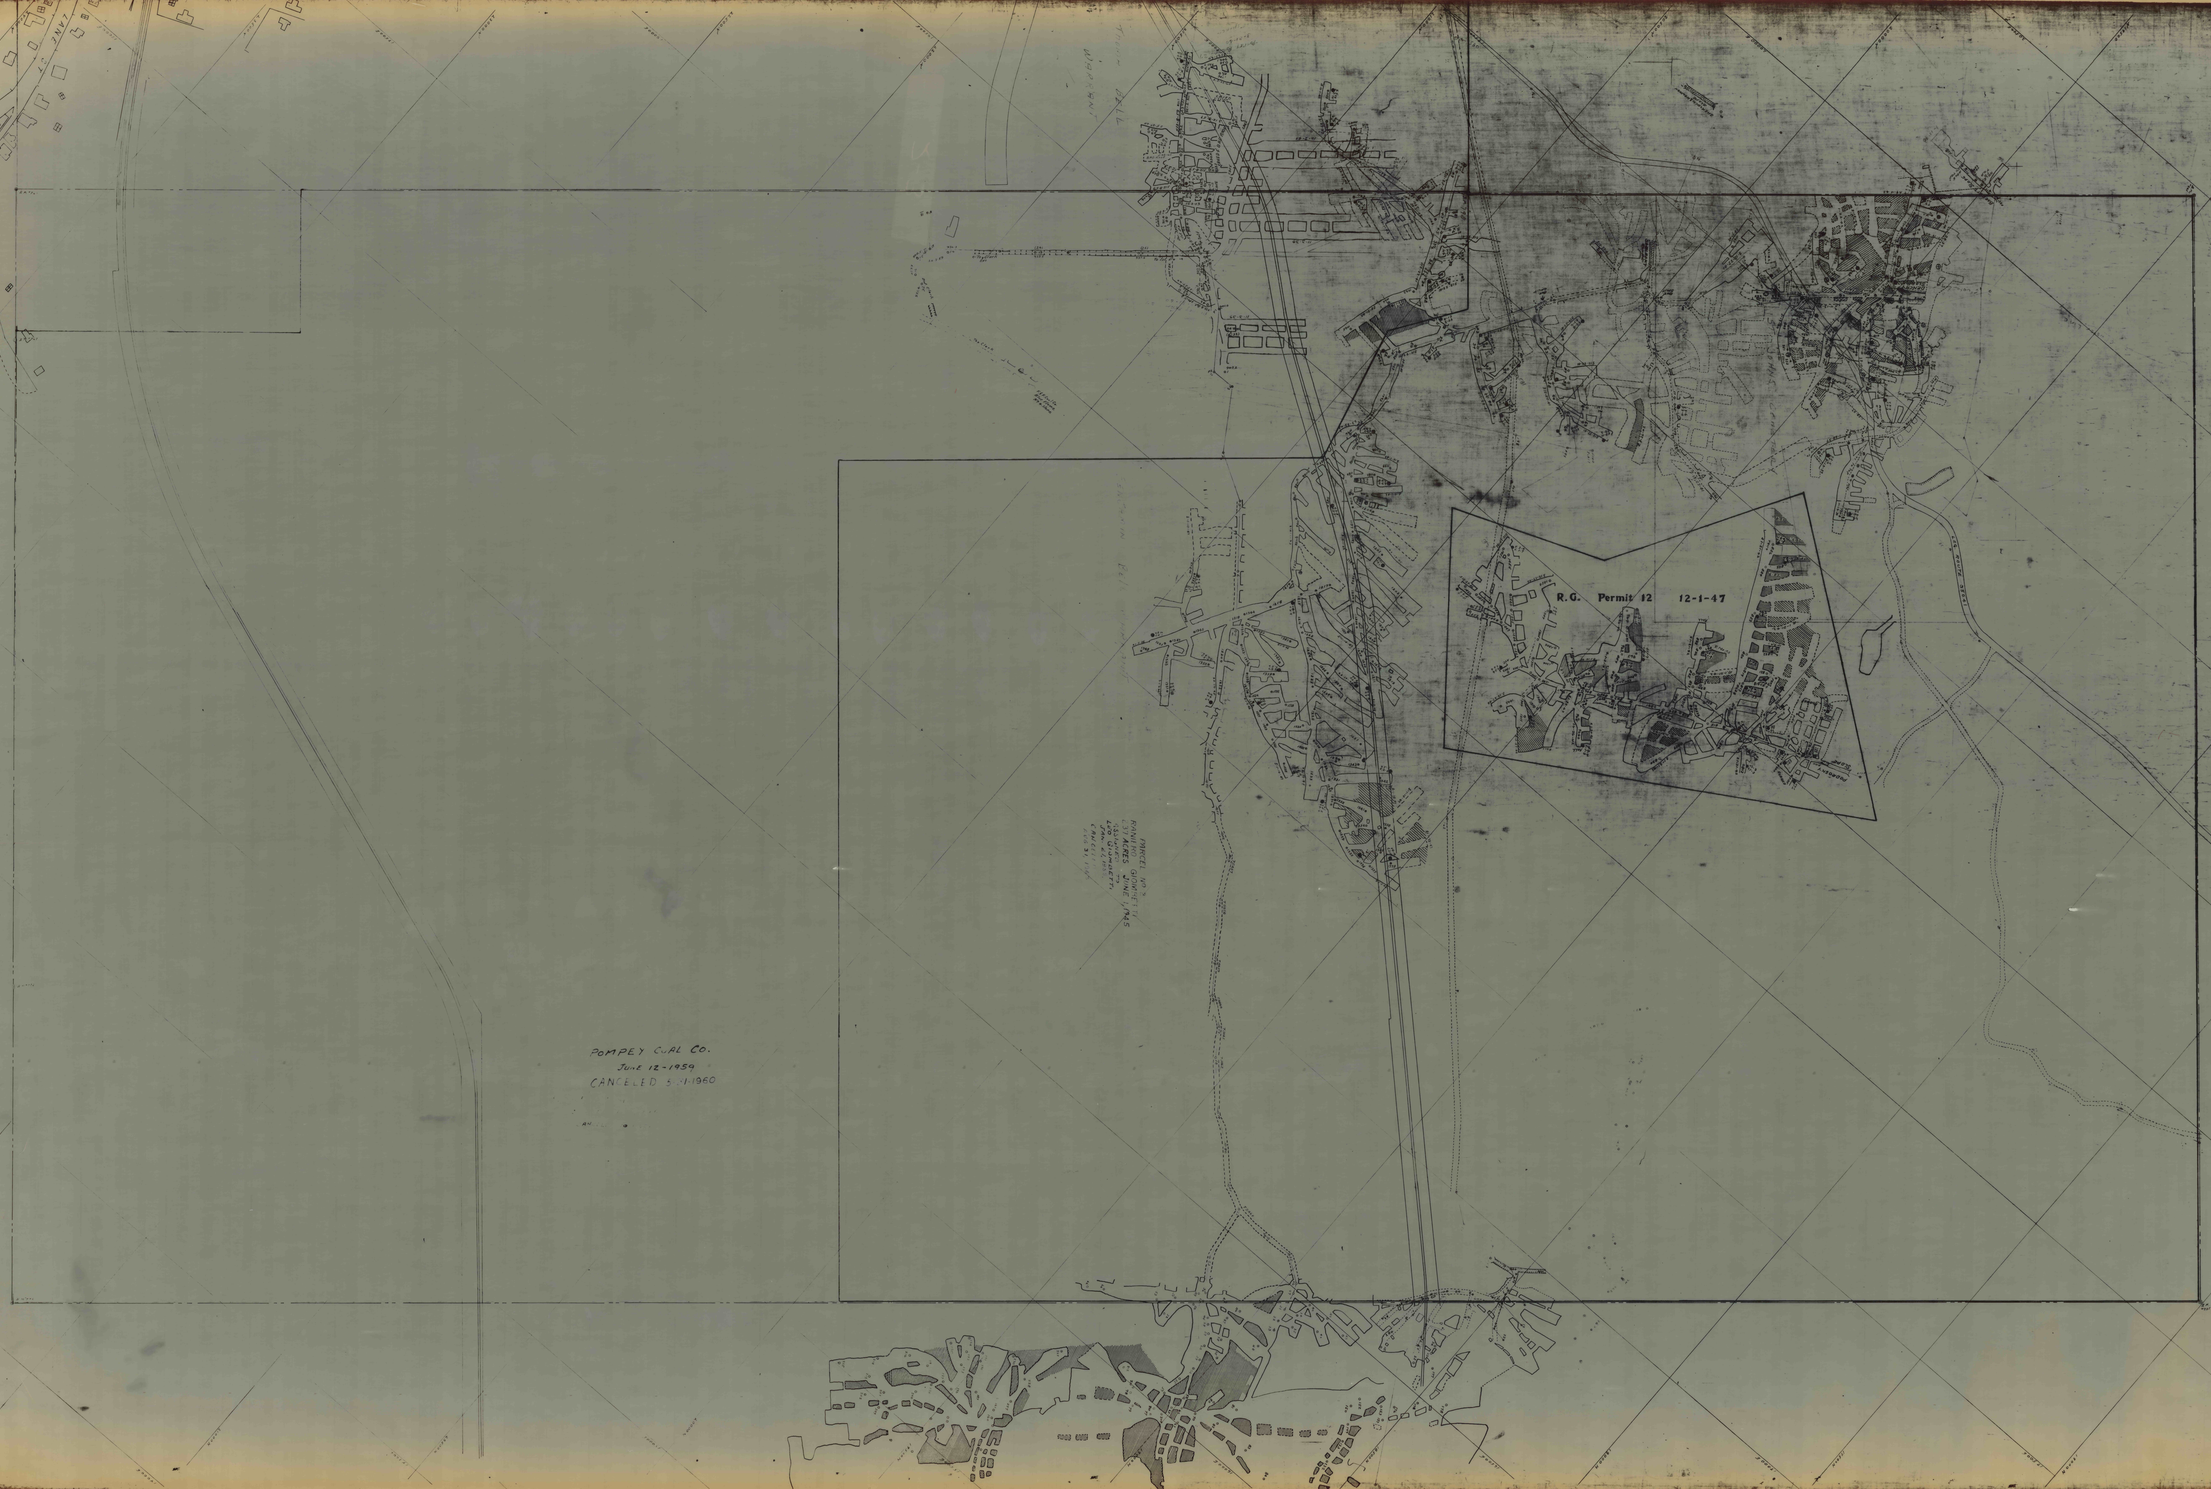

JB-3

WARRANT

BELT
DRAINAGE LEVEL
Bottom No. 1 Drainage
Bottom

BENJAMIN