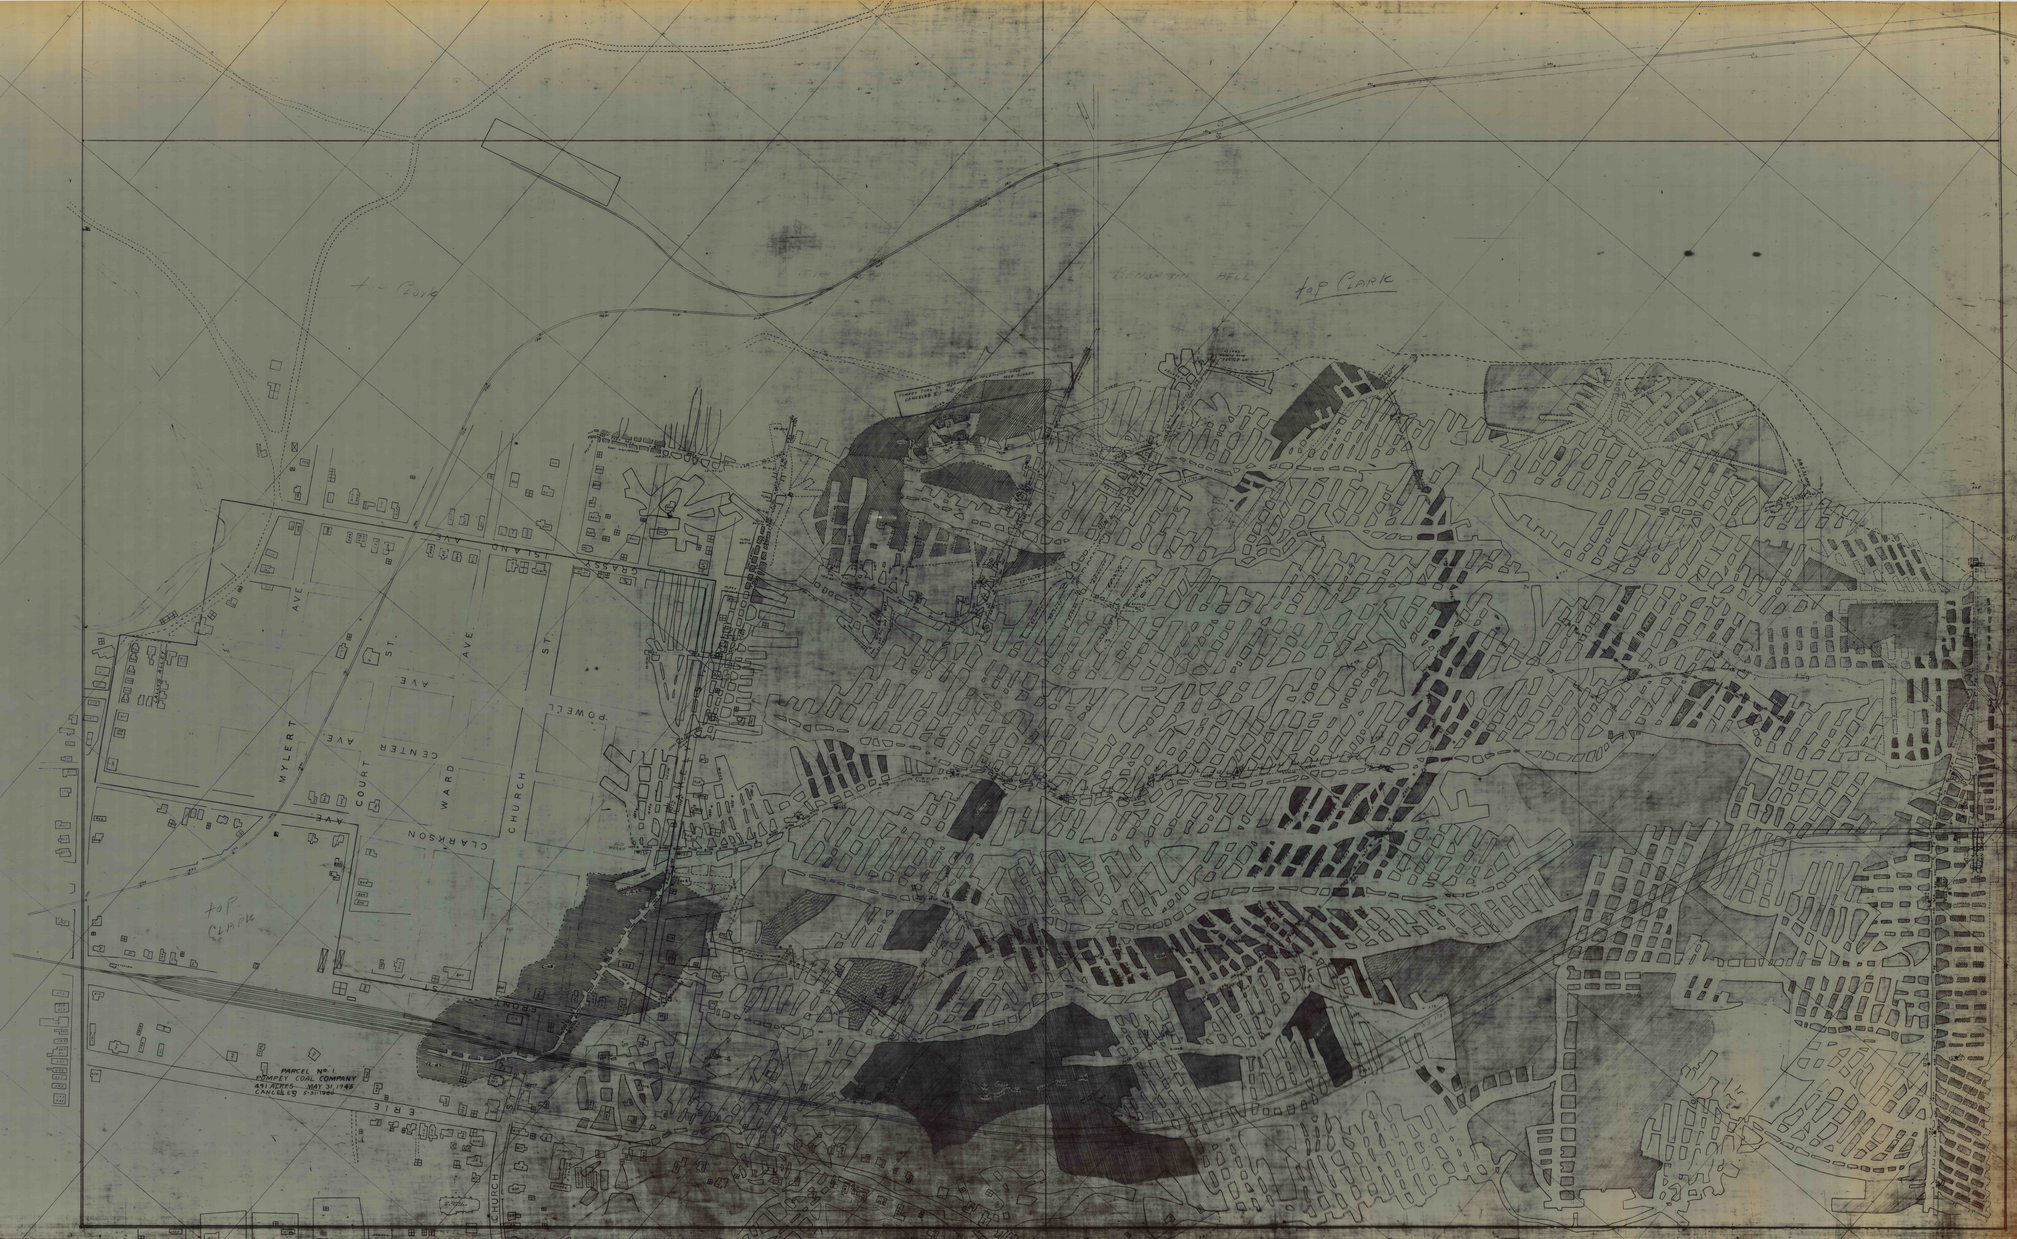
top Clark
top Clark
top Clark
MYLERT AVE
COURT AVE
CENTER AVE
WARD ST.
CLARKSON AVE
CHURCH ST.
POWELL AVE
ISLAND AVE
GRASSY
ERIE
PARCEL No. 1
DYMPEL COAL COMPANY
491 ACRES - MAY 31, 1988
CANCELED 5-31-1990