



N.B. SHAFT.

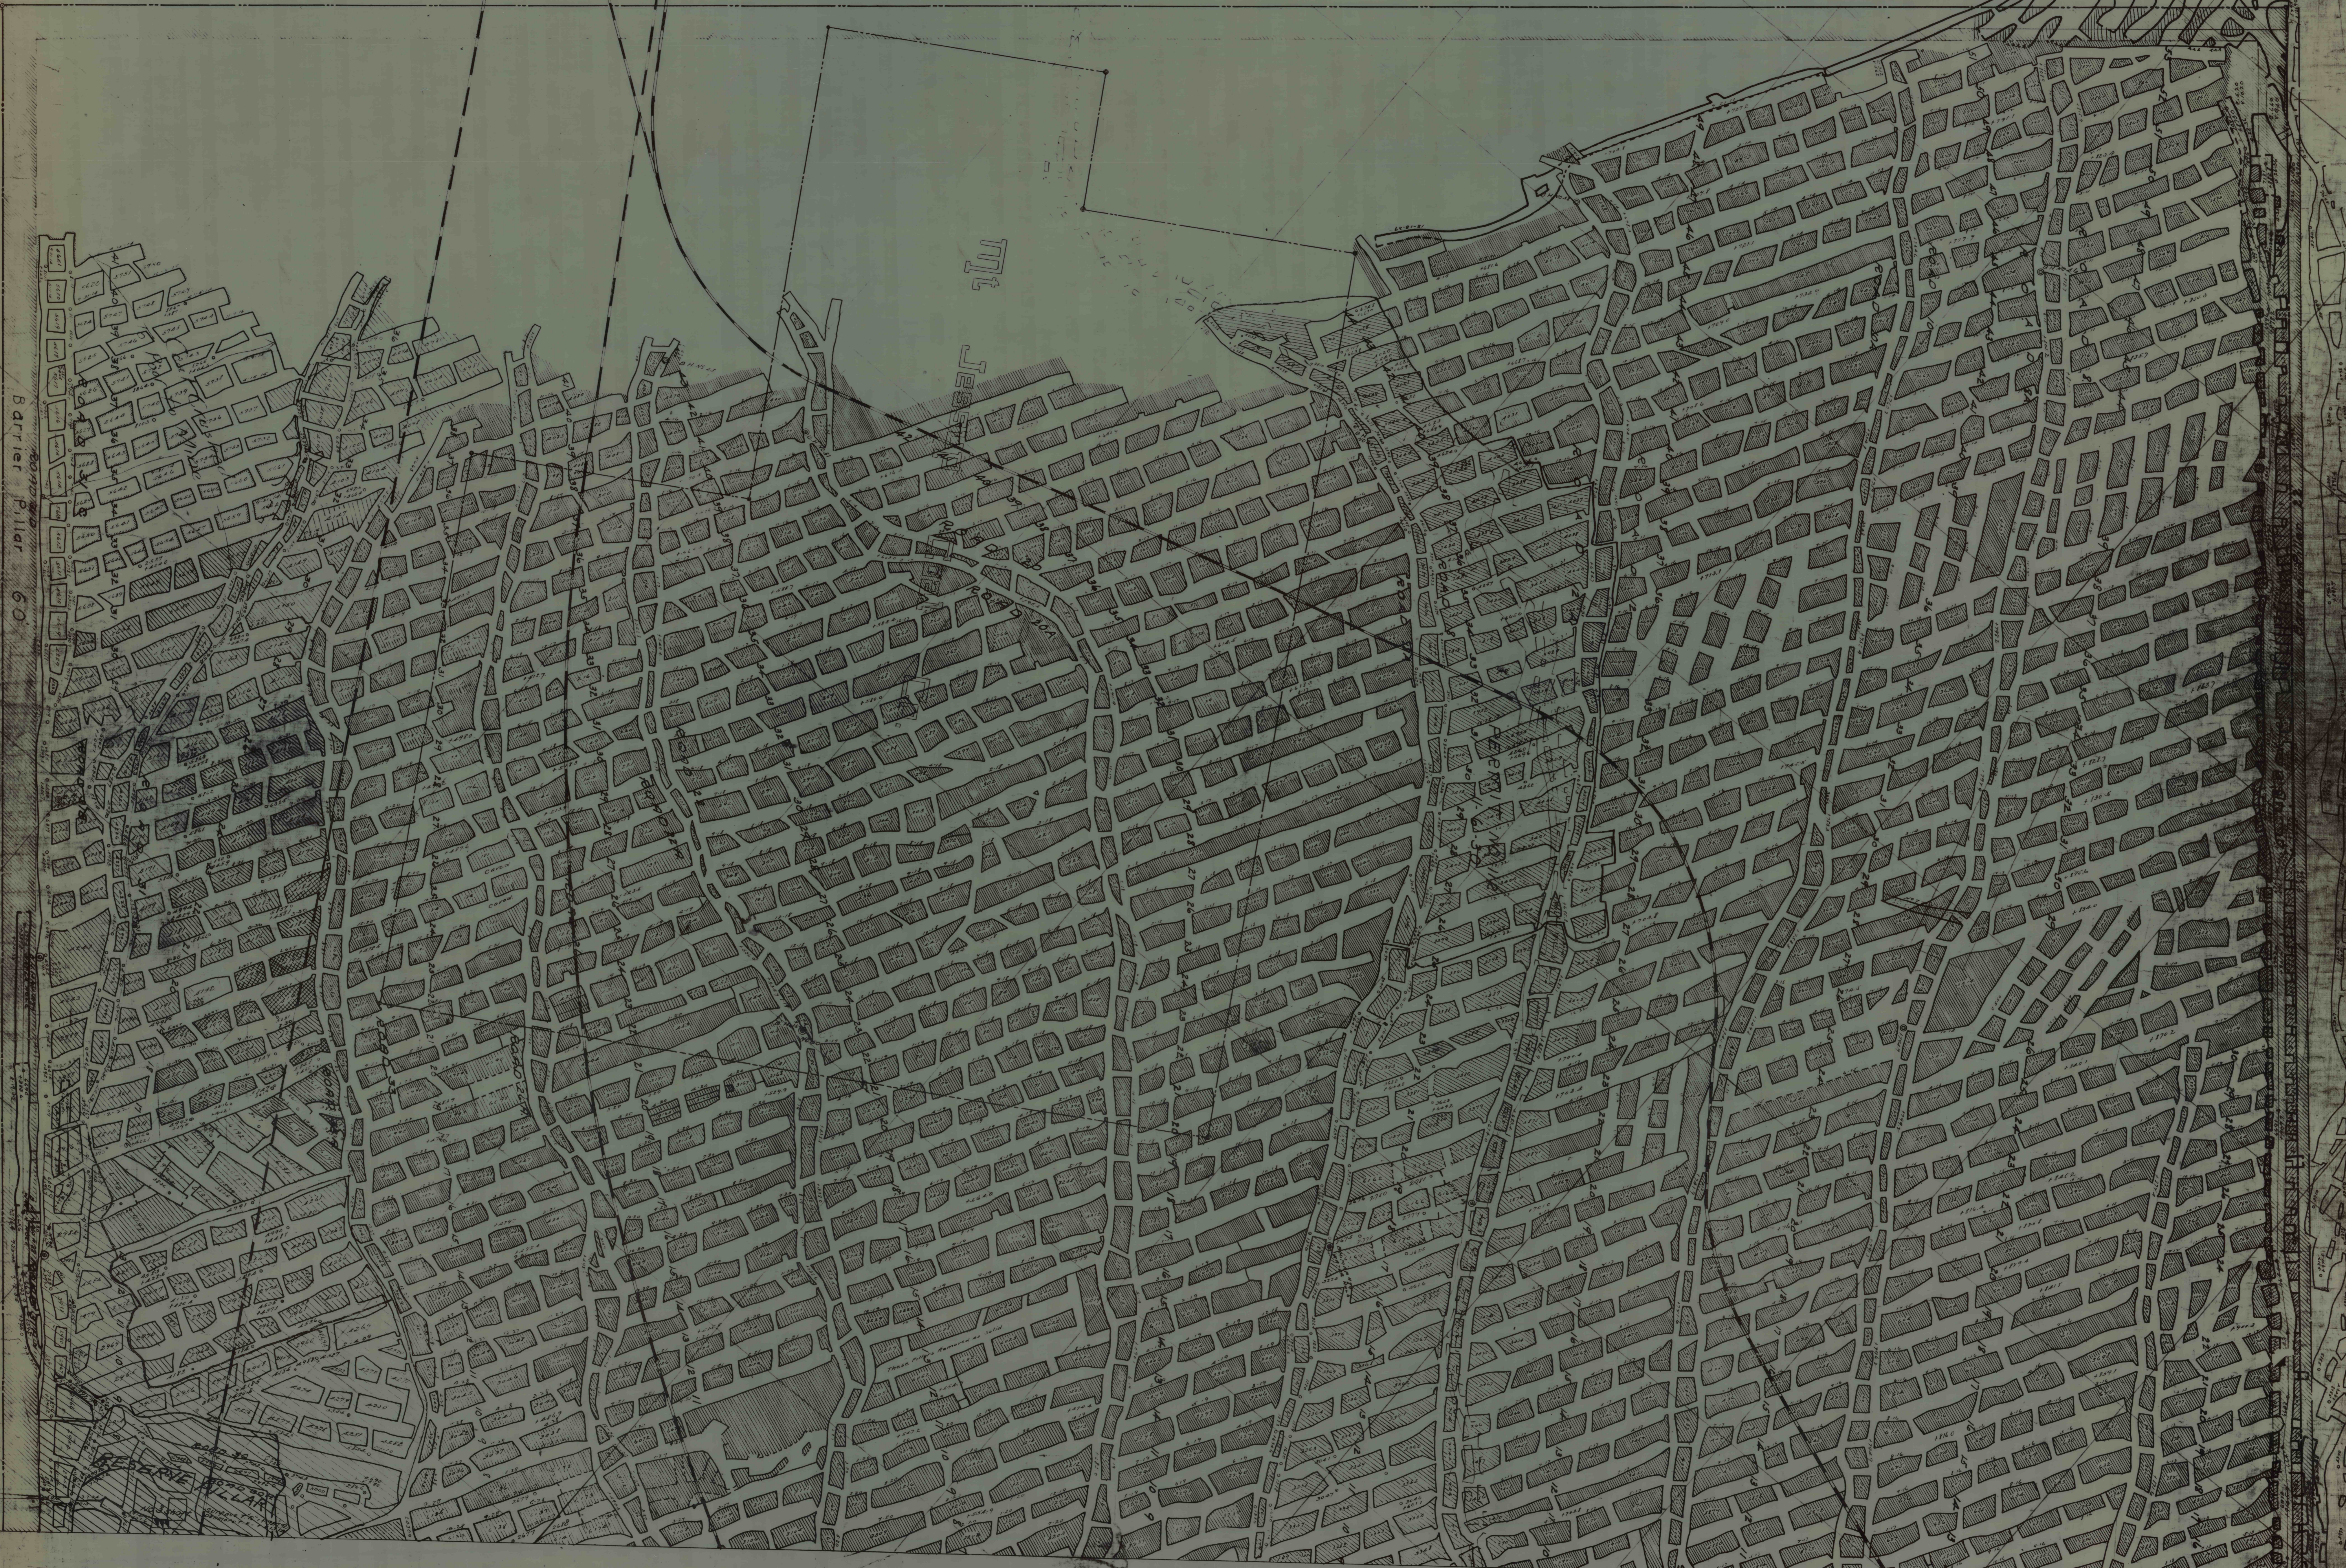

Barrier Piliar 60

JESSIE

ROAD