

COAL BEDS OF THE NORTHERN ANTHRACITE FIELD.

LONGITUDINAL SECTION
OF NORTHERN ANTHRACITE FIELD
FROM FOREST CITY
TO MOCANAQUA

SHOWING VEIN NOMENCLATURE
AVERAGE ELEVATION OF SURFACE
AVERAGE MAXIMUM DEPTH OF BEDS
AVERAGE INTERVAL BETWEEN BEDS
AVERAGE THICKNESS OF BEDS

FOREST CITY

CARBONDALE



JERMYN

PRICEBURG
SCRANTON

PRICEBURG

SCRANTON

PECKVILLE

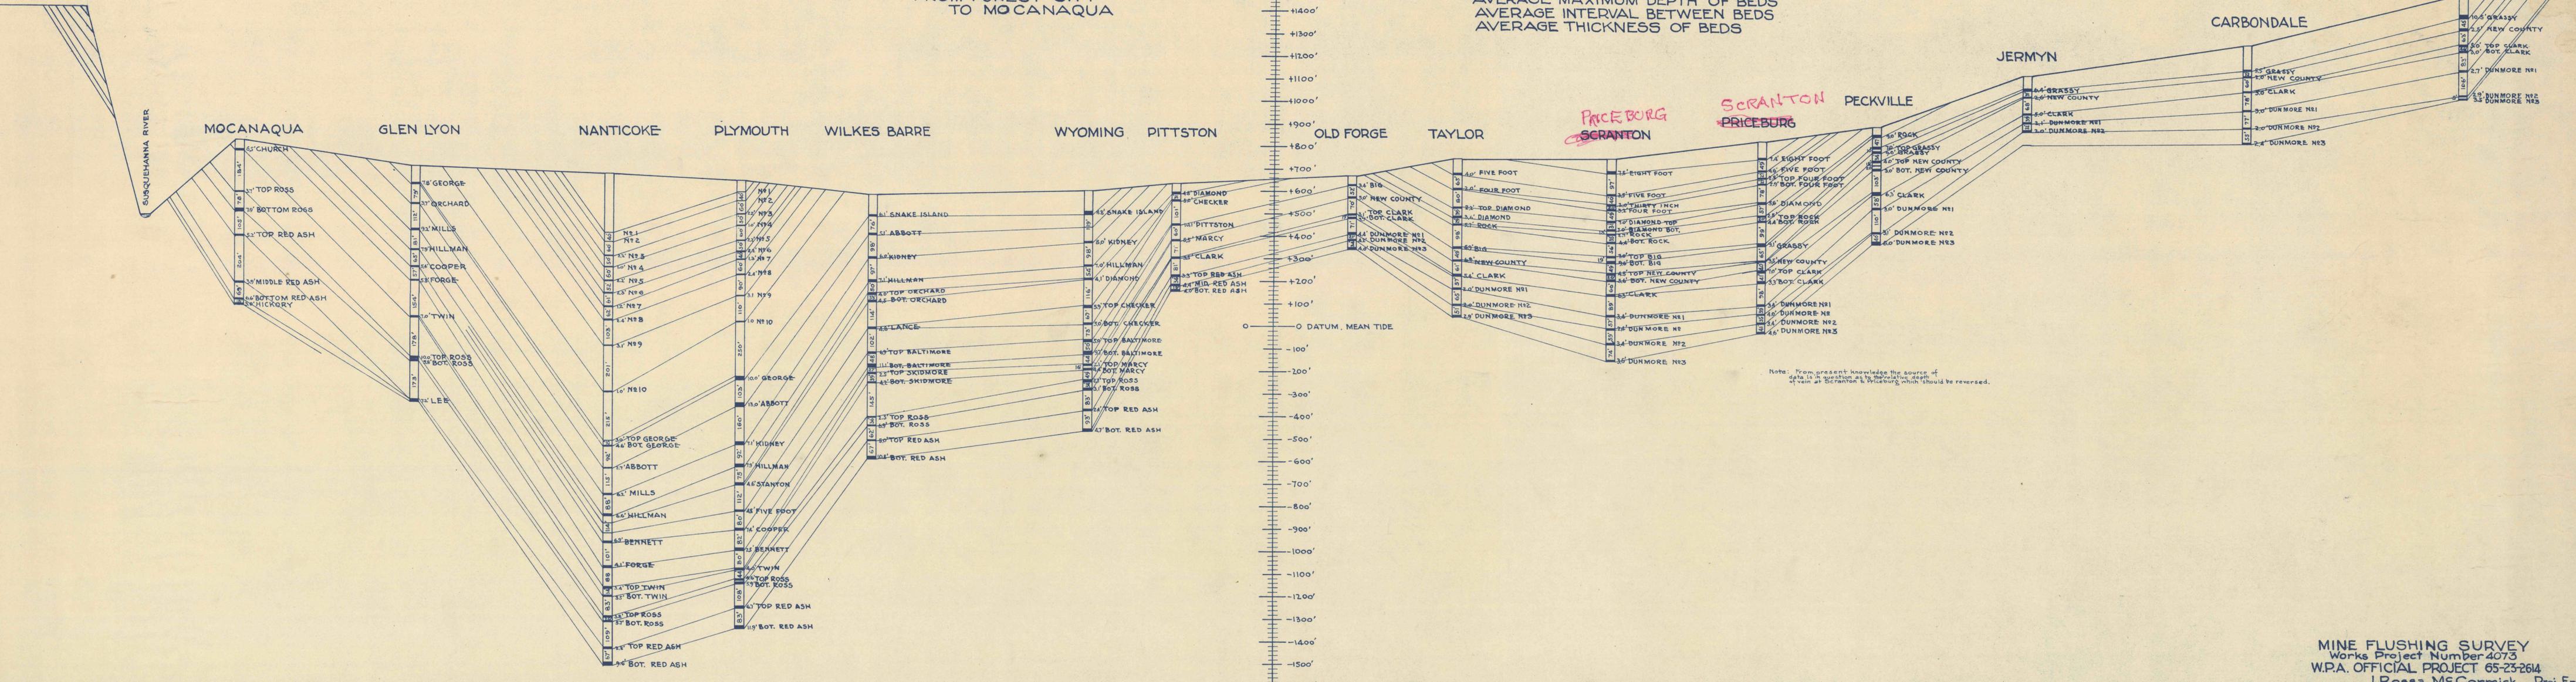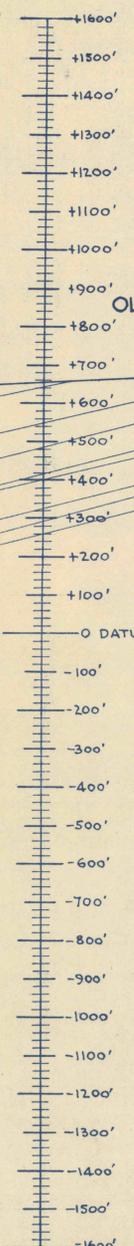

MINE FLUSHING SURVEY
Works Project Number 4073
W.P.A. OFFICIAL PROJECT 65-23-2614
J. Rossa McCormick Proj. Engr.
Aug. 12, '36

SCALE 1" = 20'
FLM.