


CEMETERY



AUSTIN COAL CO.



Permit 5545
11-25-31

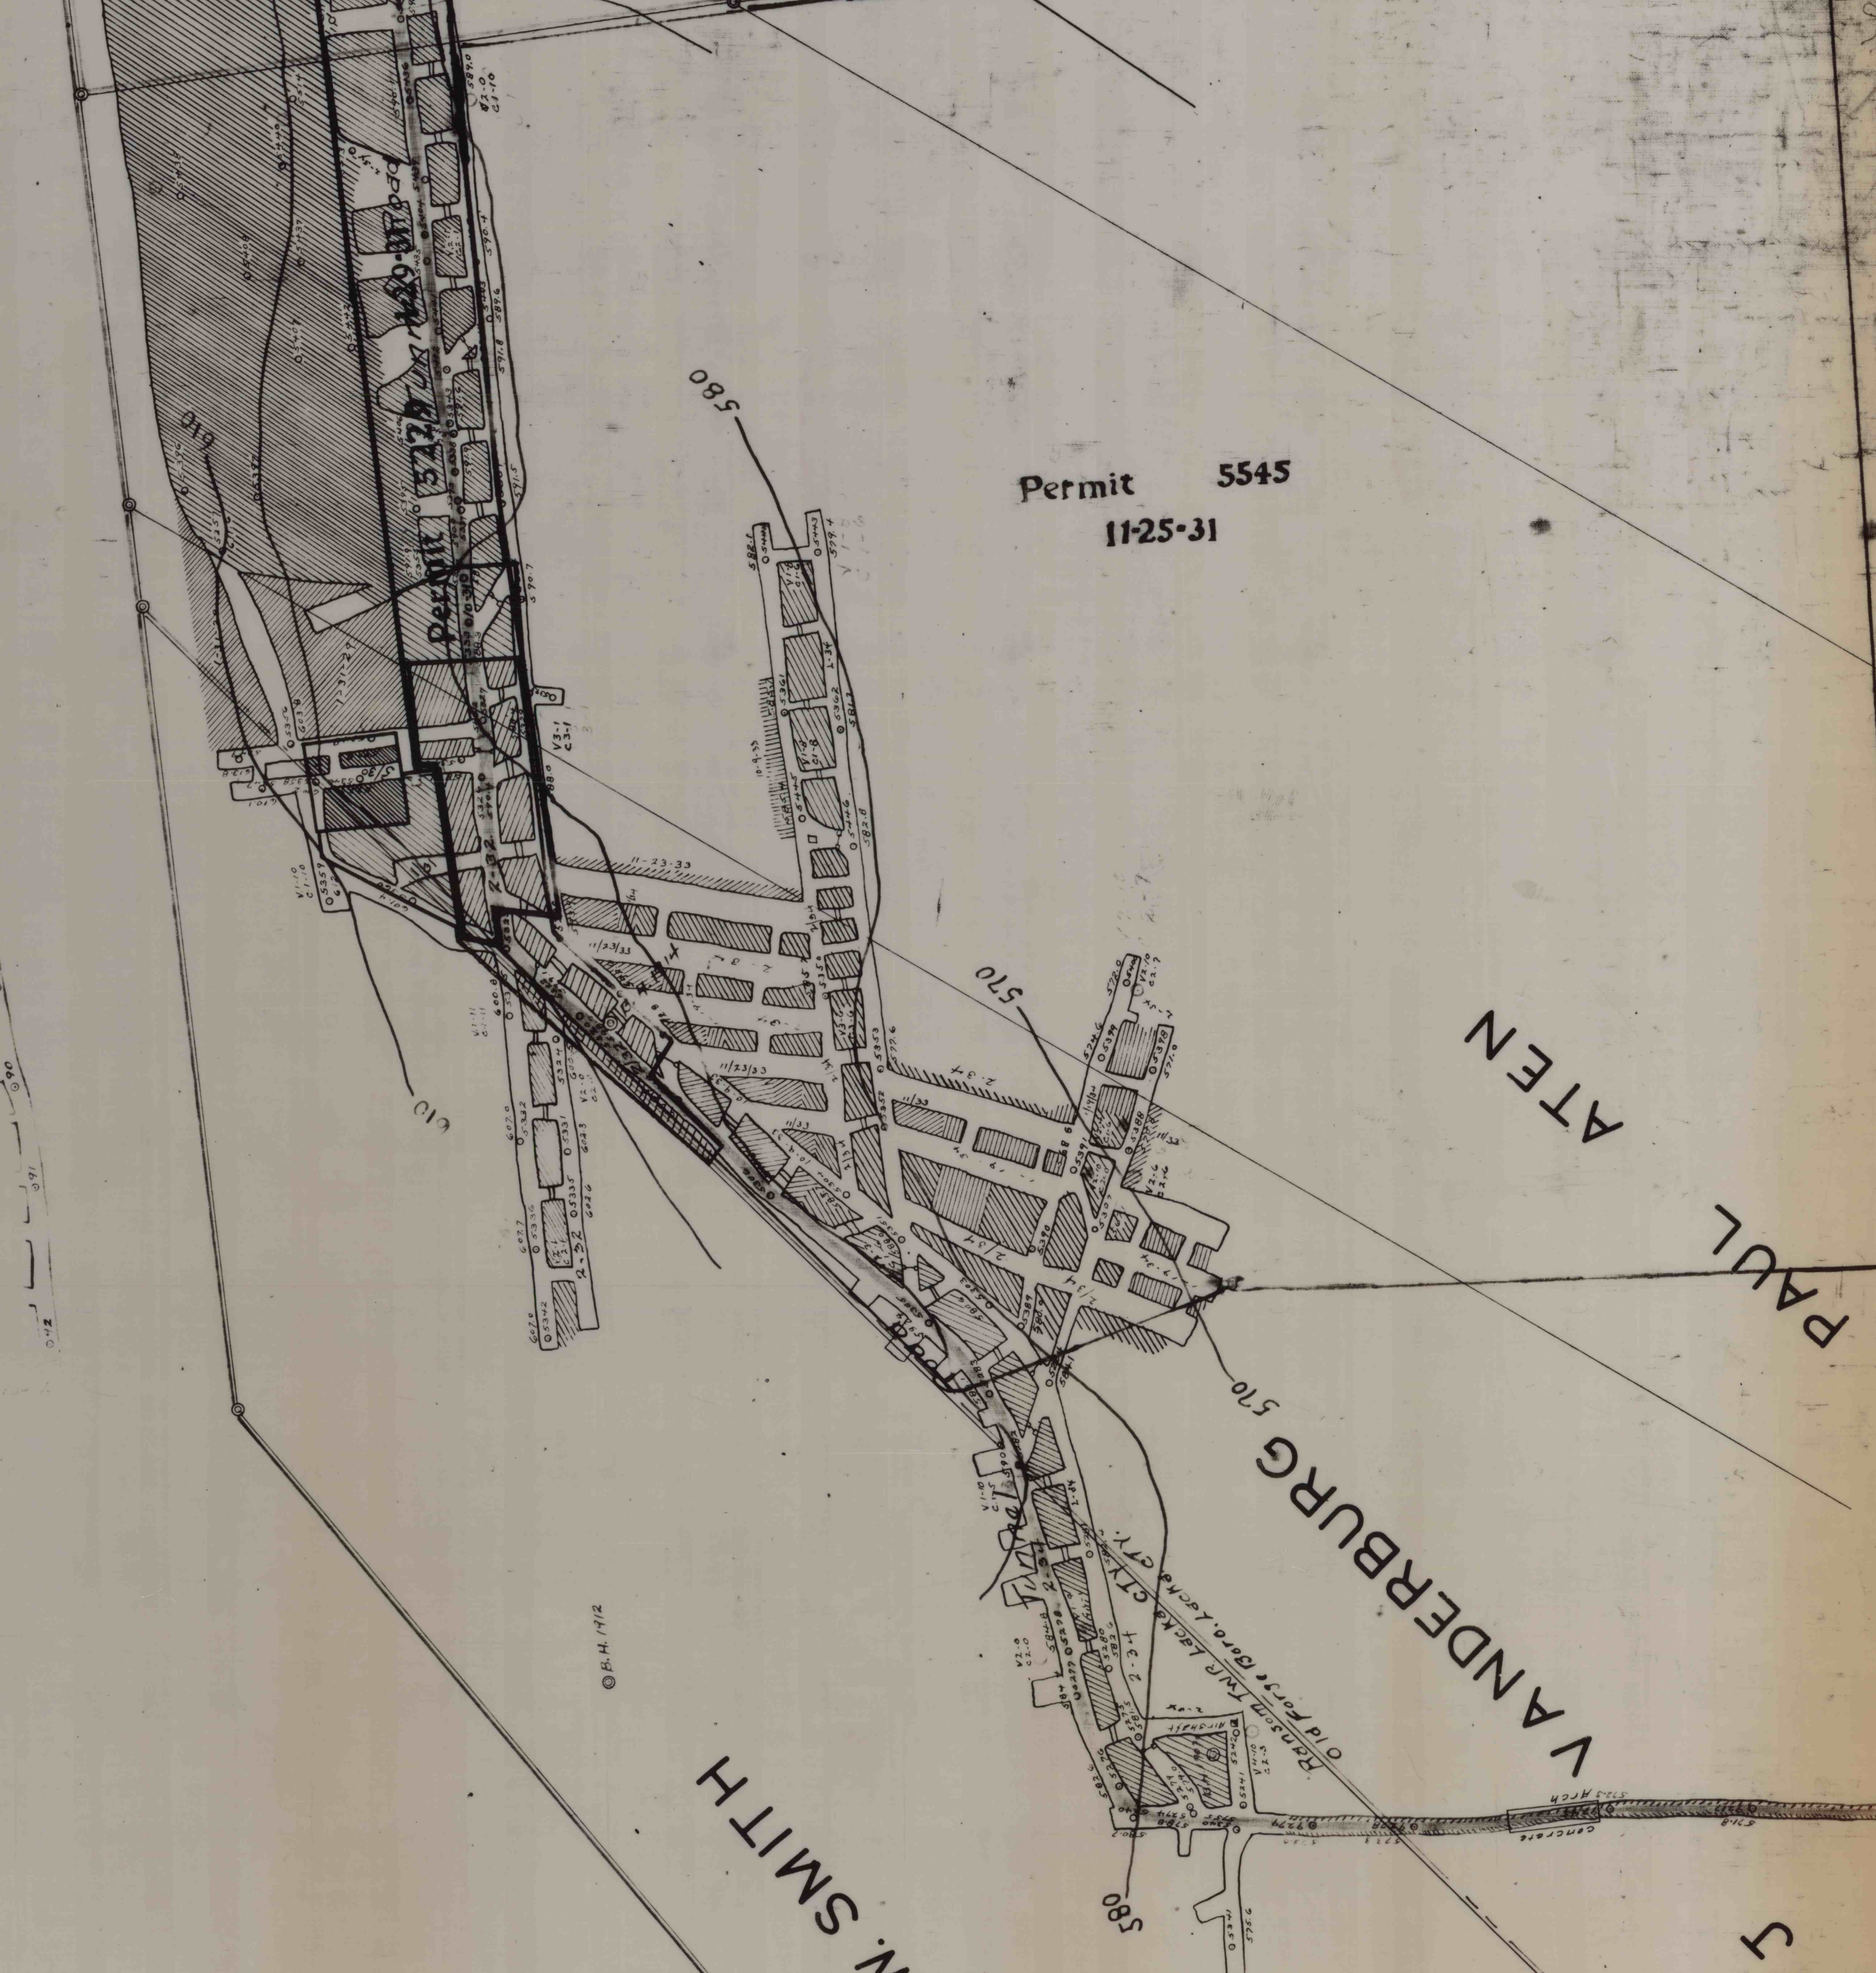

THOMAS & G.W. SMITH

