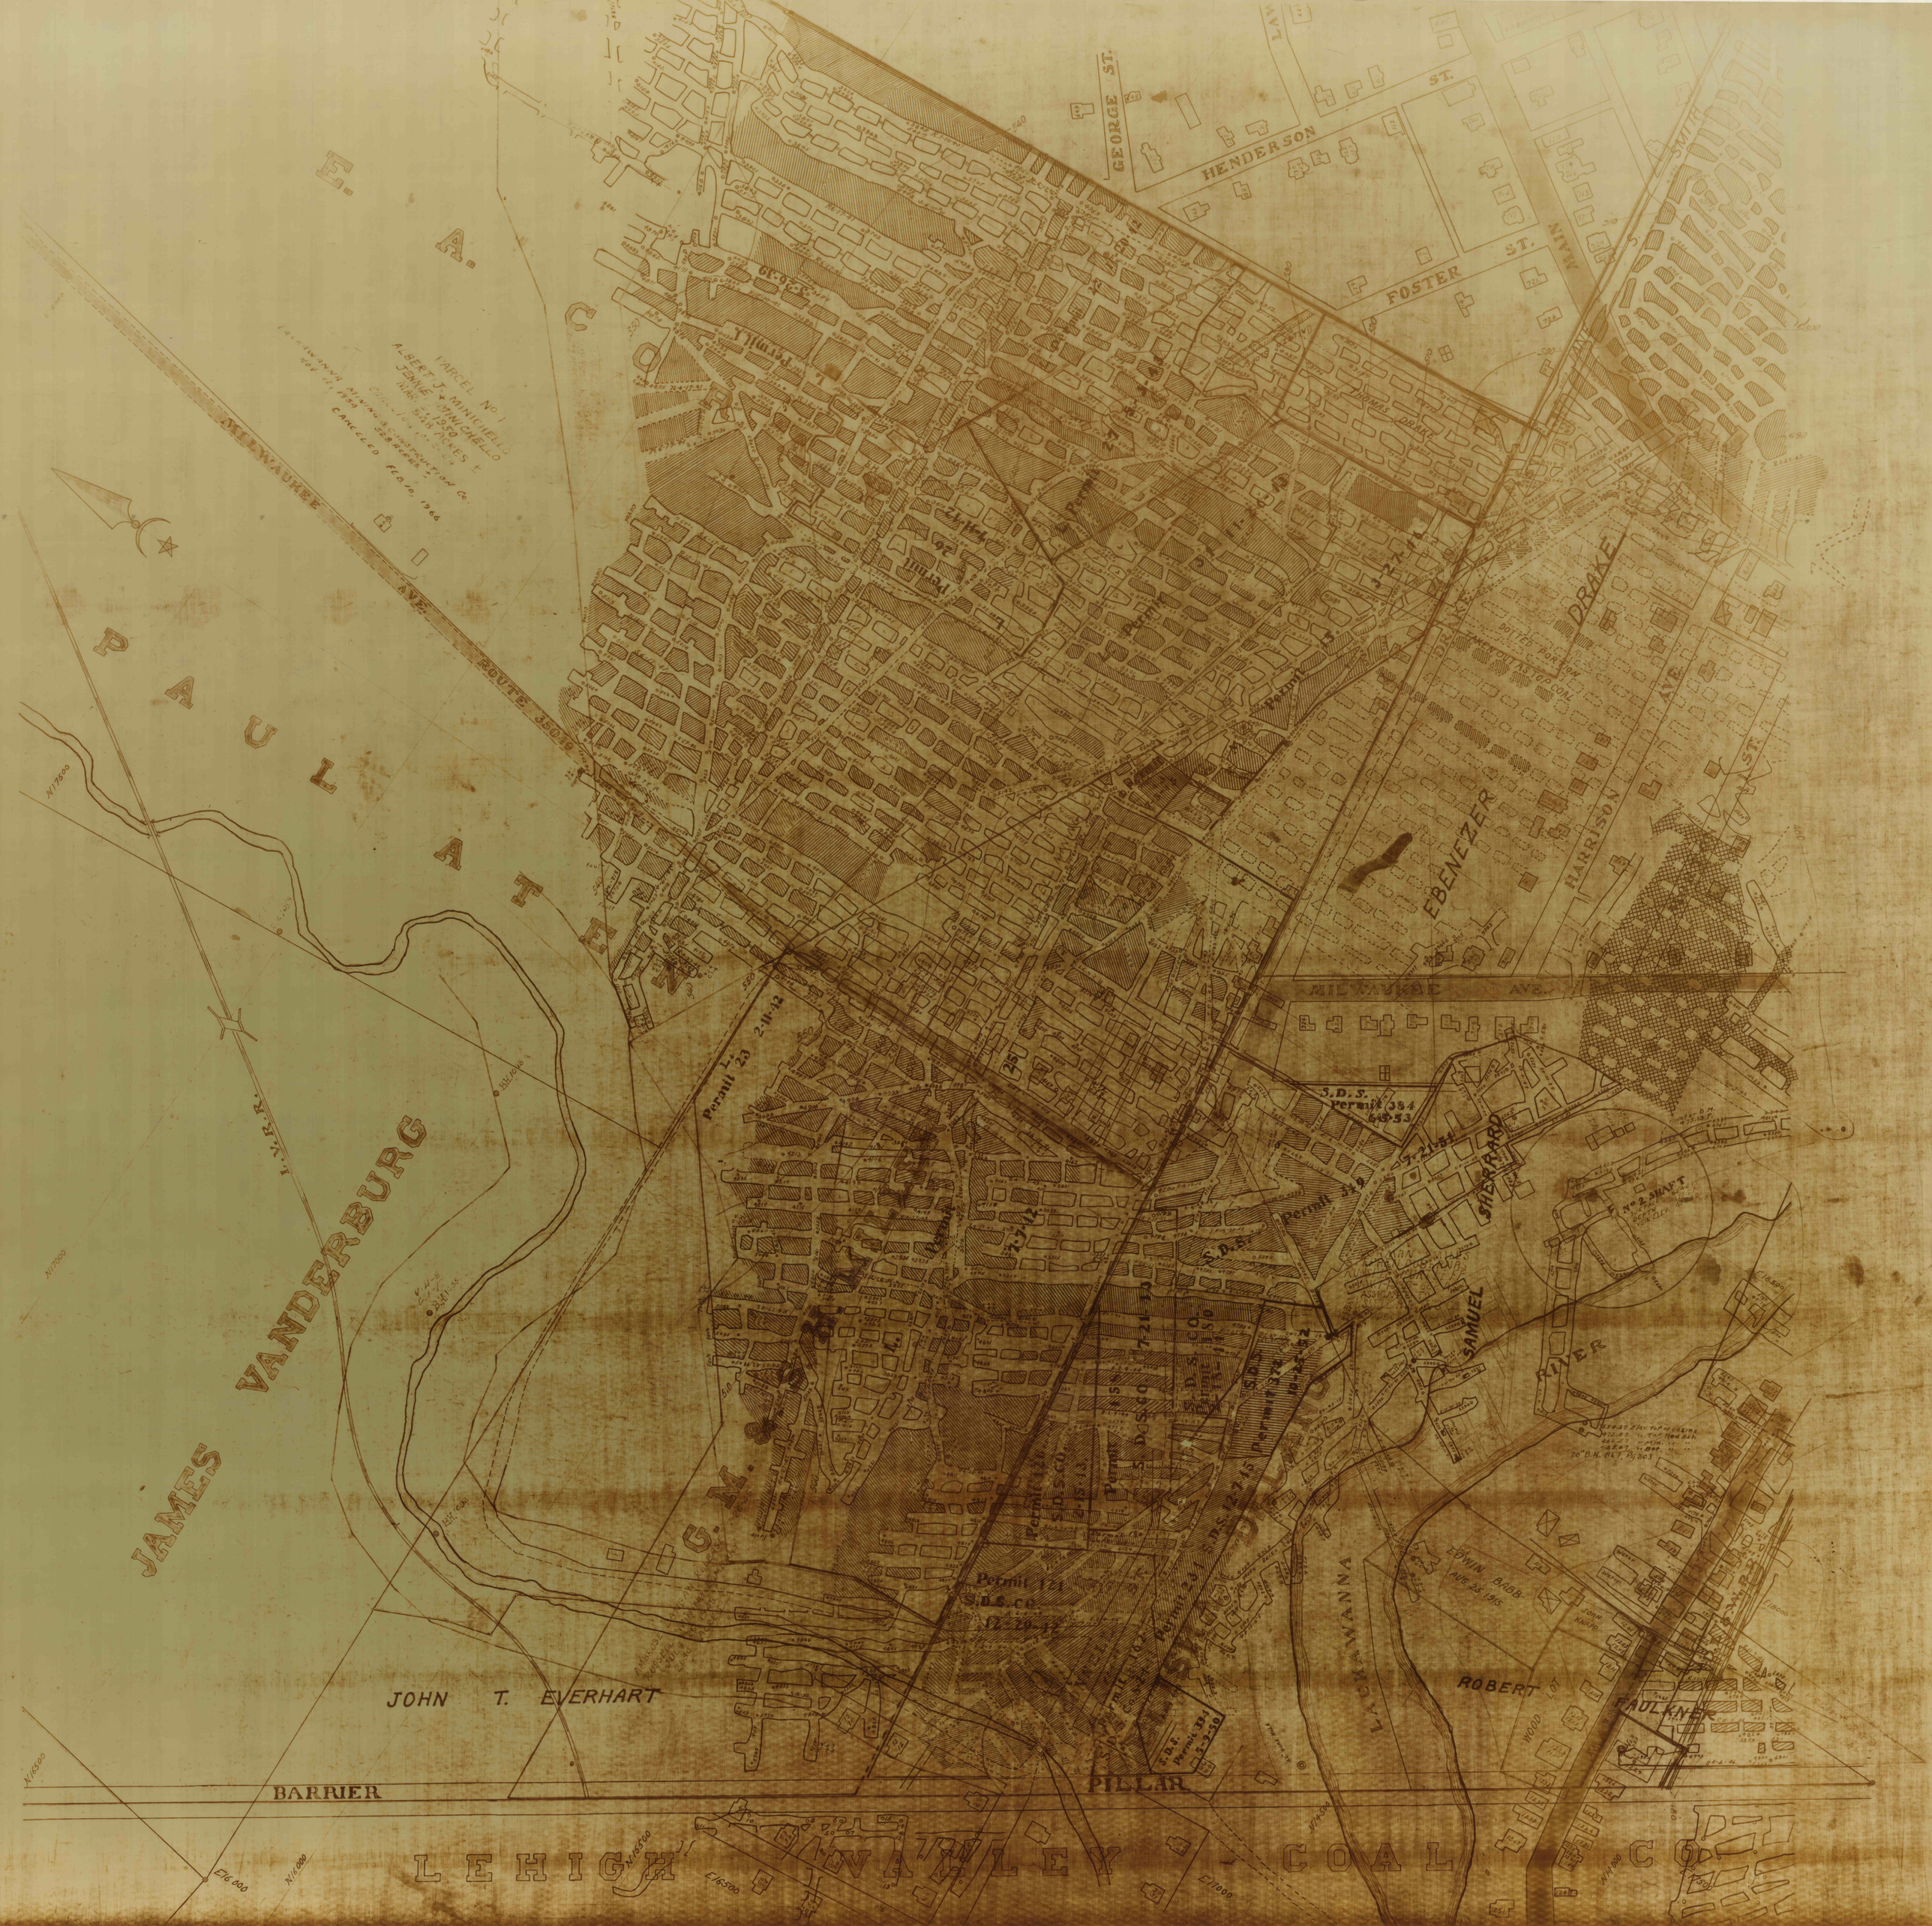
E. A. COLE
PAUL A. TEN
JAMES VANDERBURG
JOHN T. EVERHART
LEHIGH VALLEY COAL CO.
BARRIER
PILLAR
MILWAUKEE AVE.
ROUTE 35019
PARCEL No. 1
ALBERT J. MINICHELLO
JENNIE MINICHELLO
WM. & SAM ACKES
LACKAWANNA MINING & CONSTRUCTION CO.
CANCELLED FEB. 10, 1966
GEORGE ST.
HENDERSON ST.
FOSTER ST.
MAIN AVE.
SMITH
THOMAS DRAKE
DRAKE
DOTTED PORTION MEET OUT AS OLD COAL
EBENEZER
HARRISON AVE.
ST.
SHERRARD
SAMUEL
RIVER
EDWIN BABB
ROBERT
FAULKNER
LACKAWANNA
Permit 23 2-11-42
S.D.S. Permit 384 6-5-53
Permit 121 S.D.S.CO. 12-20-42
Permit 162
Permit 231
S.D.S. Permit 384 5-2-50
Permit 419
7-21-54
7-7-42
No. 2 SHAFT