



THIRD ST
MOR

ROUTE 35061

LACKAWANNA

RIVER

D. A. H. R. R.

N. Y. S. W. R. R.

NO SHAFT

WILL



NOW P.C.C.O.

NOW P.C.C.O.

Permit 5221-1-16-31

Permit 11-11-12
S. D. S. 200

Permit 265

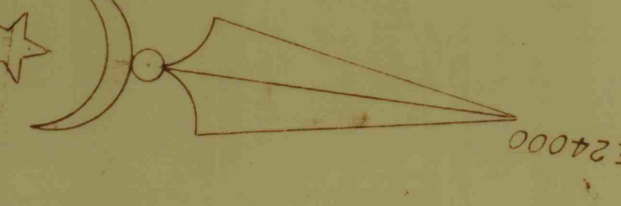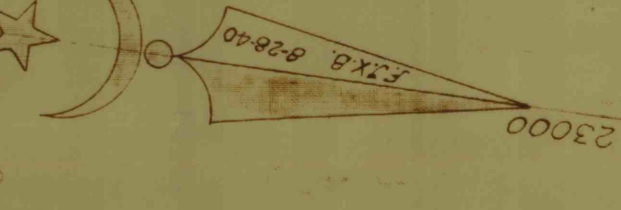

15200
