

THE D. & H. CO.  
PRICILLA JOHNSON TRACT

LEHIGH VALLEY COAL CO.

GLEN ALDEN COAL CO.


THE D & H CO

NO. 3 SHAFT

NO. 4 SHAFT

NO. 3 SHAFT

THE DELAWARE & HUDSON CO.

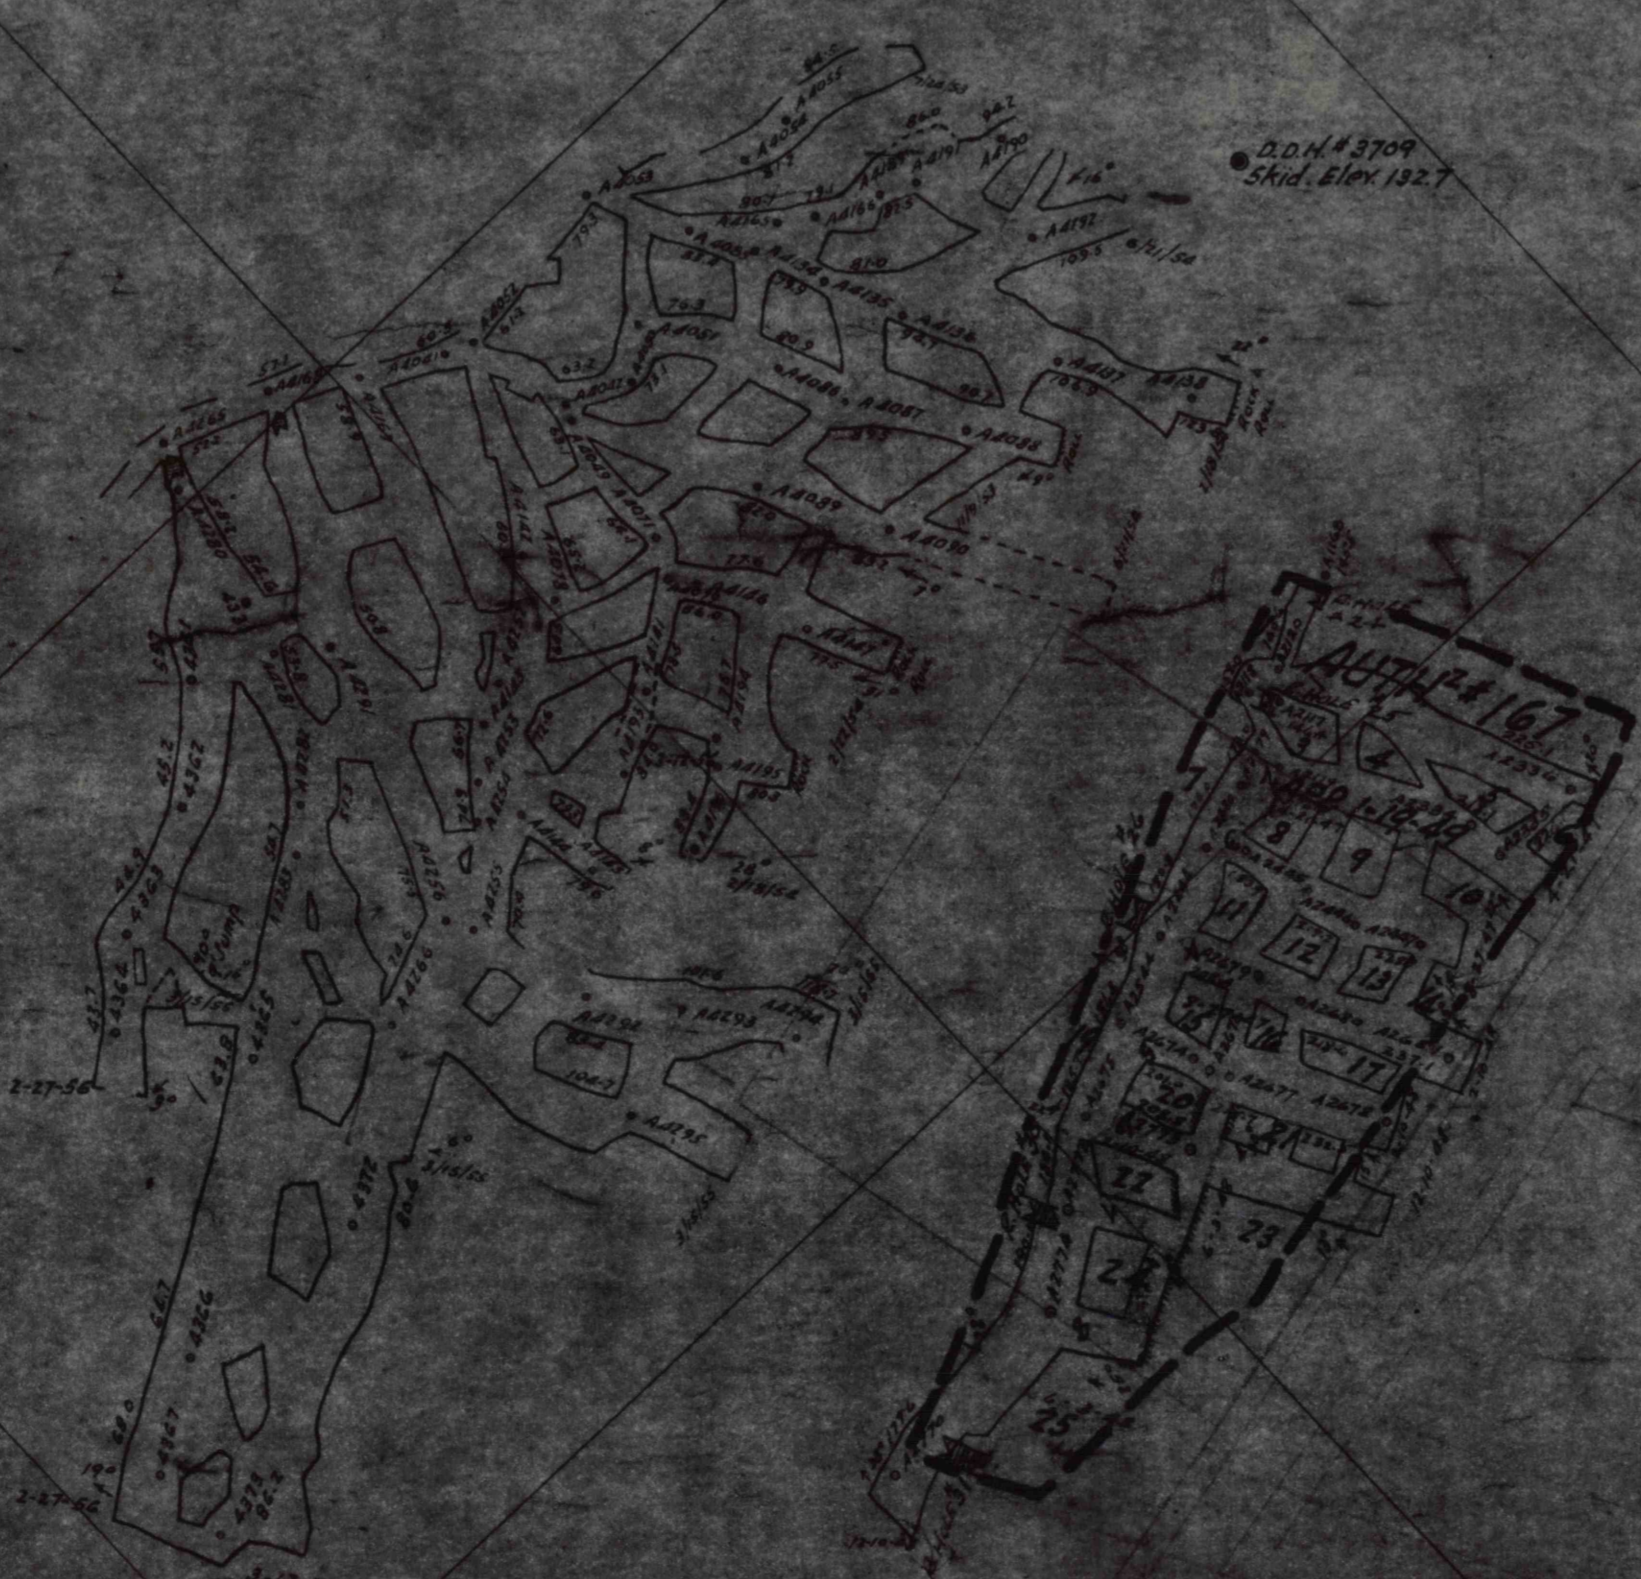

THE DEL. & HUD. CO.

DENNIS MACKIN