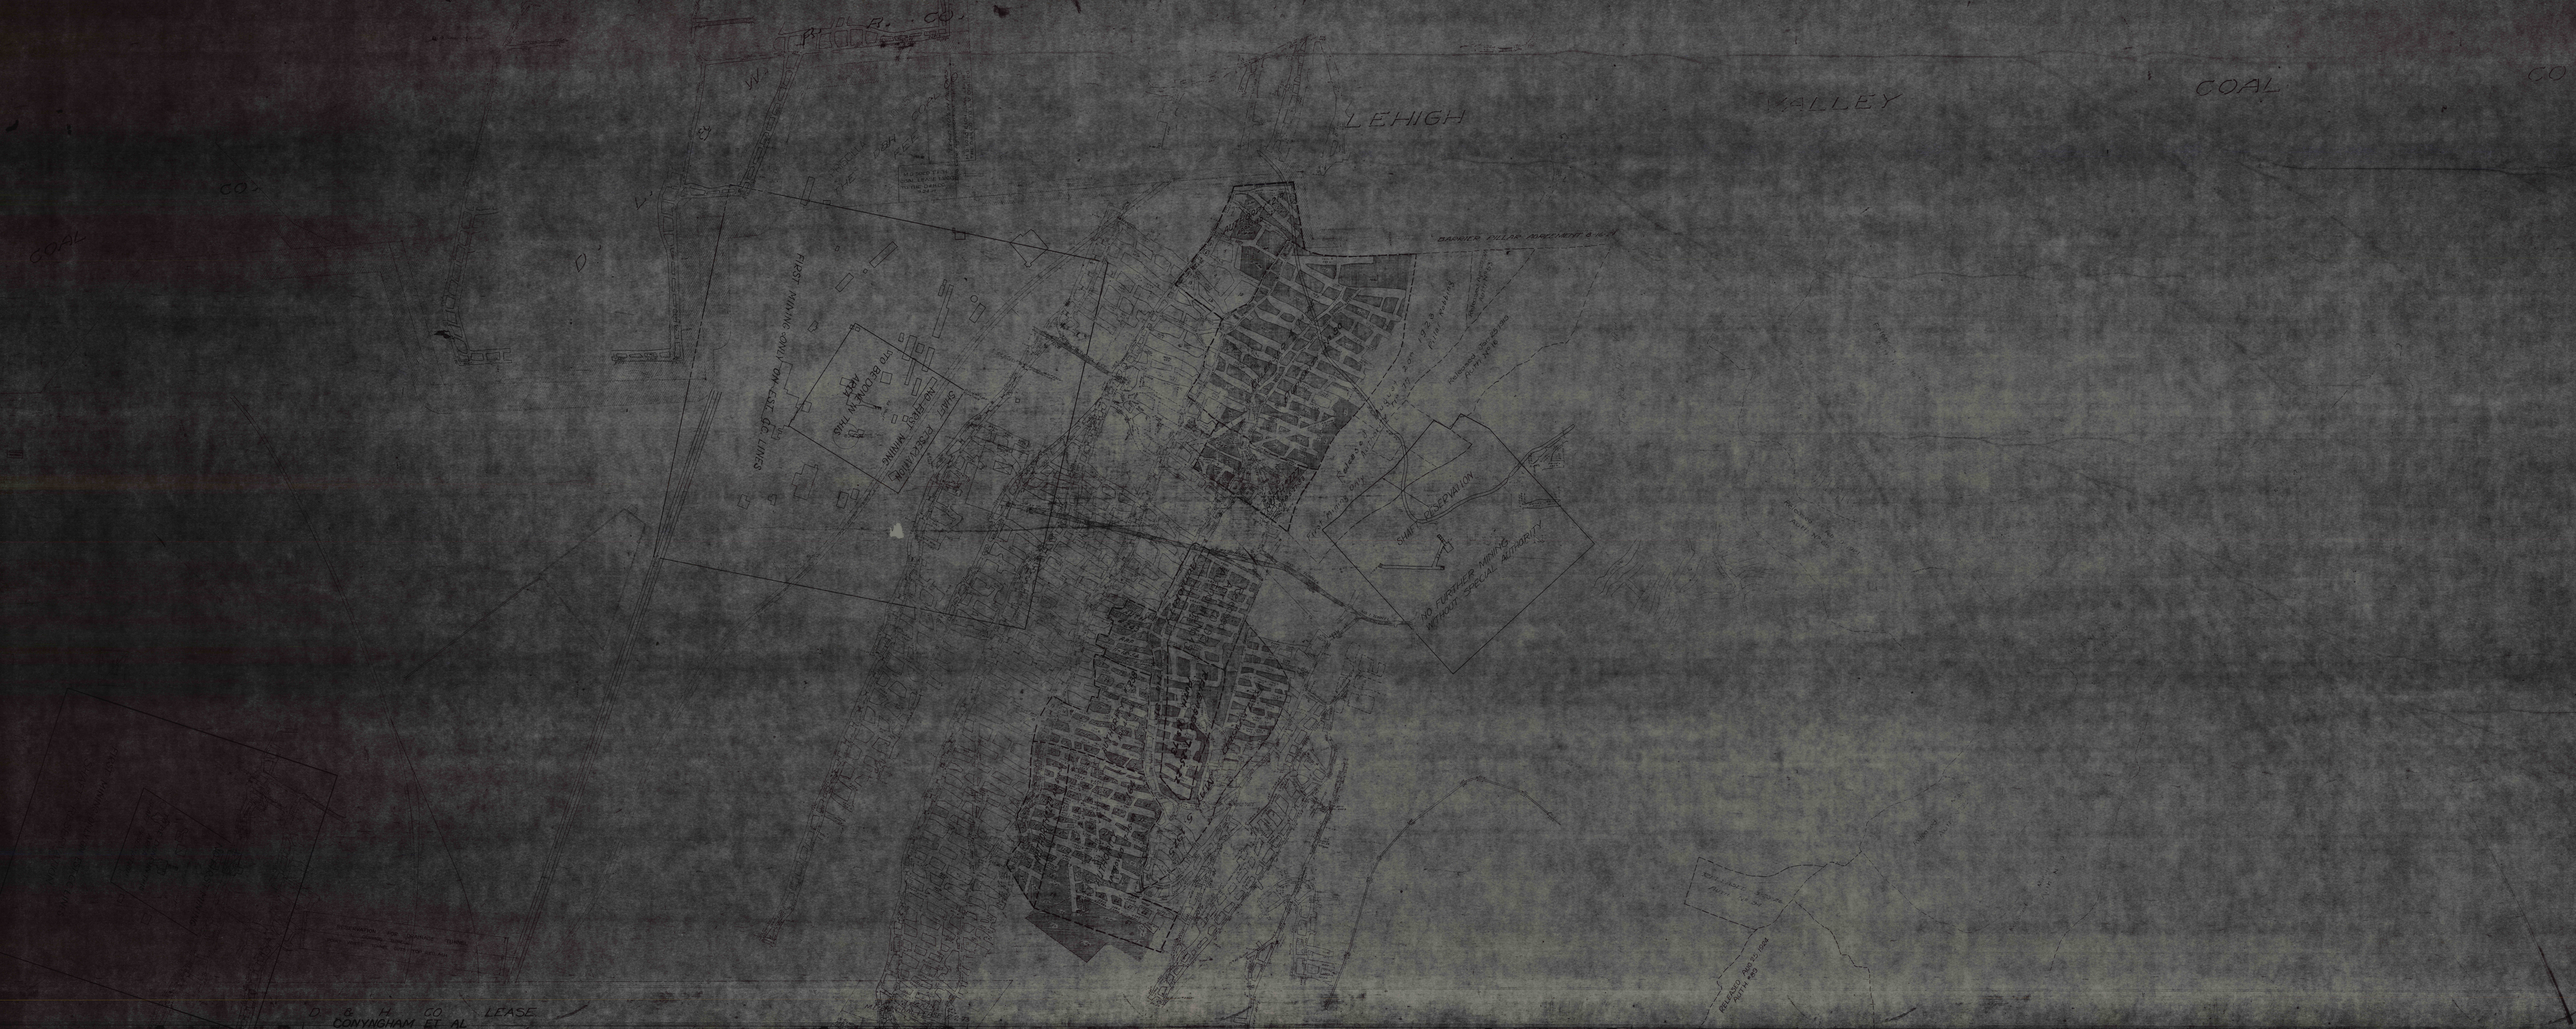
LEHIGH
VALLEY
COAL
CO
COAL
CO
FIRST MINING ONLY ON EST. G.C. LINES
SHAFT RESERVATION
NO FURTHER MINING WITHOUT SPECIAL AUTHORITY
D & H CO. LEASE
CONYNGHAM ET AL