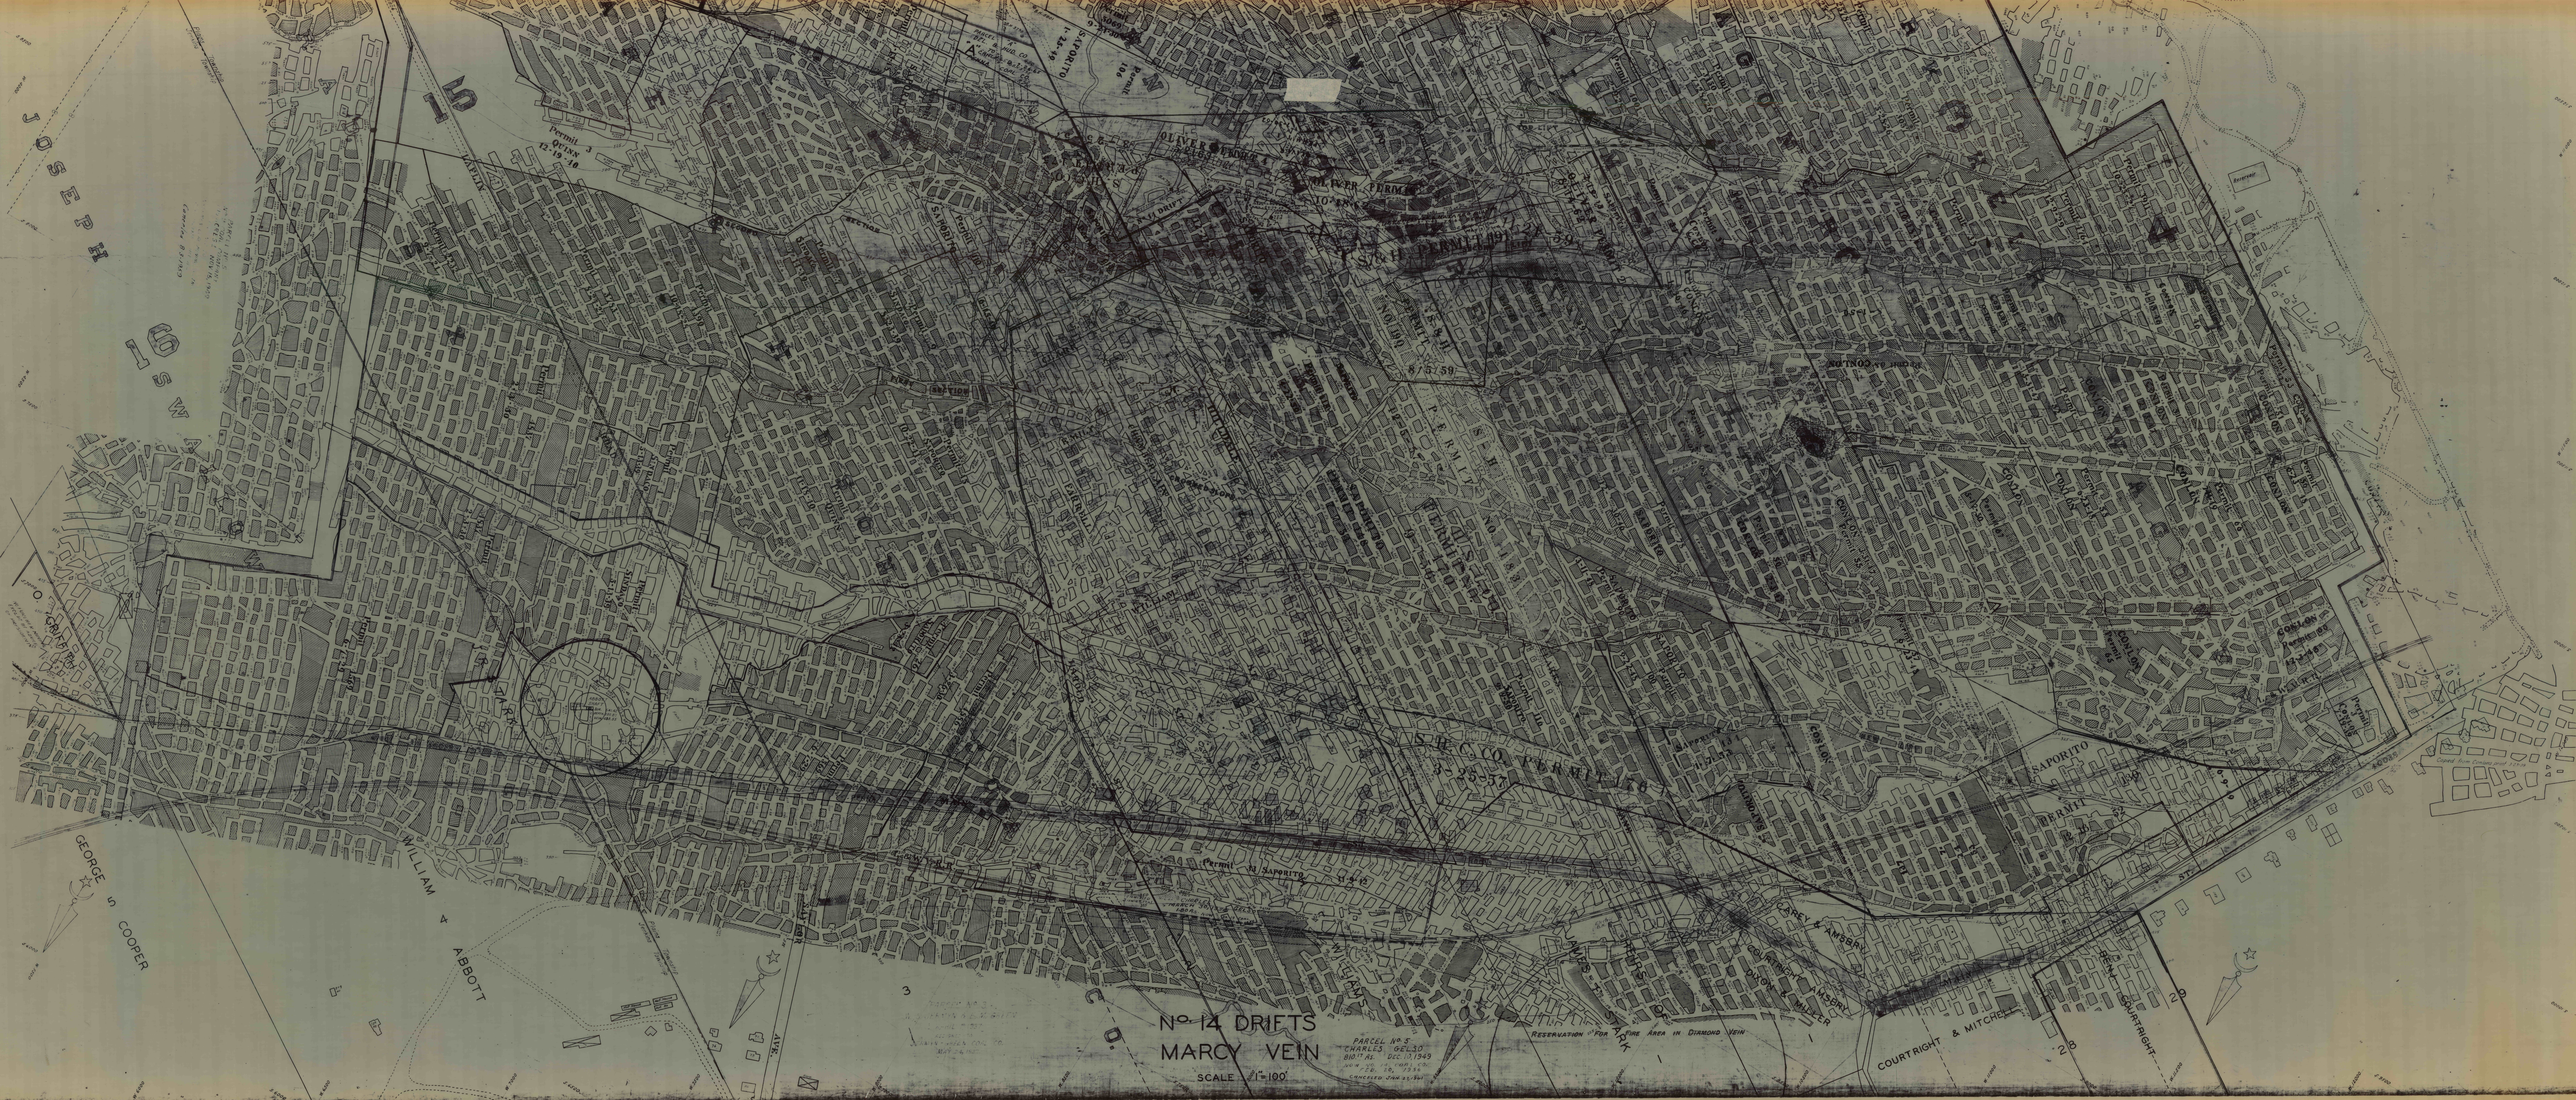

No 14 DRIFTS
MARCY VEIN
SCALE 1"=100'
JOSEPH
15
16 SW
WILLIAM 4 ABBOTT
GEORGE S COOPER
SAPORITO
COURTRIGHT & MITCHELL
COURTRIGHT
CAREY & AMSBRY
RESERVATION FOR FIRE AREA IN DIAMOND VEIN
PARCEL No 5
CHARLES 1941-30
BIOTT AS DEC 17 1949