
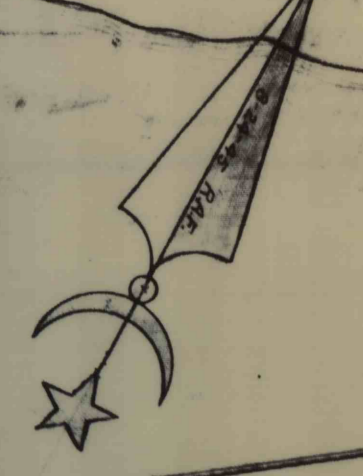
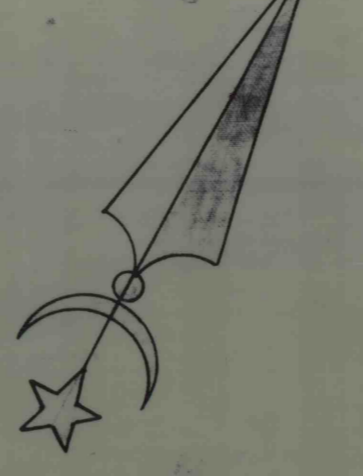


N^o 14 COLLIERY
N^o 14 SHAFT
TOP CHECKER VEIN
SCALE 1"=100'

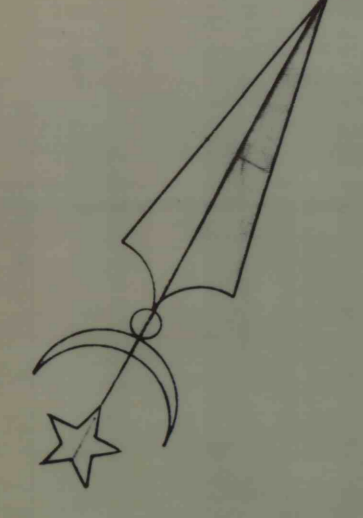

VALLEY

GOAL

CO.

SQUEEZE SERVICE

SARAH DOCK

RICE

COVERS

ISLAND

COAL

NO. 2

MINING

BURR

PILAR

CO.

BARRIER

PILAR