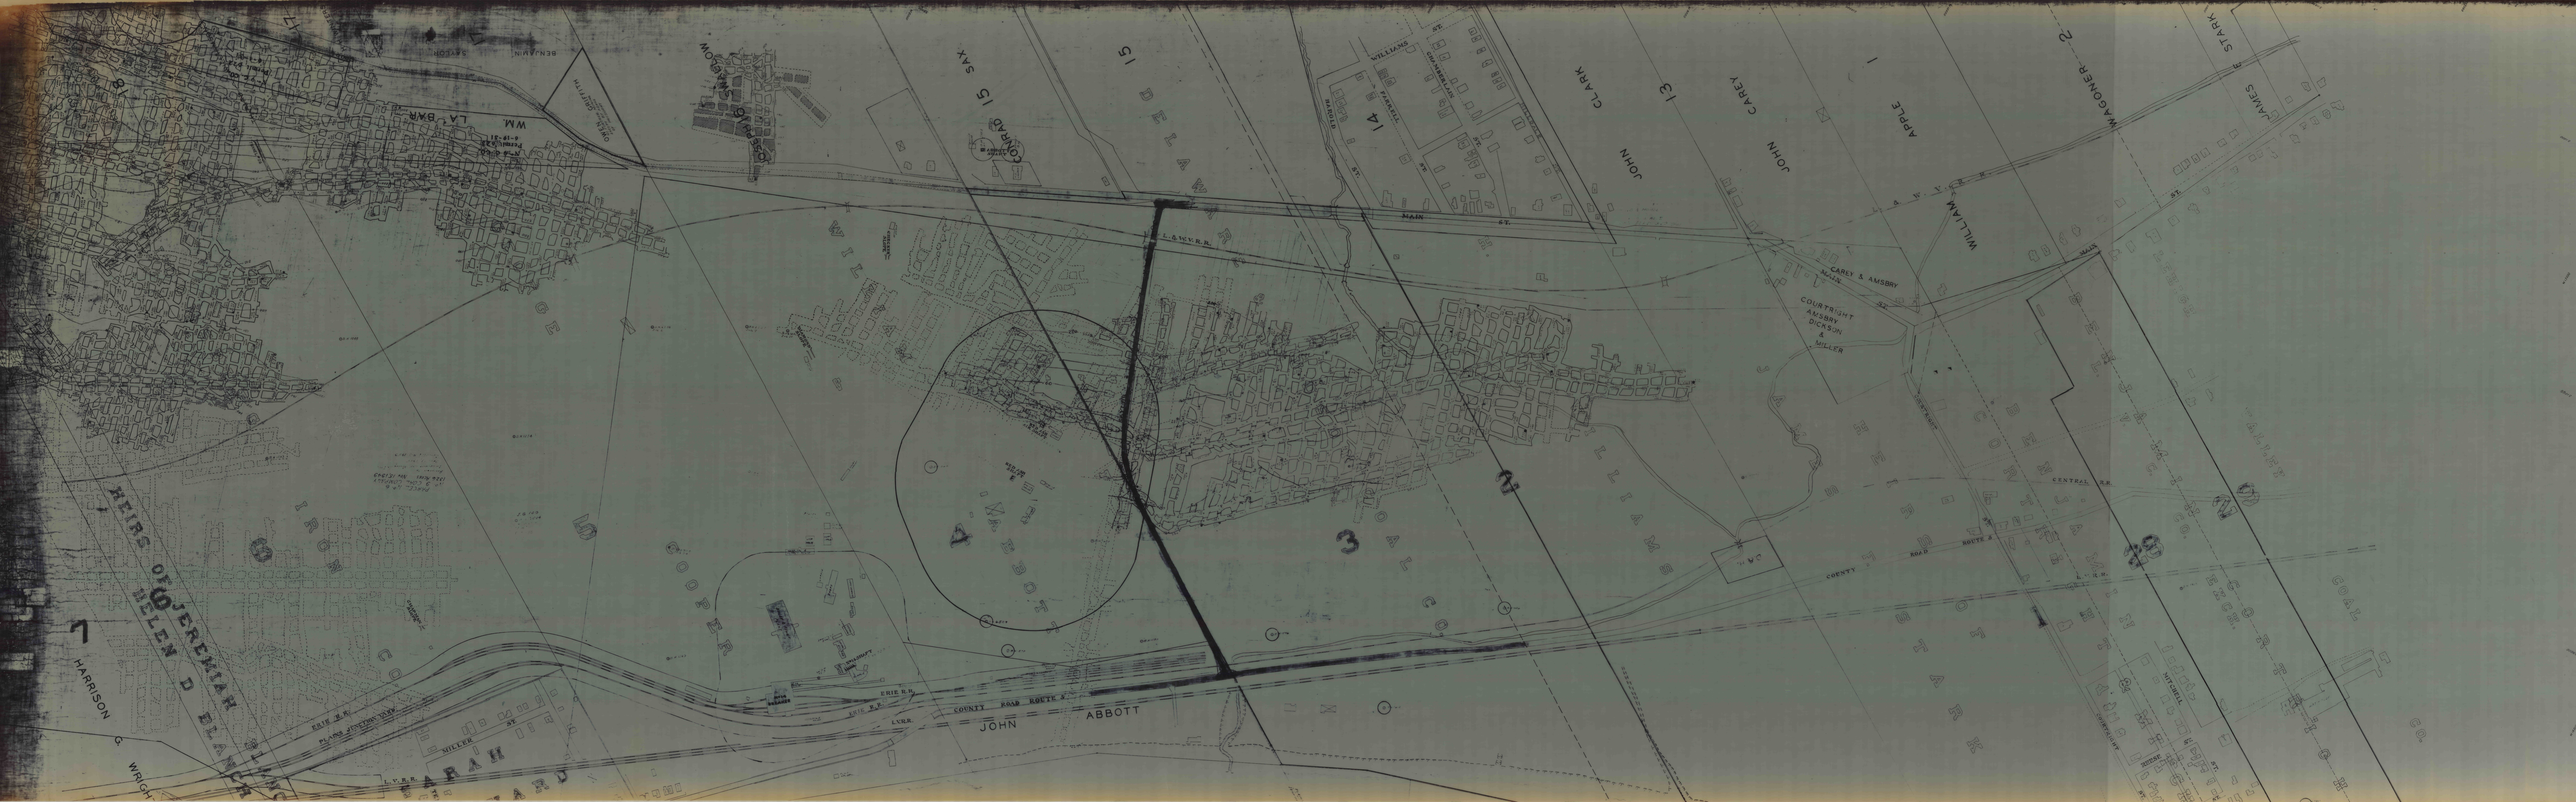

WM. LA BAR
CONRAD SAX
15
14
13
JOHN CLARK
JOHN CAREY
APPLE
WILLIAM
WAGONER
JAMES STARK
CAREY & AMSBRY
COURTRIGHT AMSBRY DICKSON & MILLER
MAIN ST.
L.&W.V.R.R.
WILLIAMS
COAL CO.
IRON
COOPER
HEIRS OF JEREMIAH
HELEN D BLANCH
HARRISON G. WRIGHT
JOHN ABBOTT
COUNTY ROAD ROUTE 5
ERIE R.R.
L.V.R.R.
MILLER ST.
CENTRAL R.R.
COUNTY ROAD ROUTE 5